

# CERTIFICATE OF SURVEY

JAMES F. SIMONET


STILLWATER, MINNESOTA

Minnesota Registered Land Surveyor No. 705  
Wisconsin Registered Land Surveyor No. S-601

W 1/4 Cor.  
Sec. 22

E 1/4 line Sec. 22

*This fence line  
check out OK.*

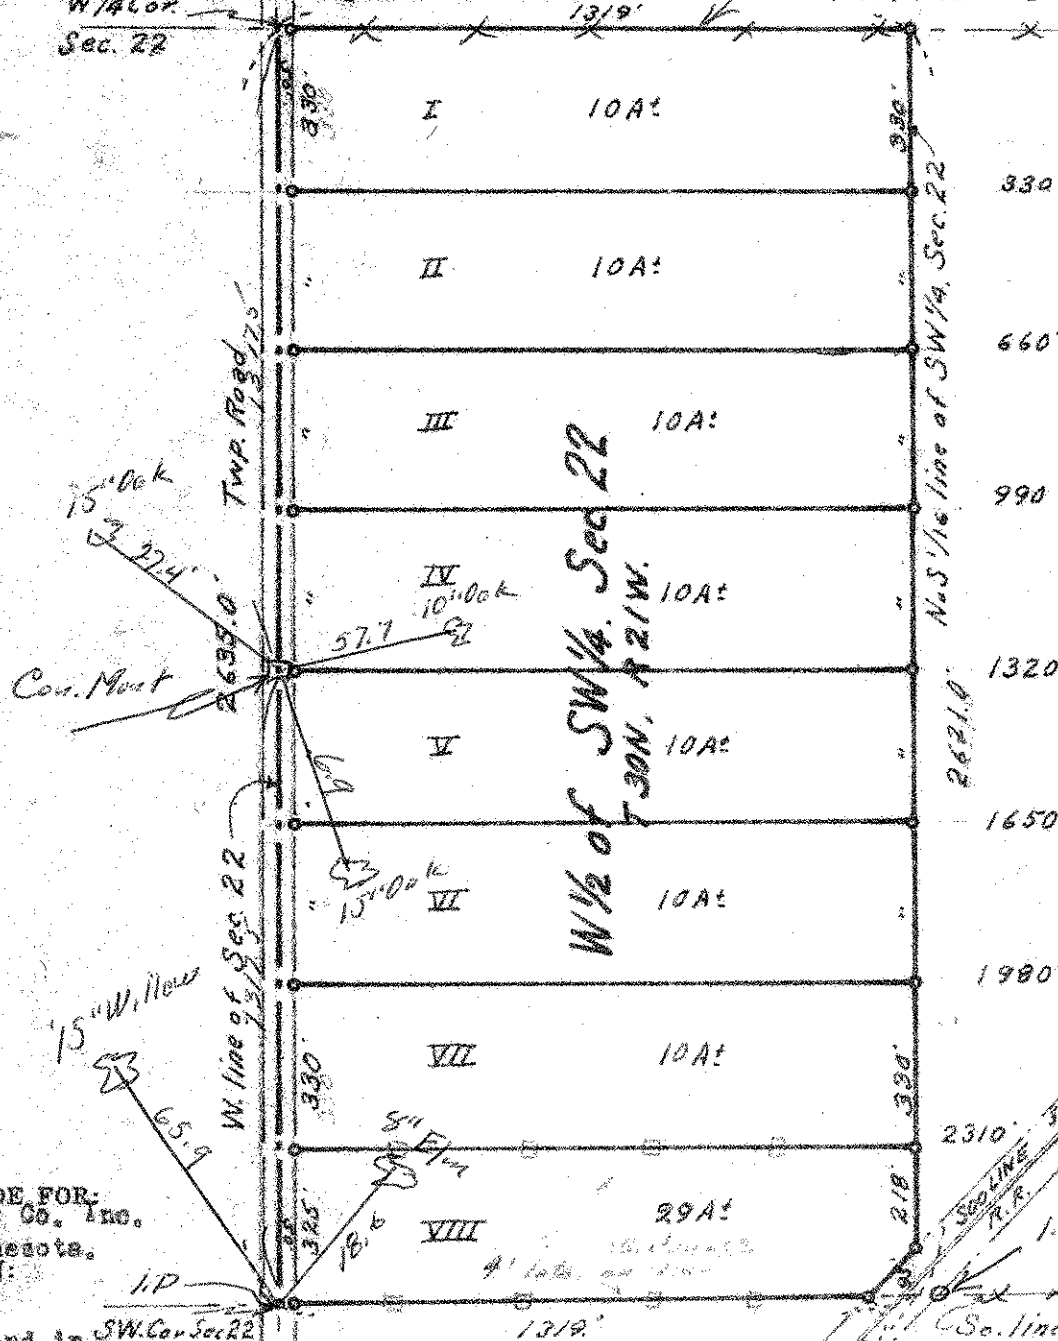

SURVEY MADE FOR:  
Currell Realty Co., Inc.  
St. Paul, Minnesota.  
DESCRIPTION:

8 tracts of land in  
W 1/2 of SW 1/4 of Sec. 22,  
T30N, R21W, Grant Twp.,  
Washington Co., Minn.

I hereby certify that I surveyed the property described  
above and that the above is true and correct plat of  
said survey.

Date 20 June 1951

Scale: 1 inch 400 feet.  
● Indicates Irons.

Surveyor

*Recd. 15 June 52*