


CERTIFICATE OF SURVEY

JAMES F. SIMONET

Minnesota Registered Land Surveyor No. 705

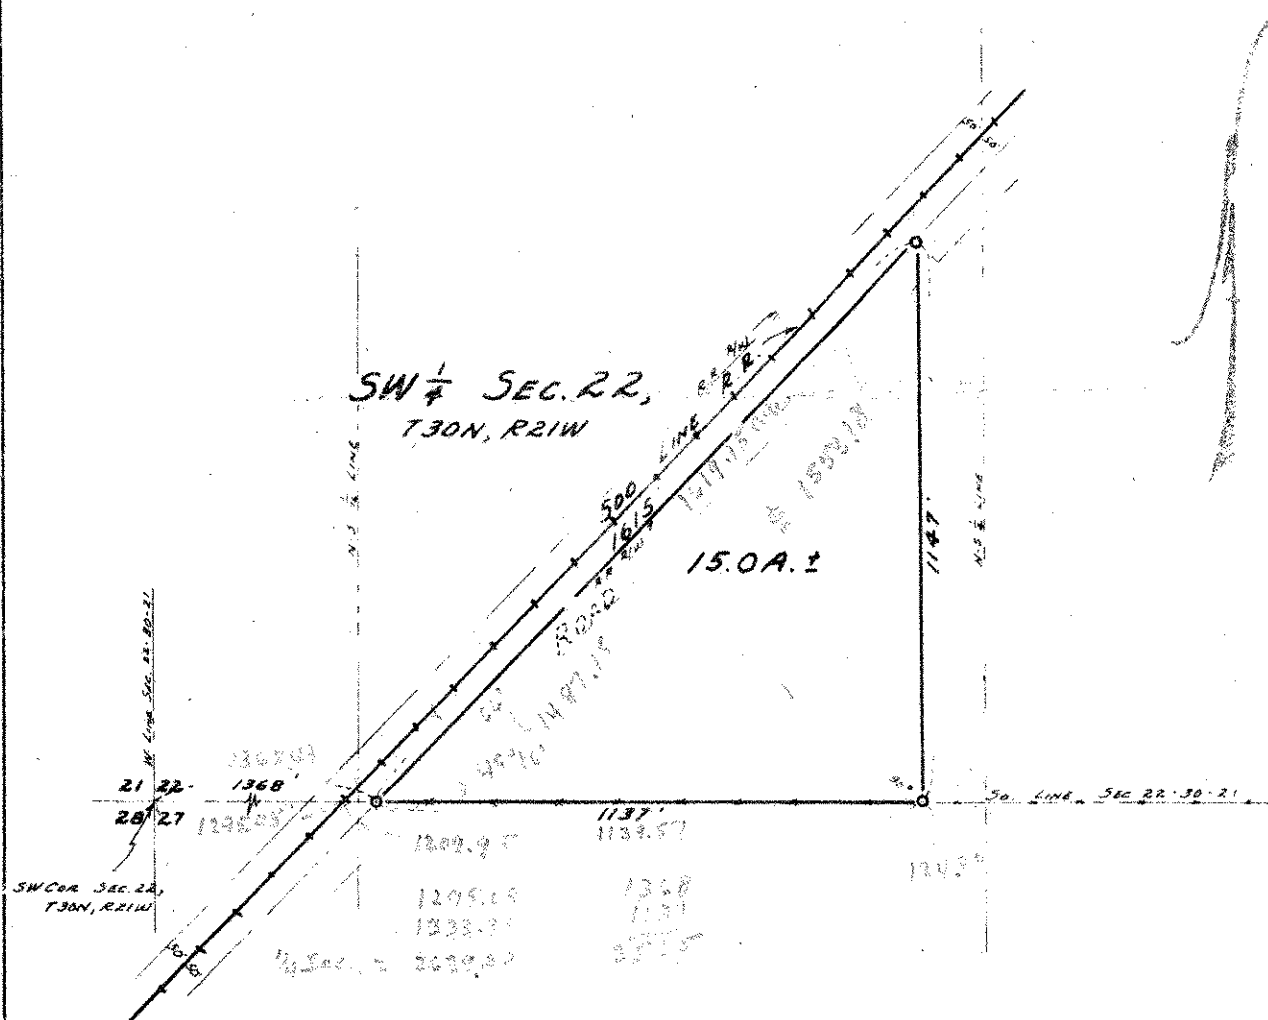

SURVEY MADE FOR: *MR. MARVIN E. WEISBROD, R.F.D. #3, STILLWATER, MINN.*

DESCRIPTION: SURVEY OF 15 ACRE TRACT LOCATED IN SE $\frac{1}{4}$ SW $\frac{1}{4}$ SEC. 22, T30N, R21W,
GRANT TOWNSHIP, WASHINGTON CO., MINN.

Office: Stillwater, Minn.

I hereby certify that I surveyed the property described above and that the above is true and correct plat of said survey.

Date FEB 27 1960

Scale: 1 inch.....*400*.....feet.
O—Indicates Irons.

James F. Simons
Surveyor