


Scale 30 Feet pr. inch.

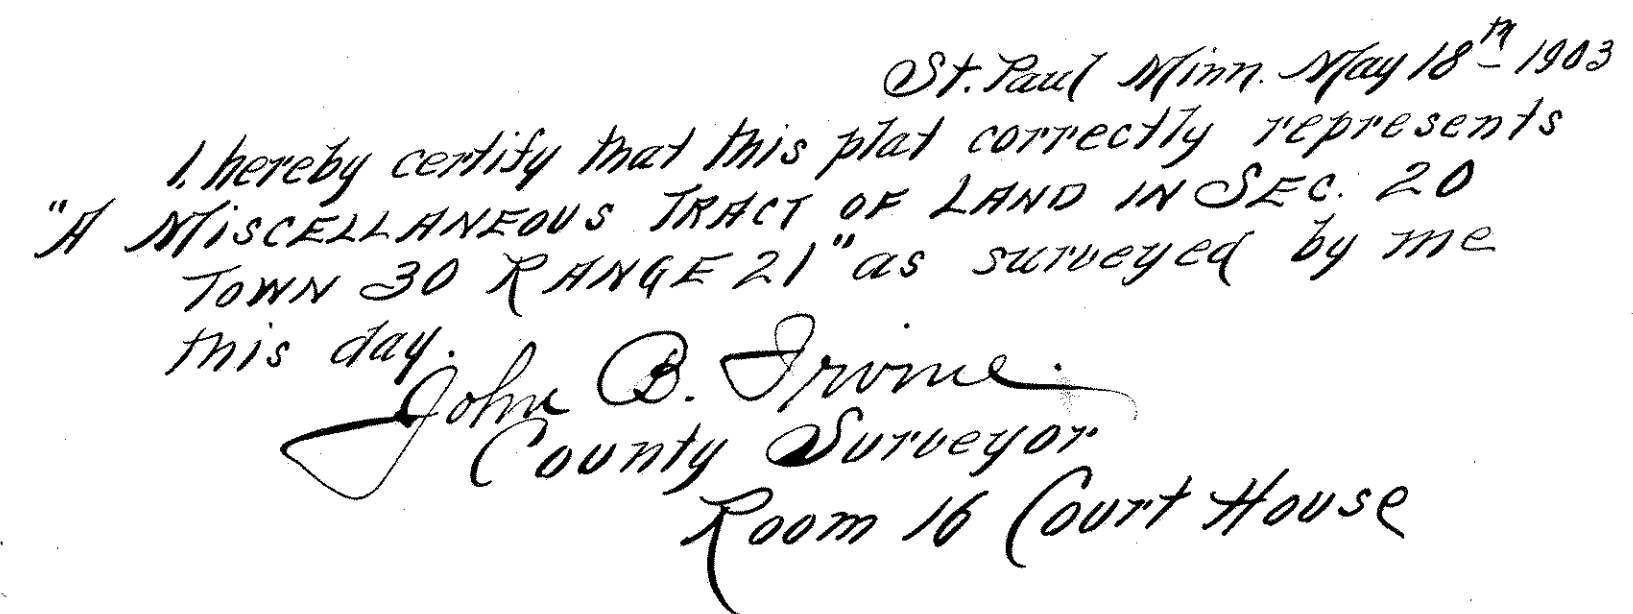

Telephone: 334 Twin City
Main 2535 51 North Western.

Mont.
Gen. Sec. 20
T. 30, R. 21.