



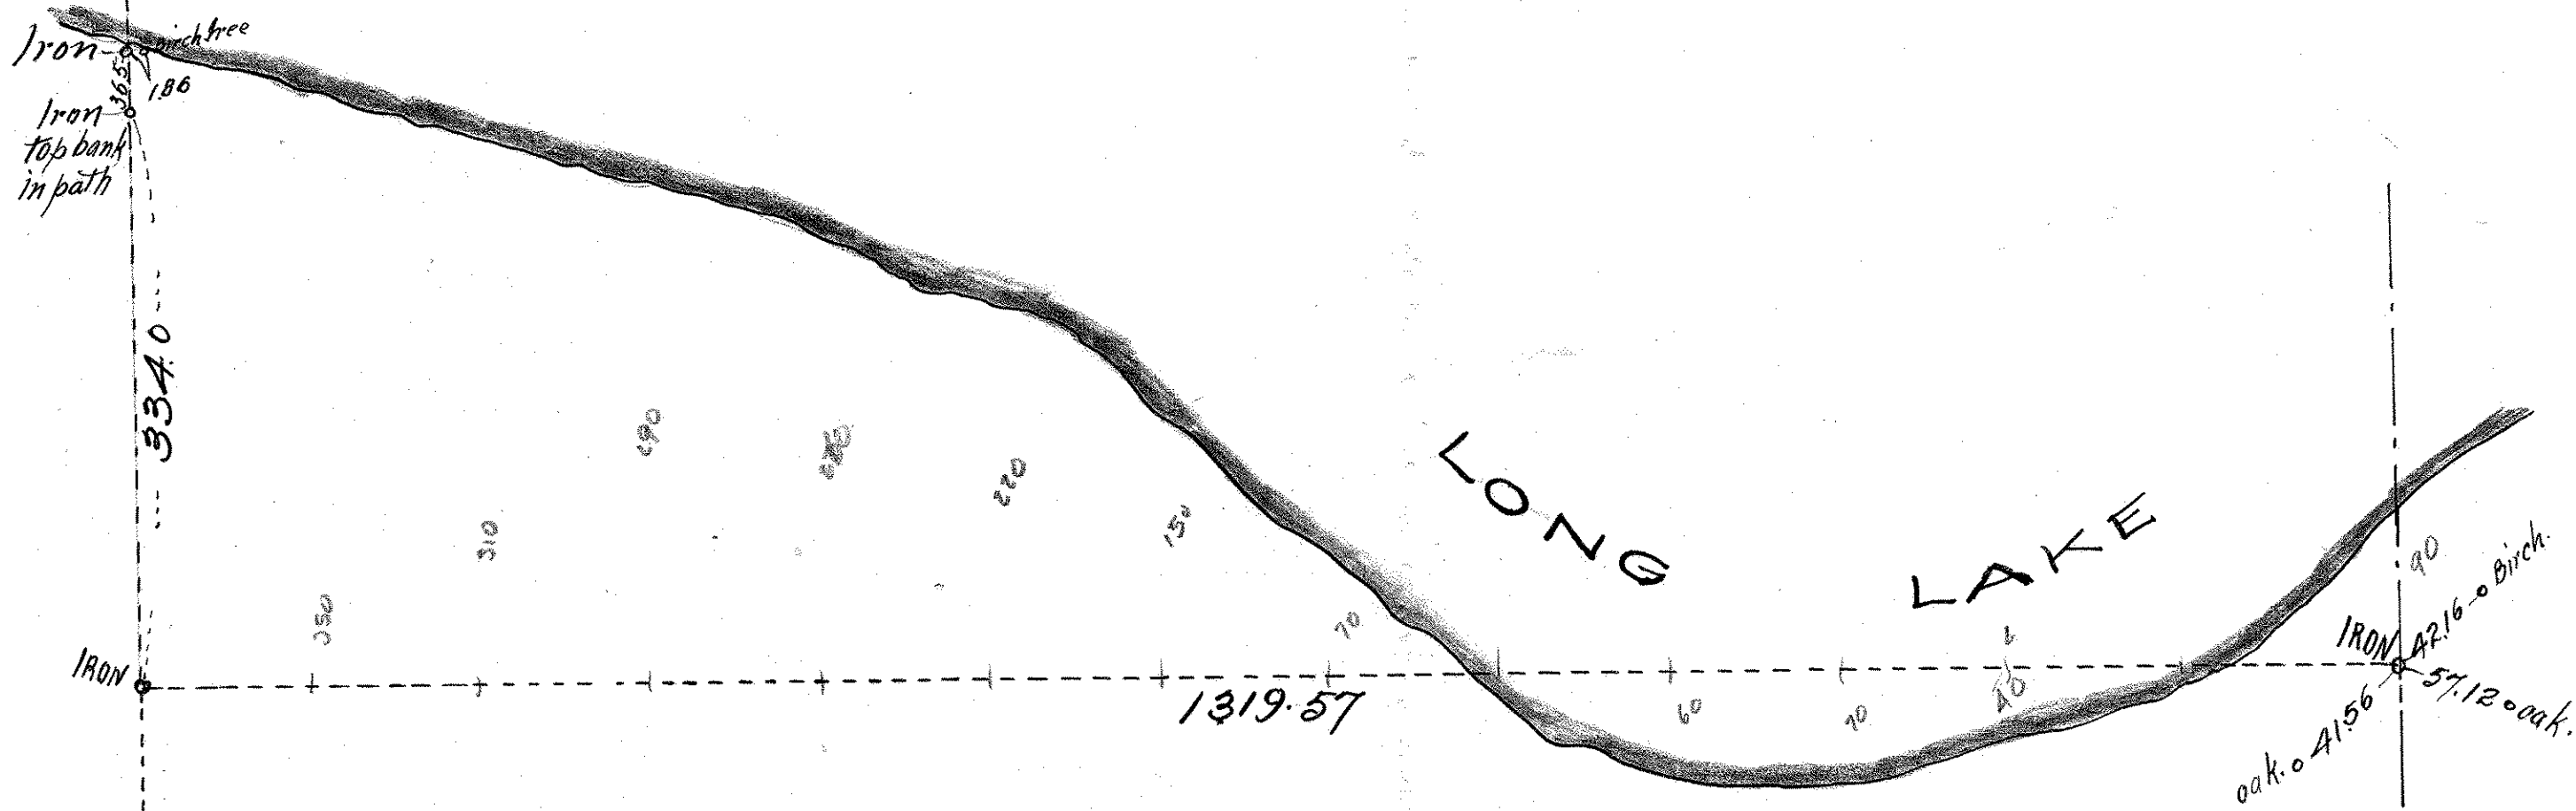

17.56 ACRES

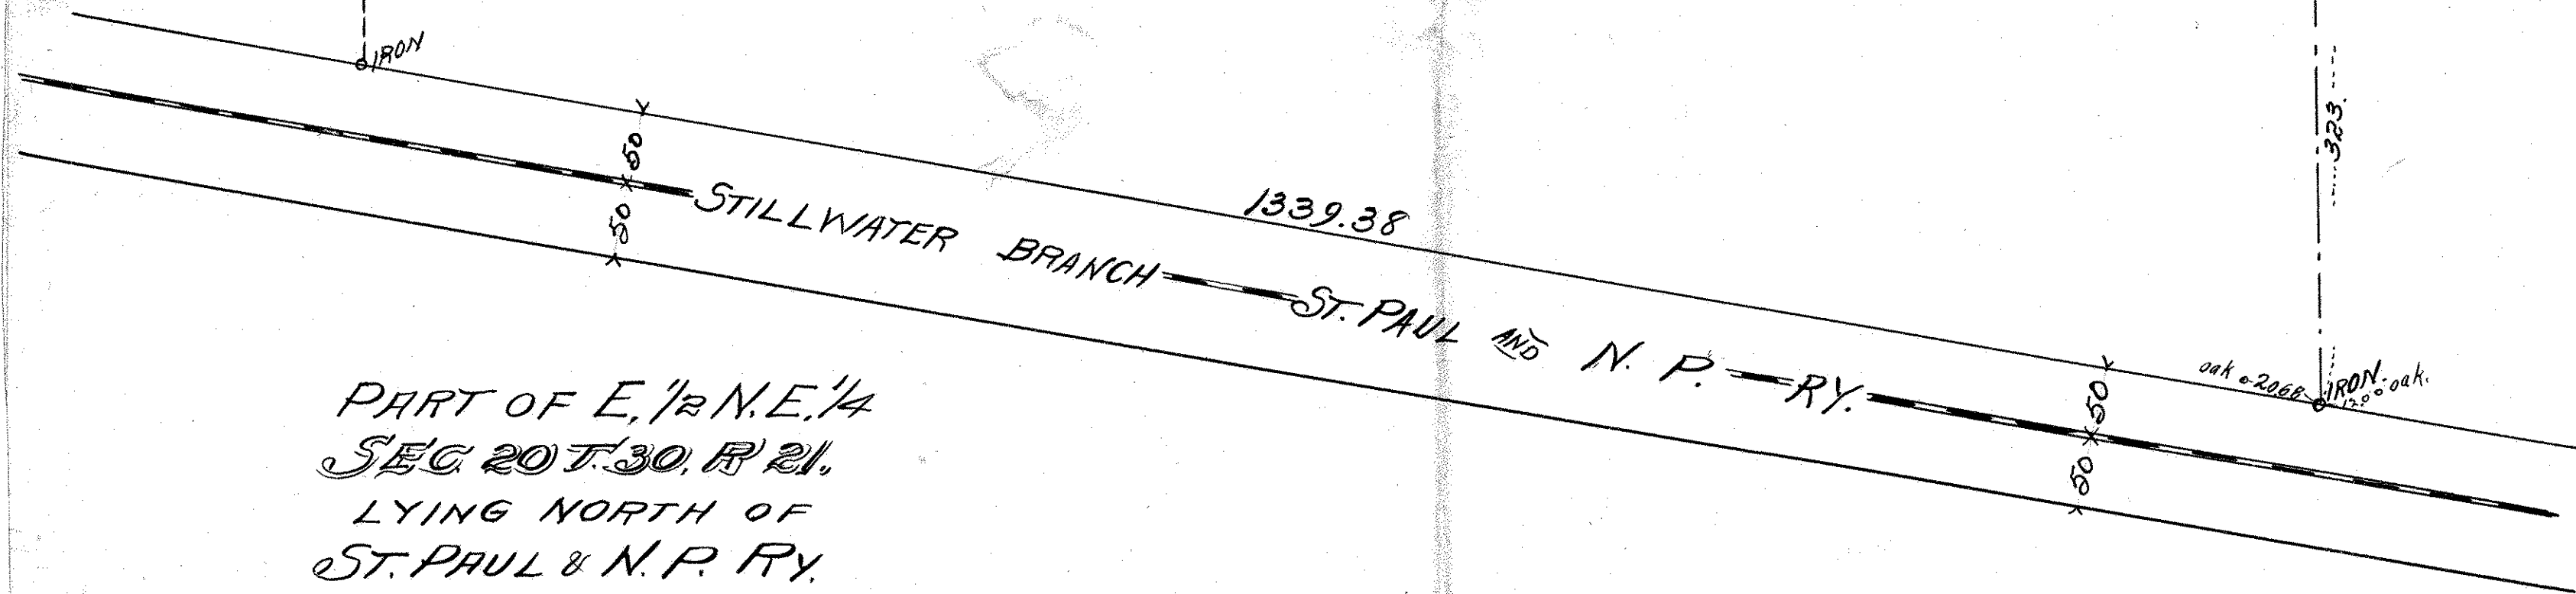

PART OF E. 1/2 N. E. 1/4
SEC 20 T. 30. R. 21.
LYING NORTH OF
ST. PAUL & N. P. RY.

JOHN B. IRVINE, SURVEYOR.

408 GLOBE BLDG.

ST. PAUL, MINN.

JULY 13-1915

scale 100 ft. per inch.