SE 32 30 21

Certificate of Survey

From the office of

GEORGI- SCHMIDT & ASSOC. INC.

3092 No. Lexington Ave., Roseville, Mn. 55113

LAND SURVEYING

483-4408

I Hereby Certify that this plat shows a survey made by me of the property described on this plat, and that the corners are correctly placed as shown, and that all locations have been correctly shown.

Job Number: 1065

Surveyed For Michels Const.

Date 10/15/81

Scale 1" = 50'

By Lawrence W. Schmidt

REGISTERED LAND SURVEYOR

DESCRIPTION:

Lot 18, Block 4, Winmar Estates
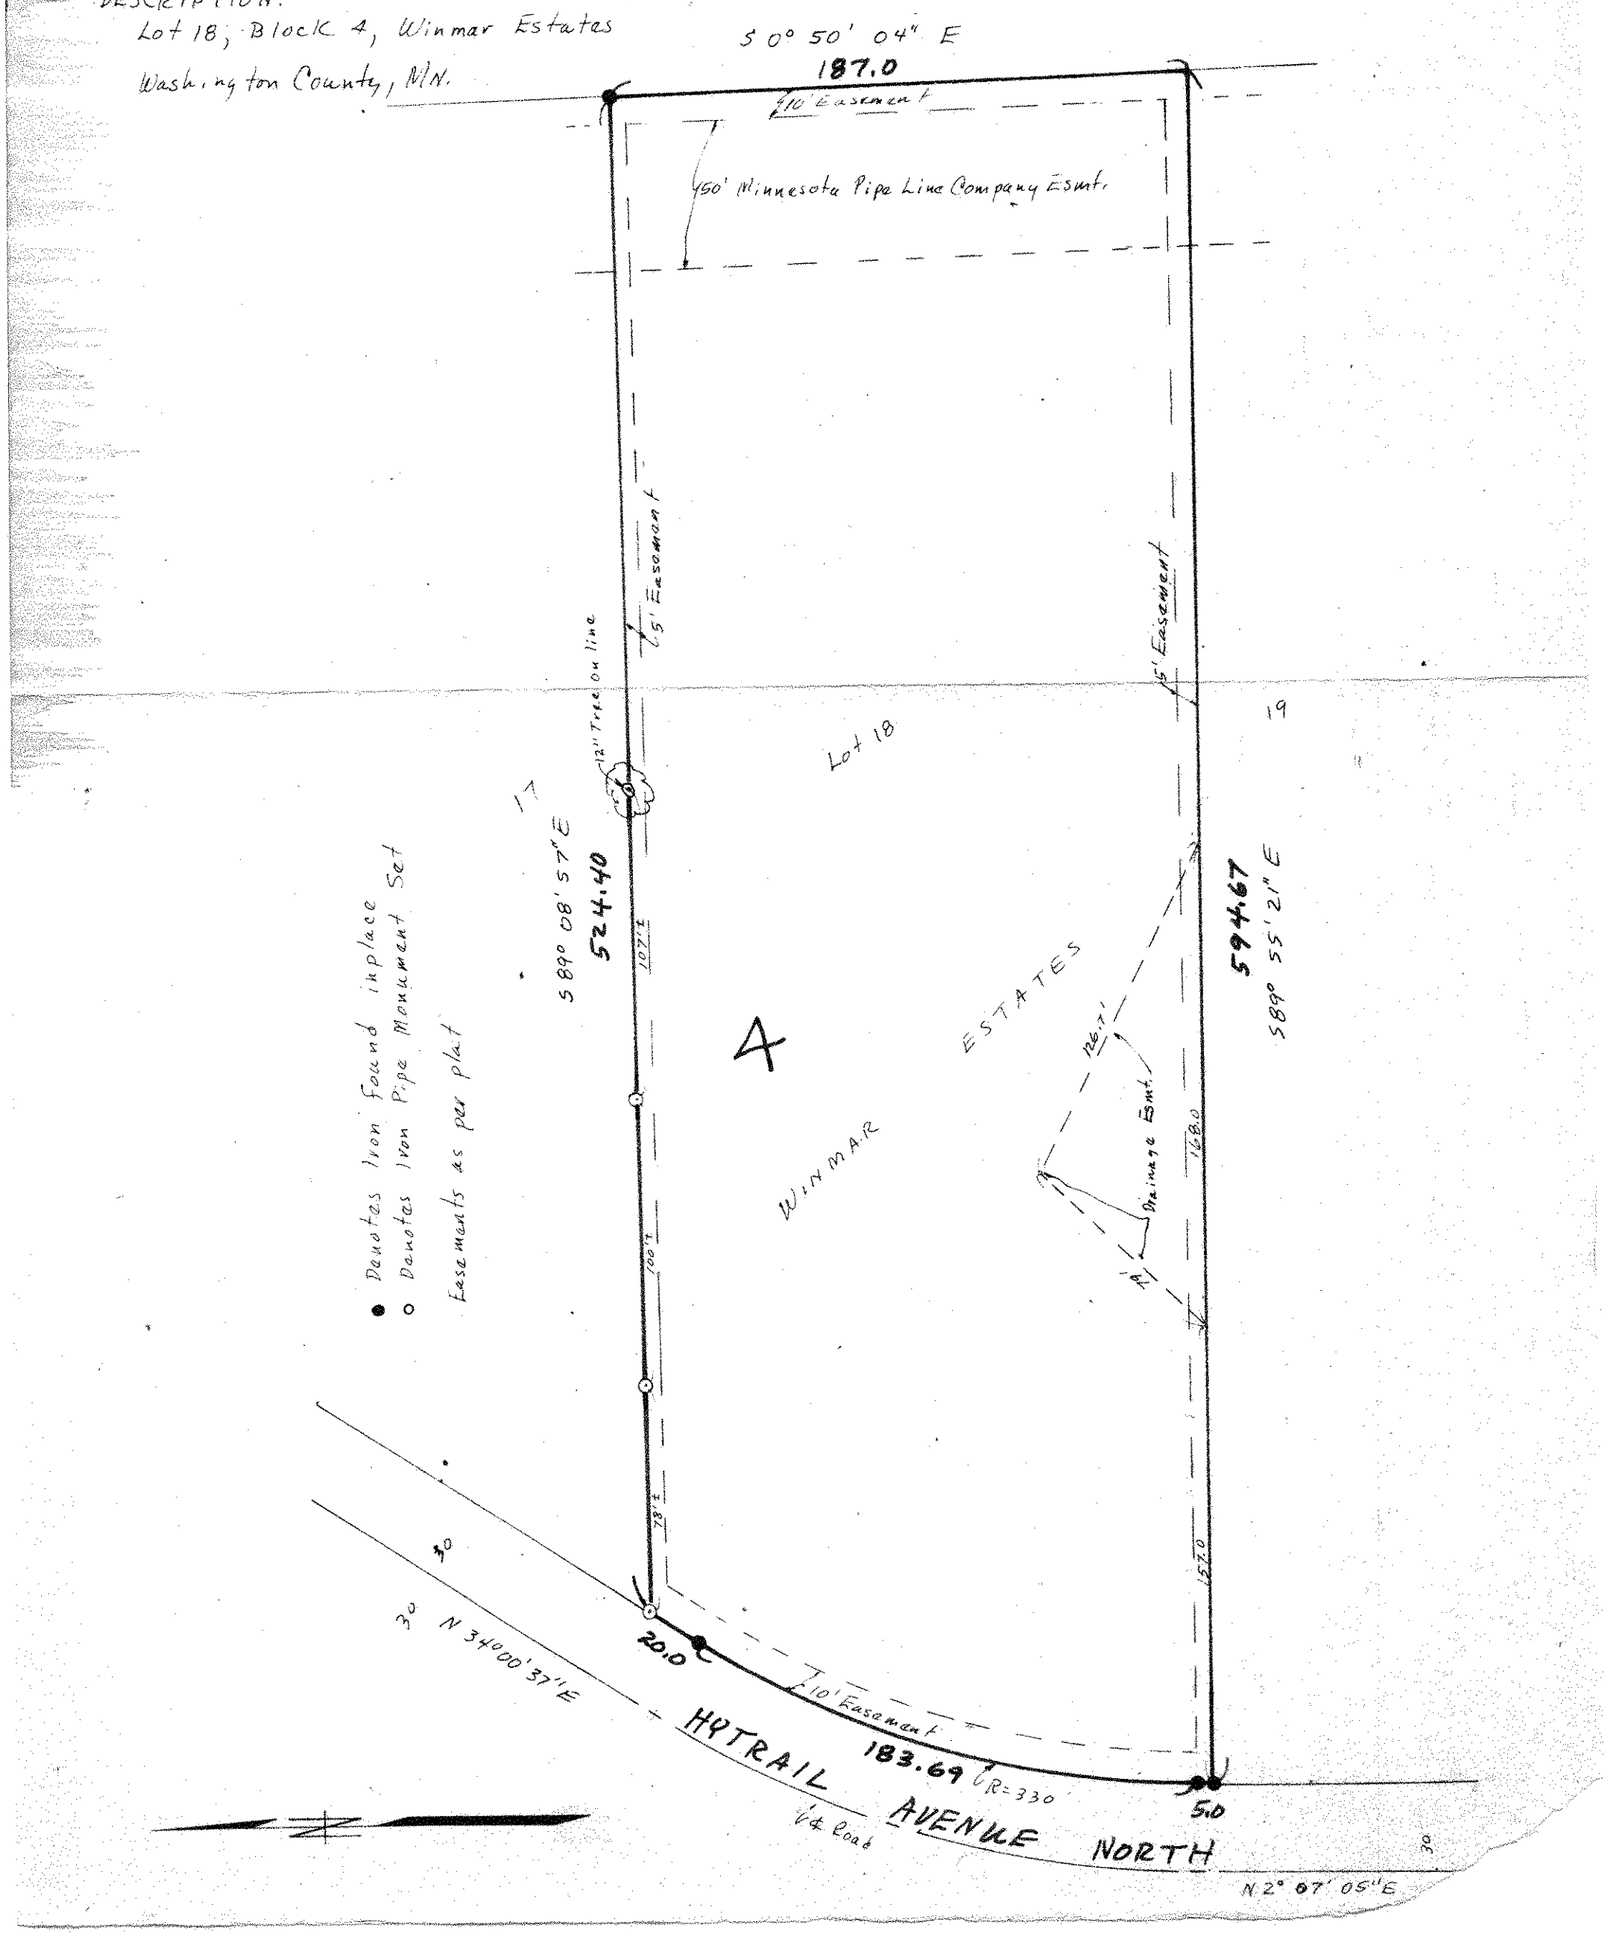
Washington County, MN.