


6	5	4	3	2	1
7	8	9	10	11	12
18	17	16	15	14	13
19	20	21	22	23	24
30	29	28	27	26	25
31	32	33	34	35	36

10-29-22

3

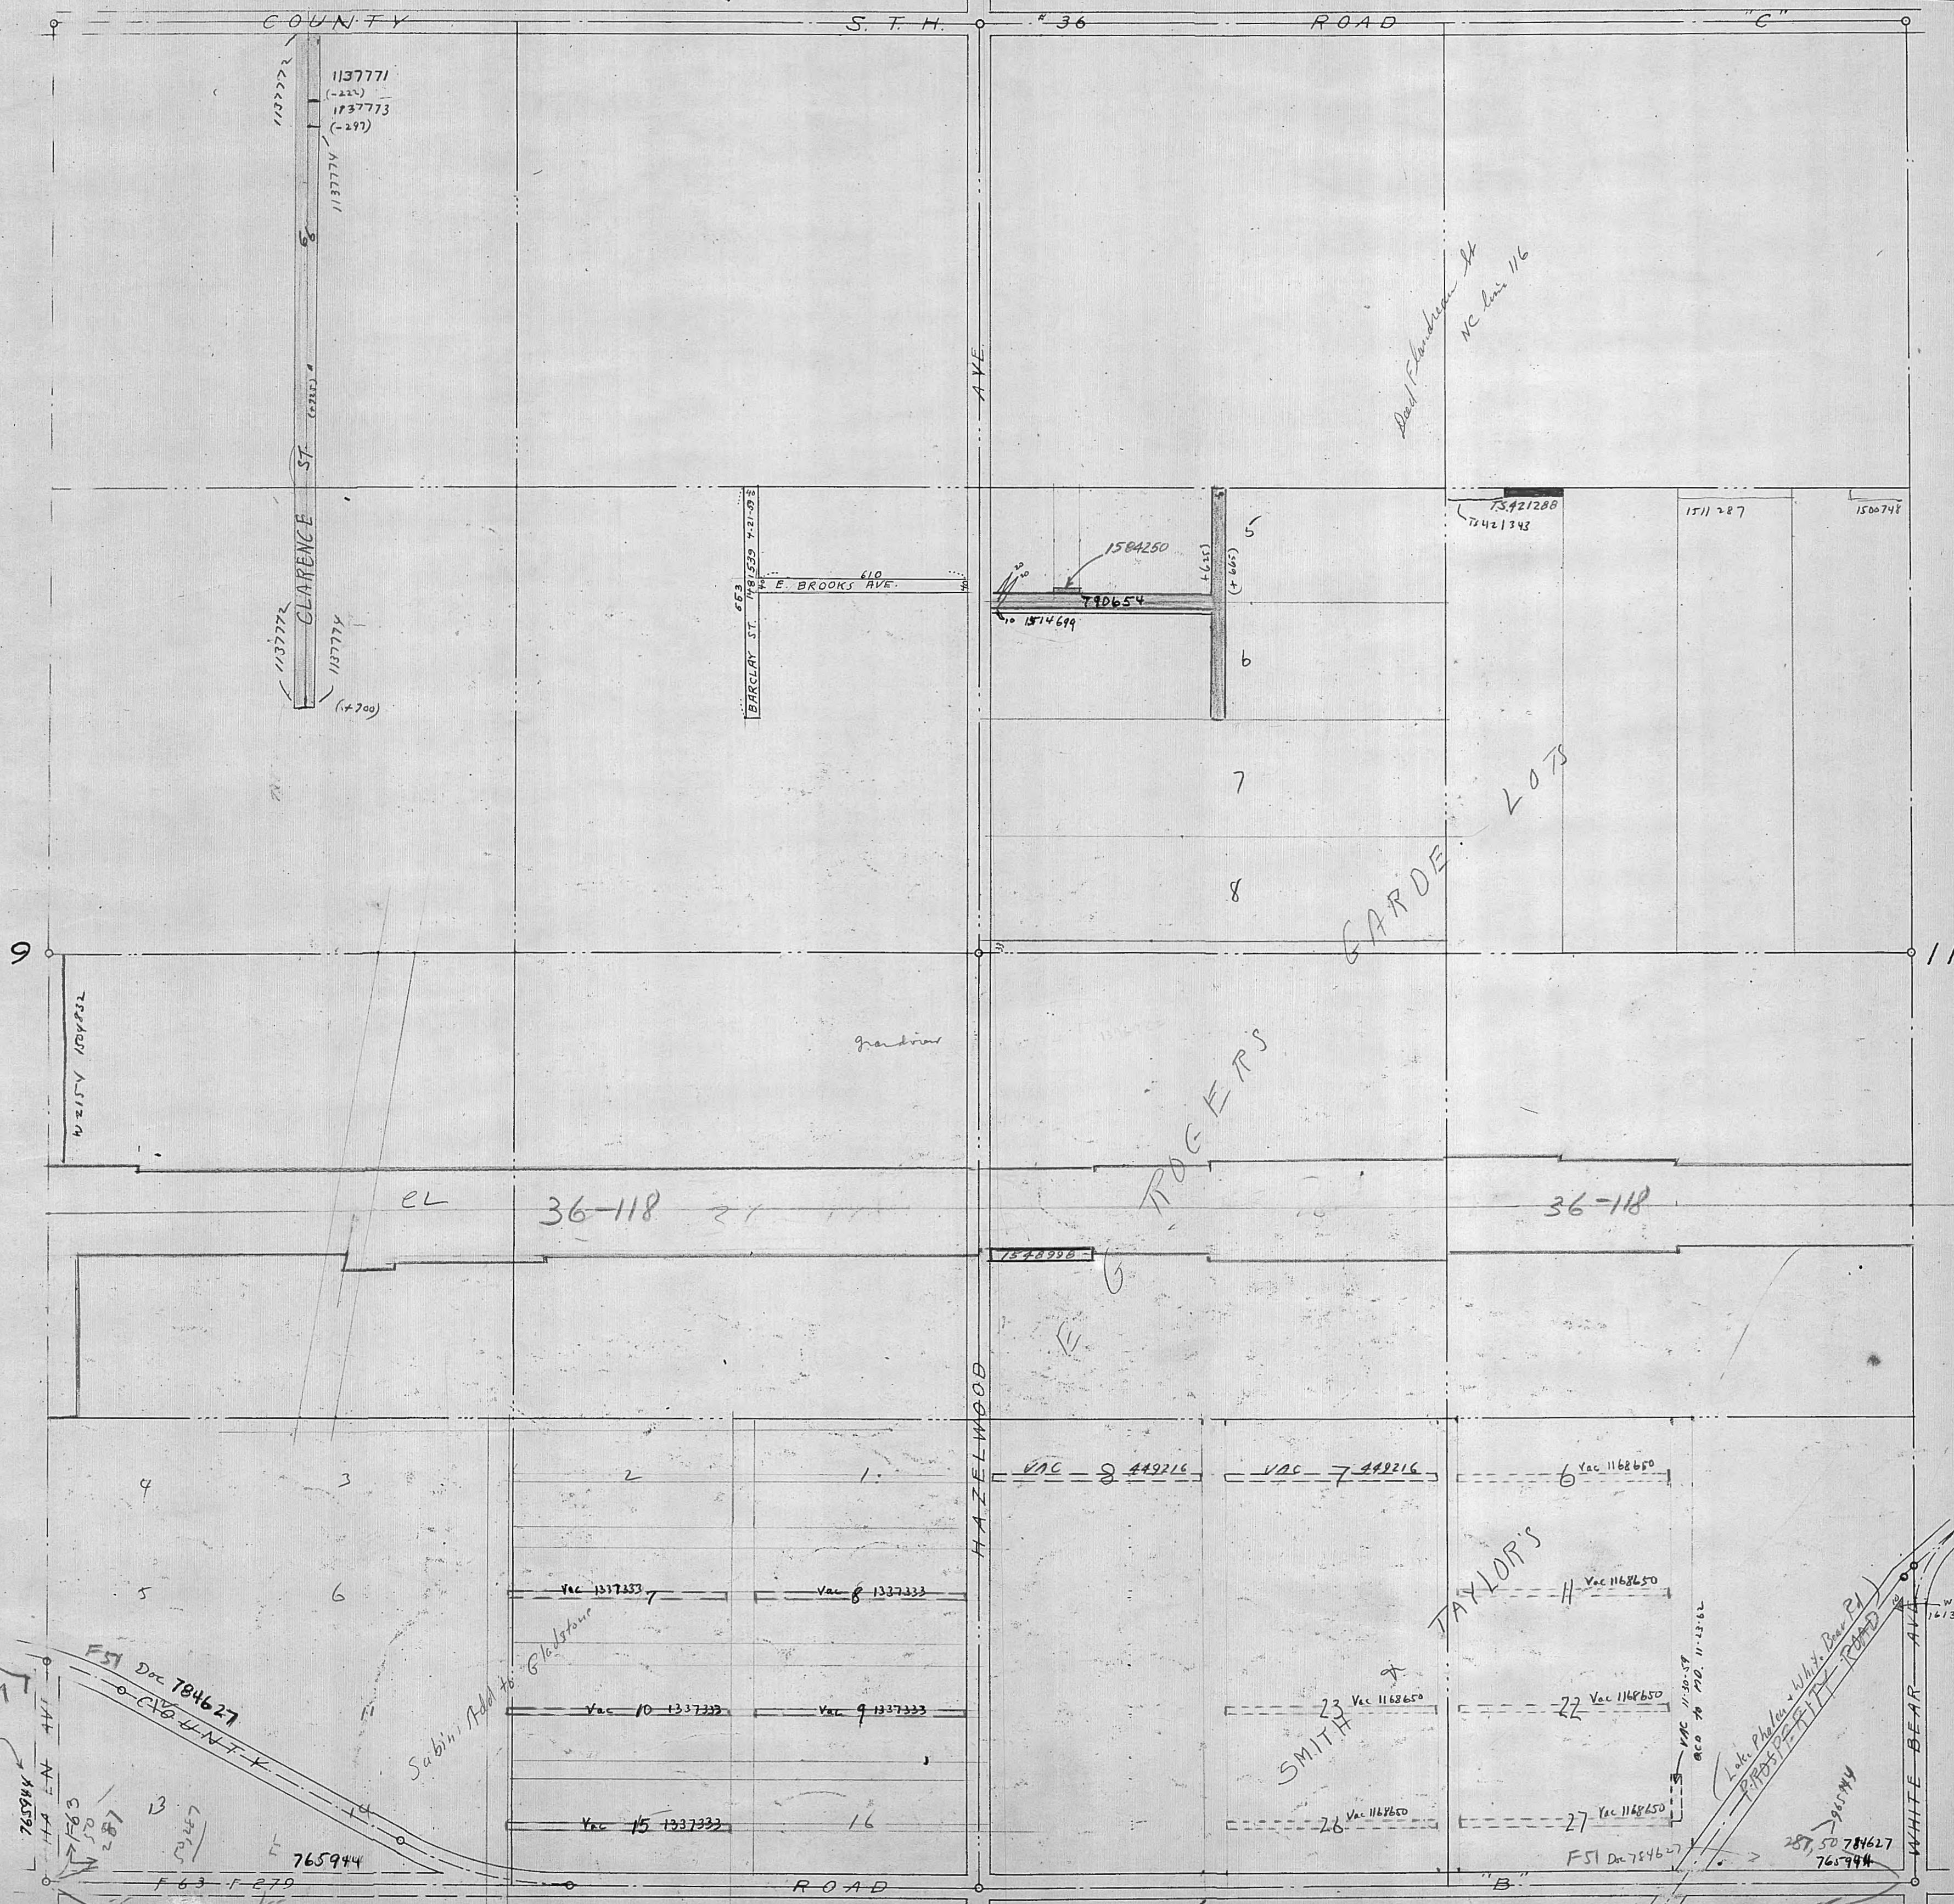

9

11

HAZELWOOD AVE

ROAD

"B"

15