

6	5	4	3	2	1
7	8	9	10	11	12
13	14	15	16	17	18
19	20	21	22	23	24
25	26	27	28	29	30
31	32	33	34	35	36

13-29-22


Street Plan
NE 1/4
Revised 1294903

12

916603 g Lakes
10-11-14

1192999
Pole East

1275663, Rev
1294903, Map
Street Plan

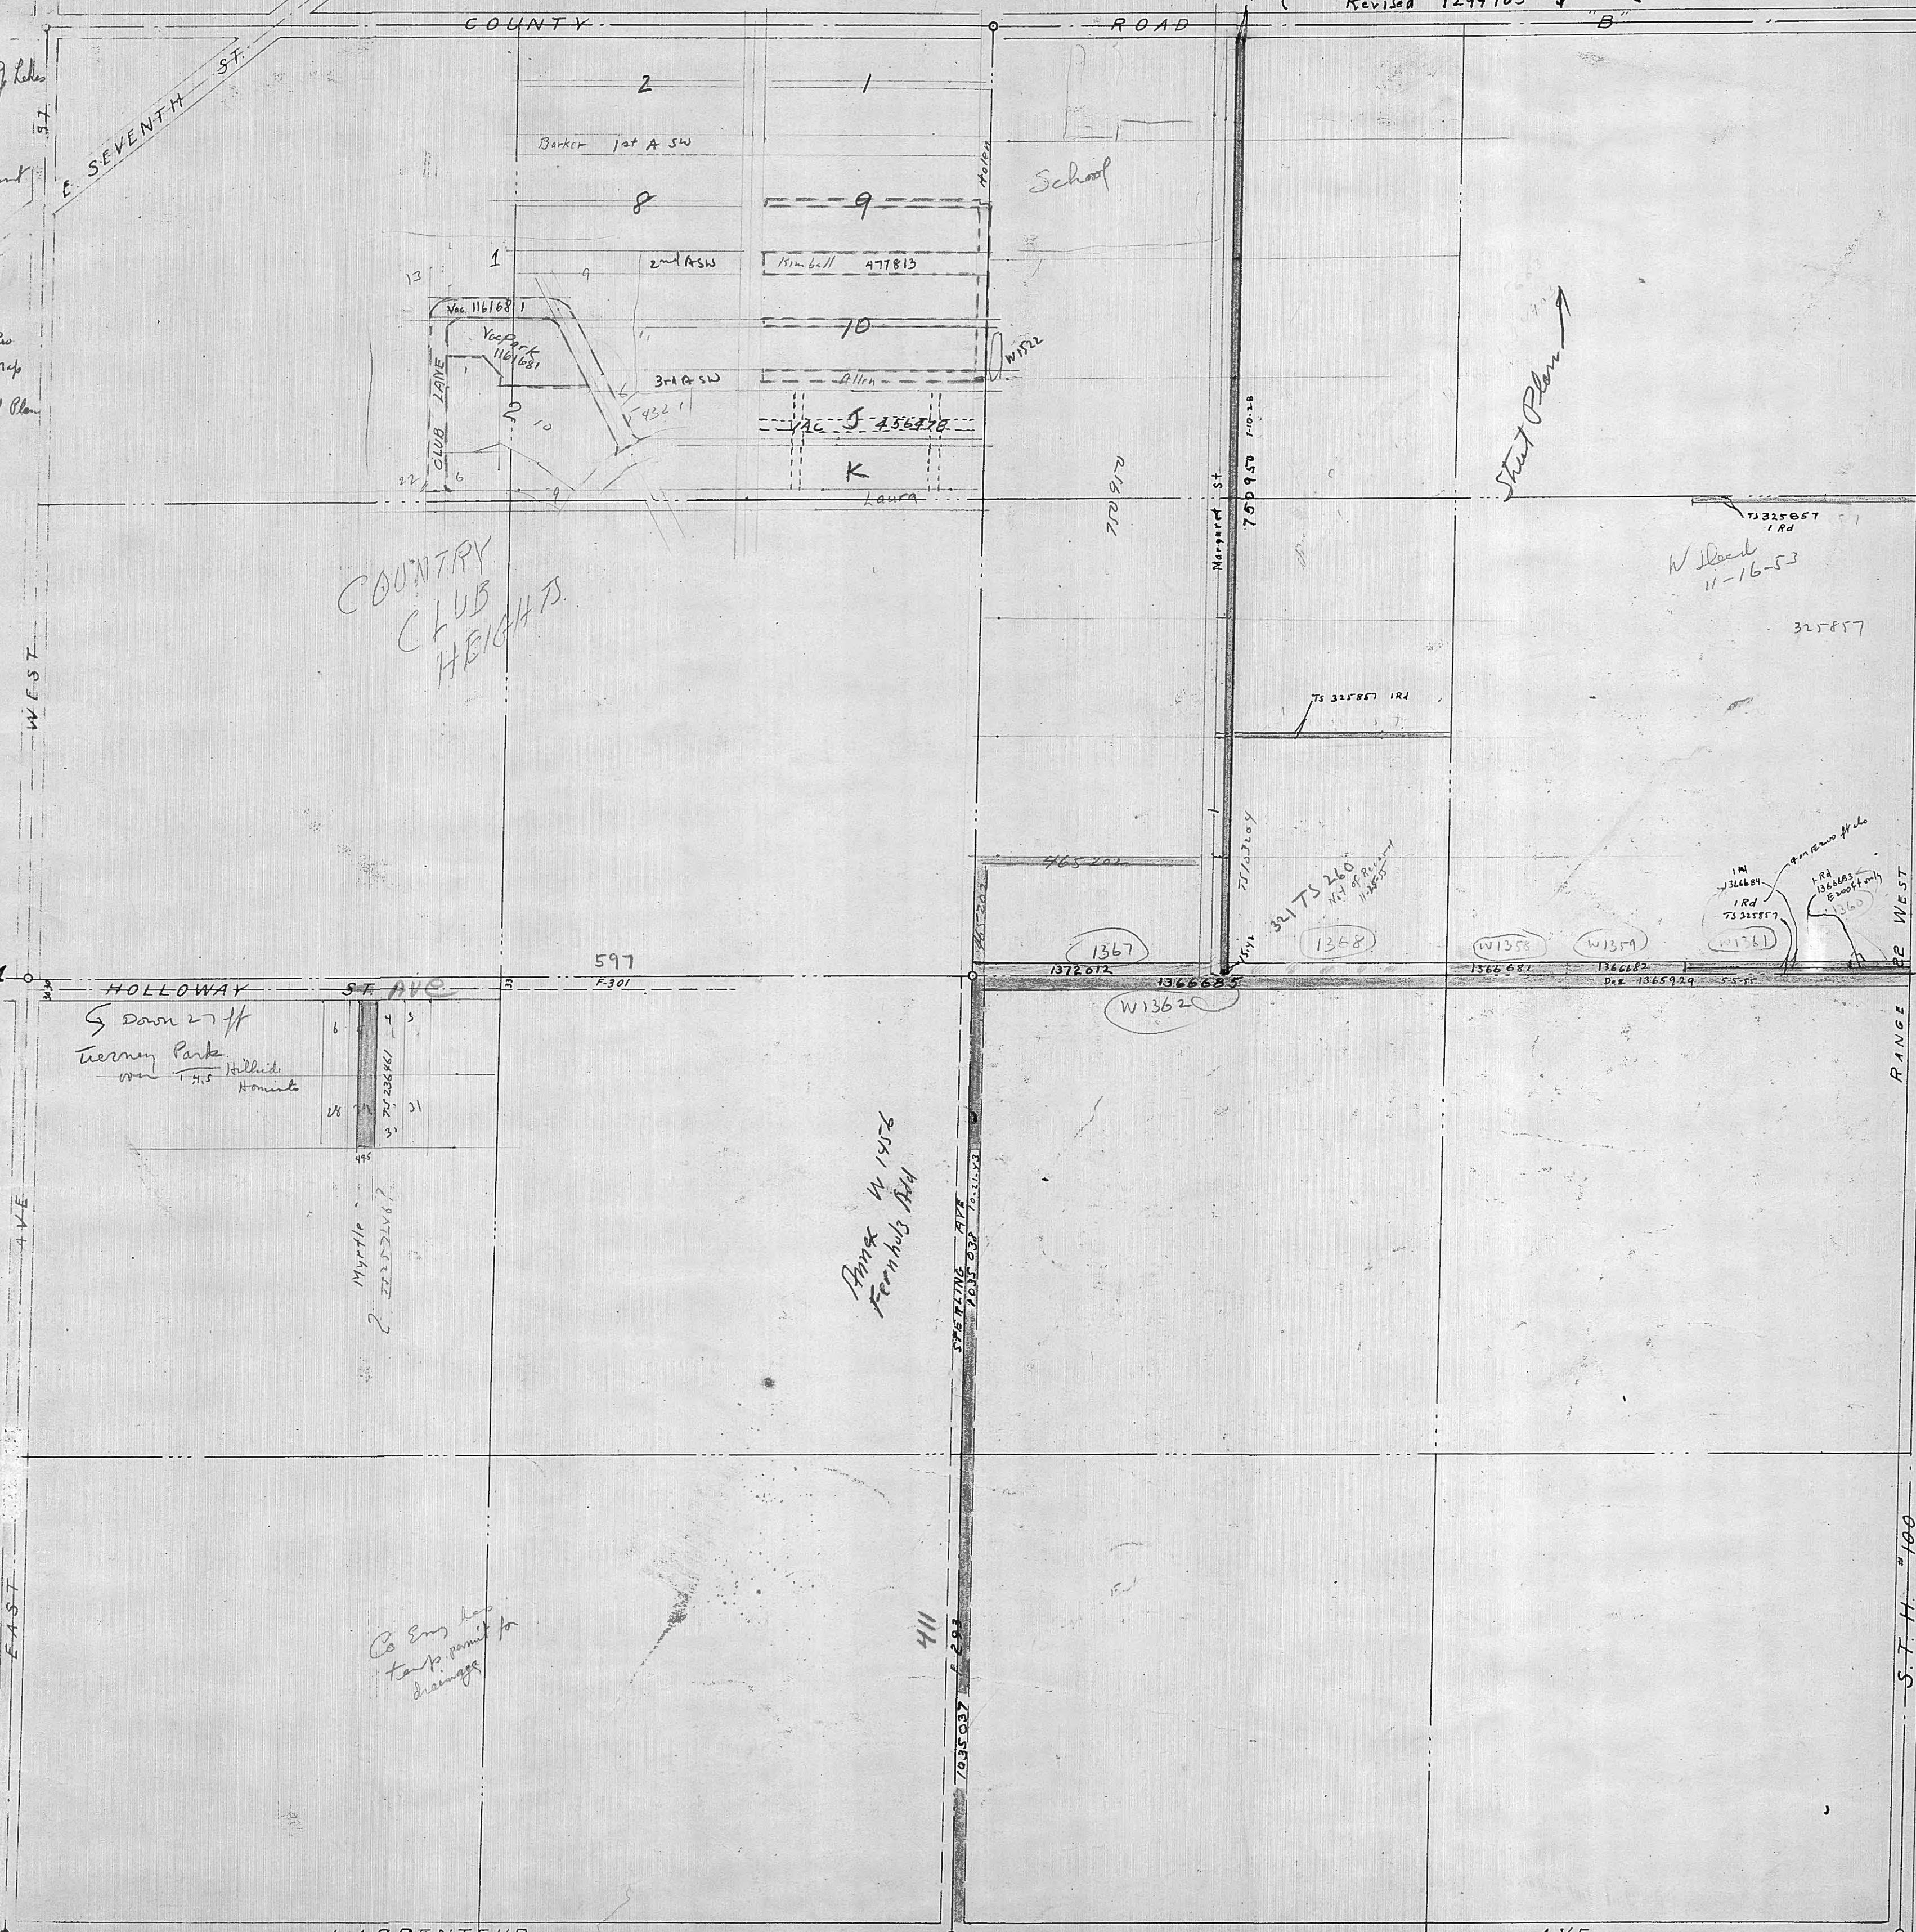

Foot on map

5 down 27 ft
turning Park
Hillside
Hornite

Co Eng has
tank permit for
drainage

Annex W 1456
Fernhills Add

W 1362
11-16-53

W 1361
W 1362
