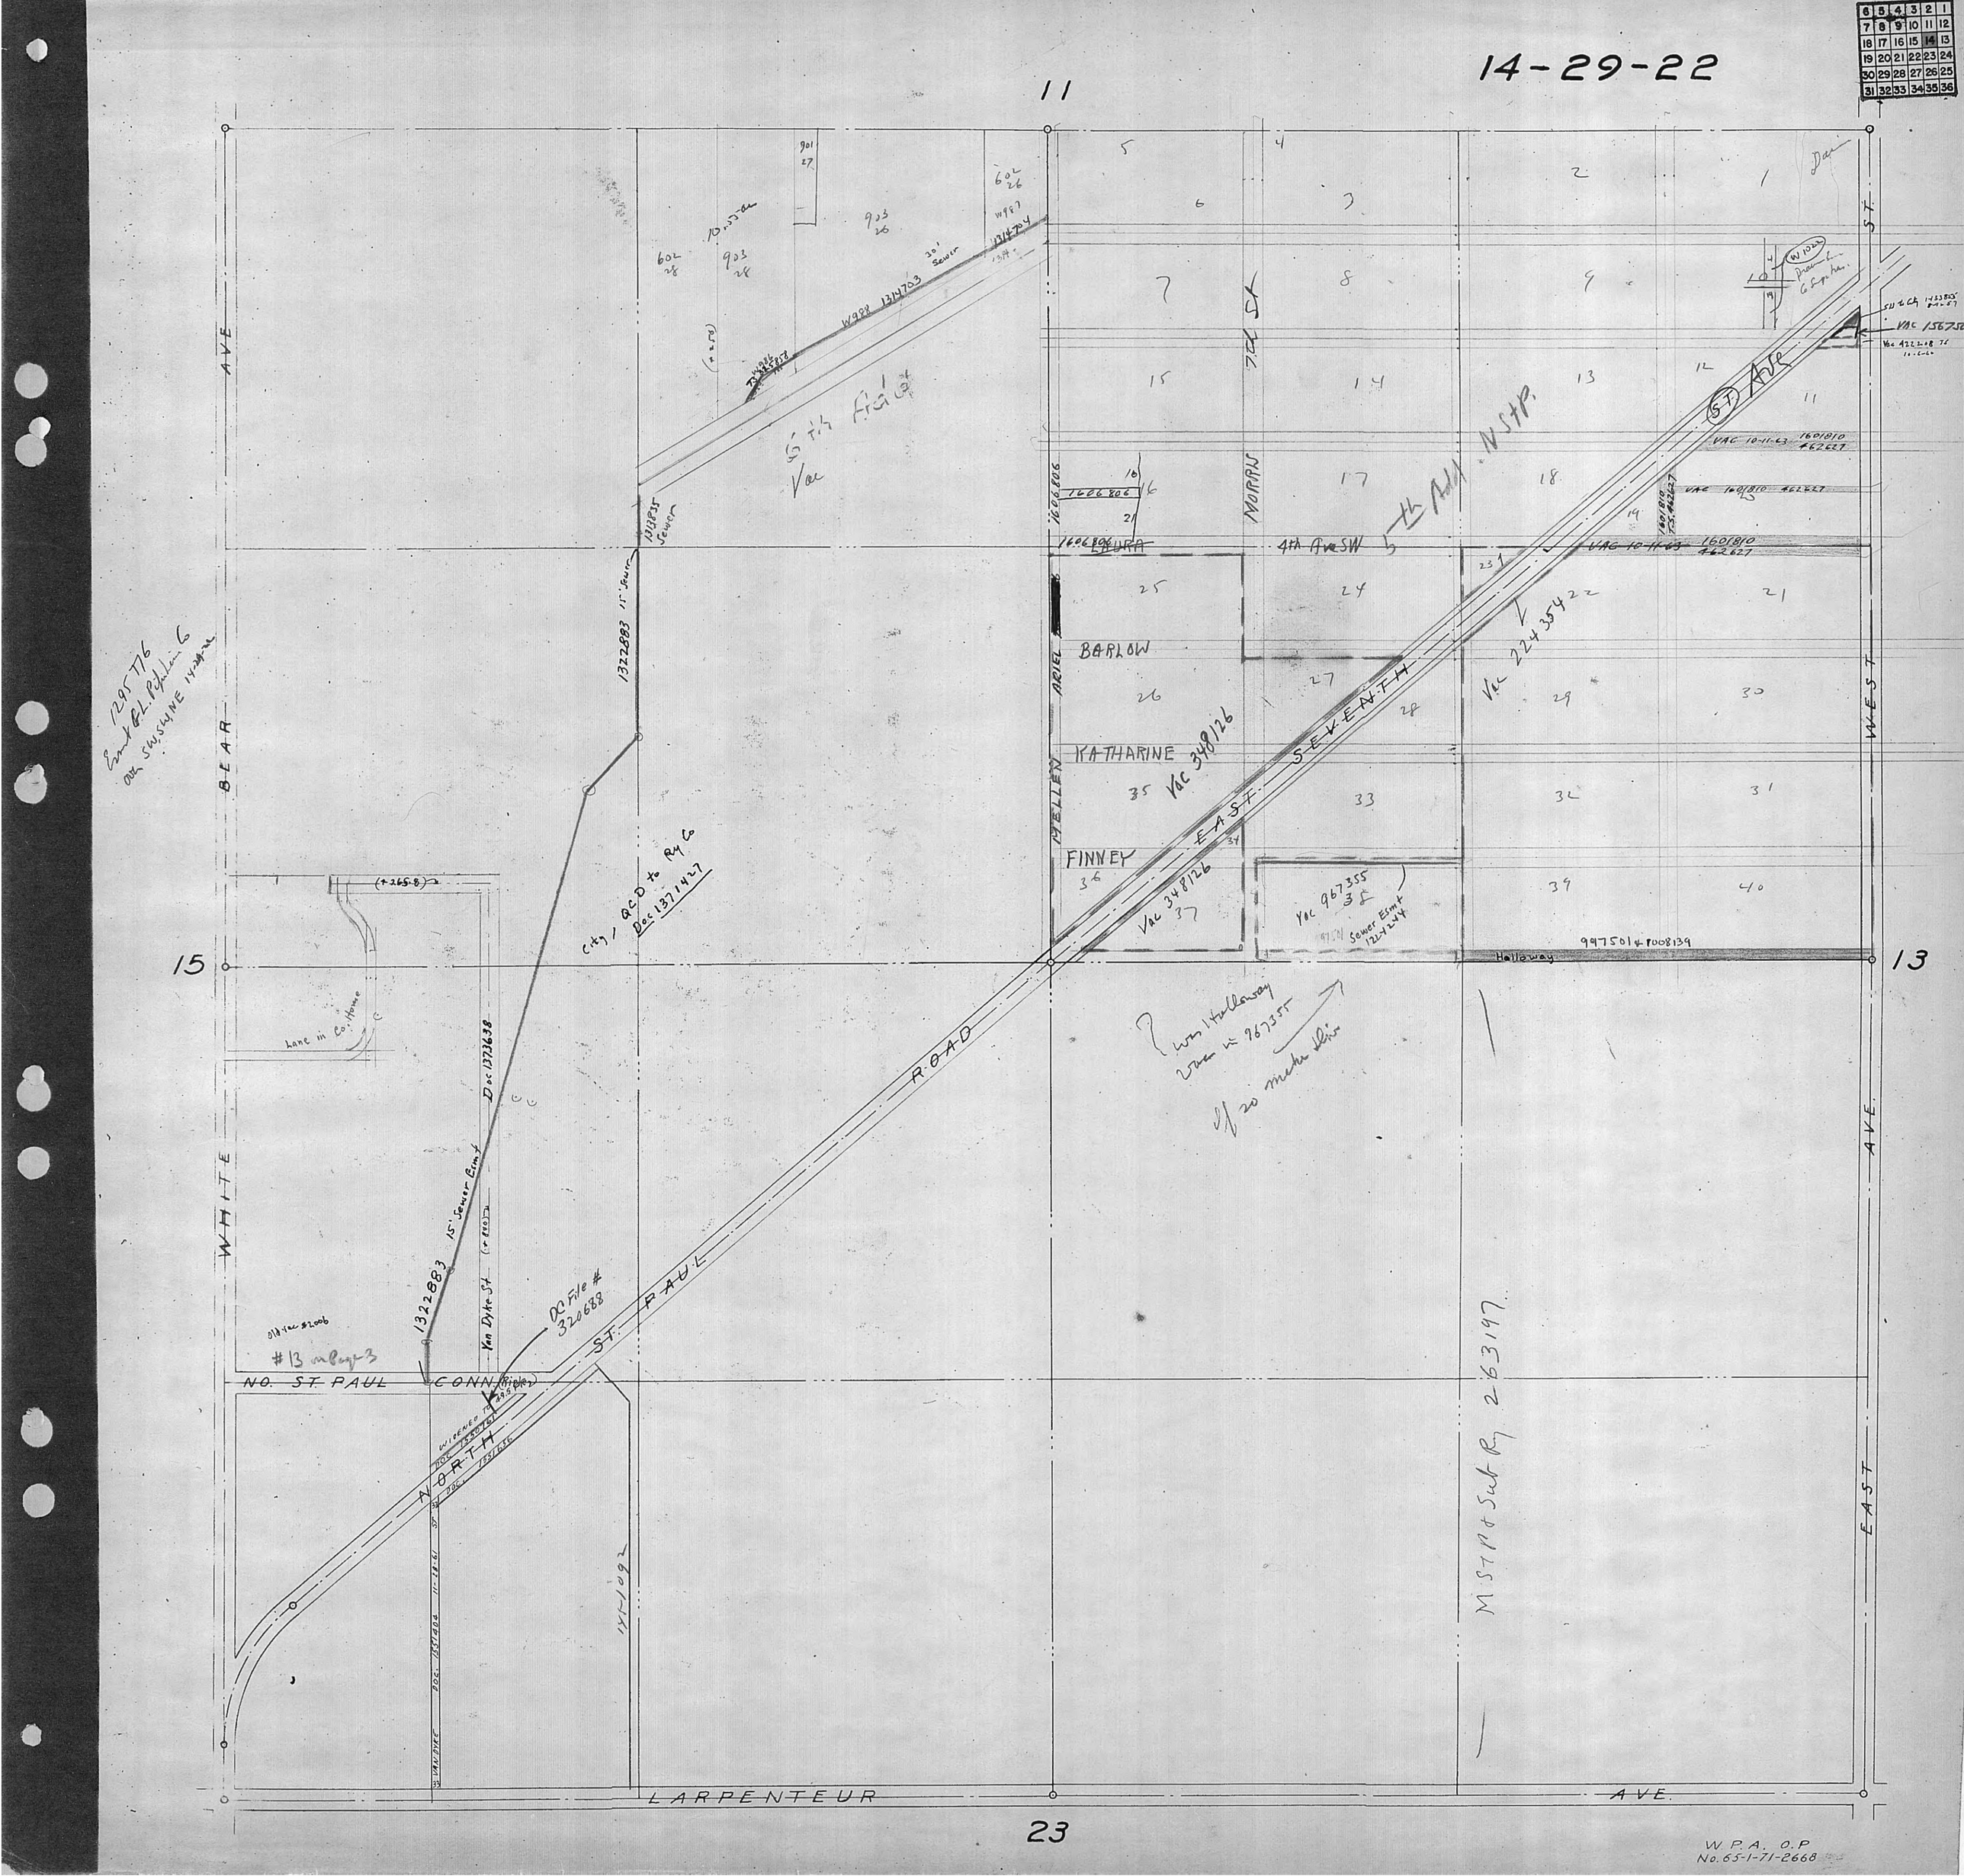
14-29-22
11
15
13
23
BEAR AVE
WHITE
WEST ST.
EAST AVE.
LARPENTEUR AVE.
NO. ST. PAUL CONN.
NORTH ST. PAUL ROAD
EAST SEVENTH
MELLEN ARIEL
MORRIS
LAURA
BARLOW
KATHARINE
FINNEY
4th Ave SW
5th Add. N St P.
Halloway
Van Dyke St
Vac 348126
Vac 224354
Vac 967355
Sewer Esmt 1224244
997501 & 1008139
1322883 15' Sewer Esmt
Doc 1373638
City / QCD to Ry Co
Doc 1371427
DC File # 320688
1295776
Esmt G.L. Pipeline Co
over SW, SW, NE 14-29-22
6th Add Vac
Lane in Co. Home
Old Vac #2006
#13 on Page 3
M St P & Sub Ry 263197
? was Halloway vac in 967355
If so make this
W.P.A. O.P.
No. 65-1-71-2668