


6	5	4	3	2	1
7	8	9	10	11	12
13	14	15	16	17	18
19	20	21	22	23	24
25	26	27	28	29	30
31	32	33	34	35	36

15-29-22

10

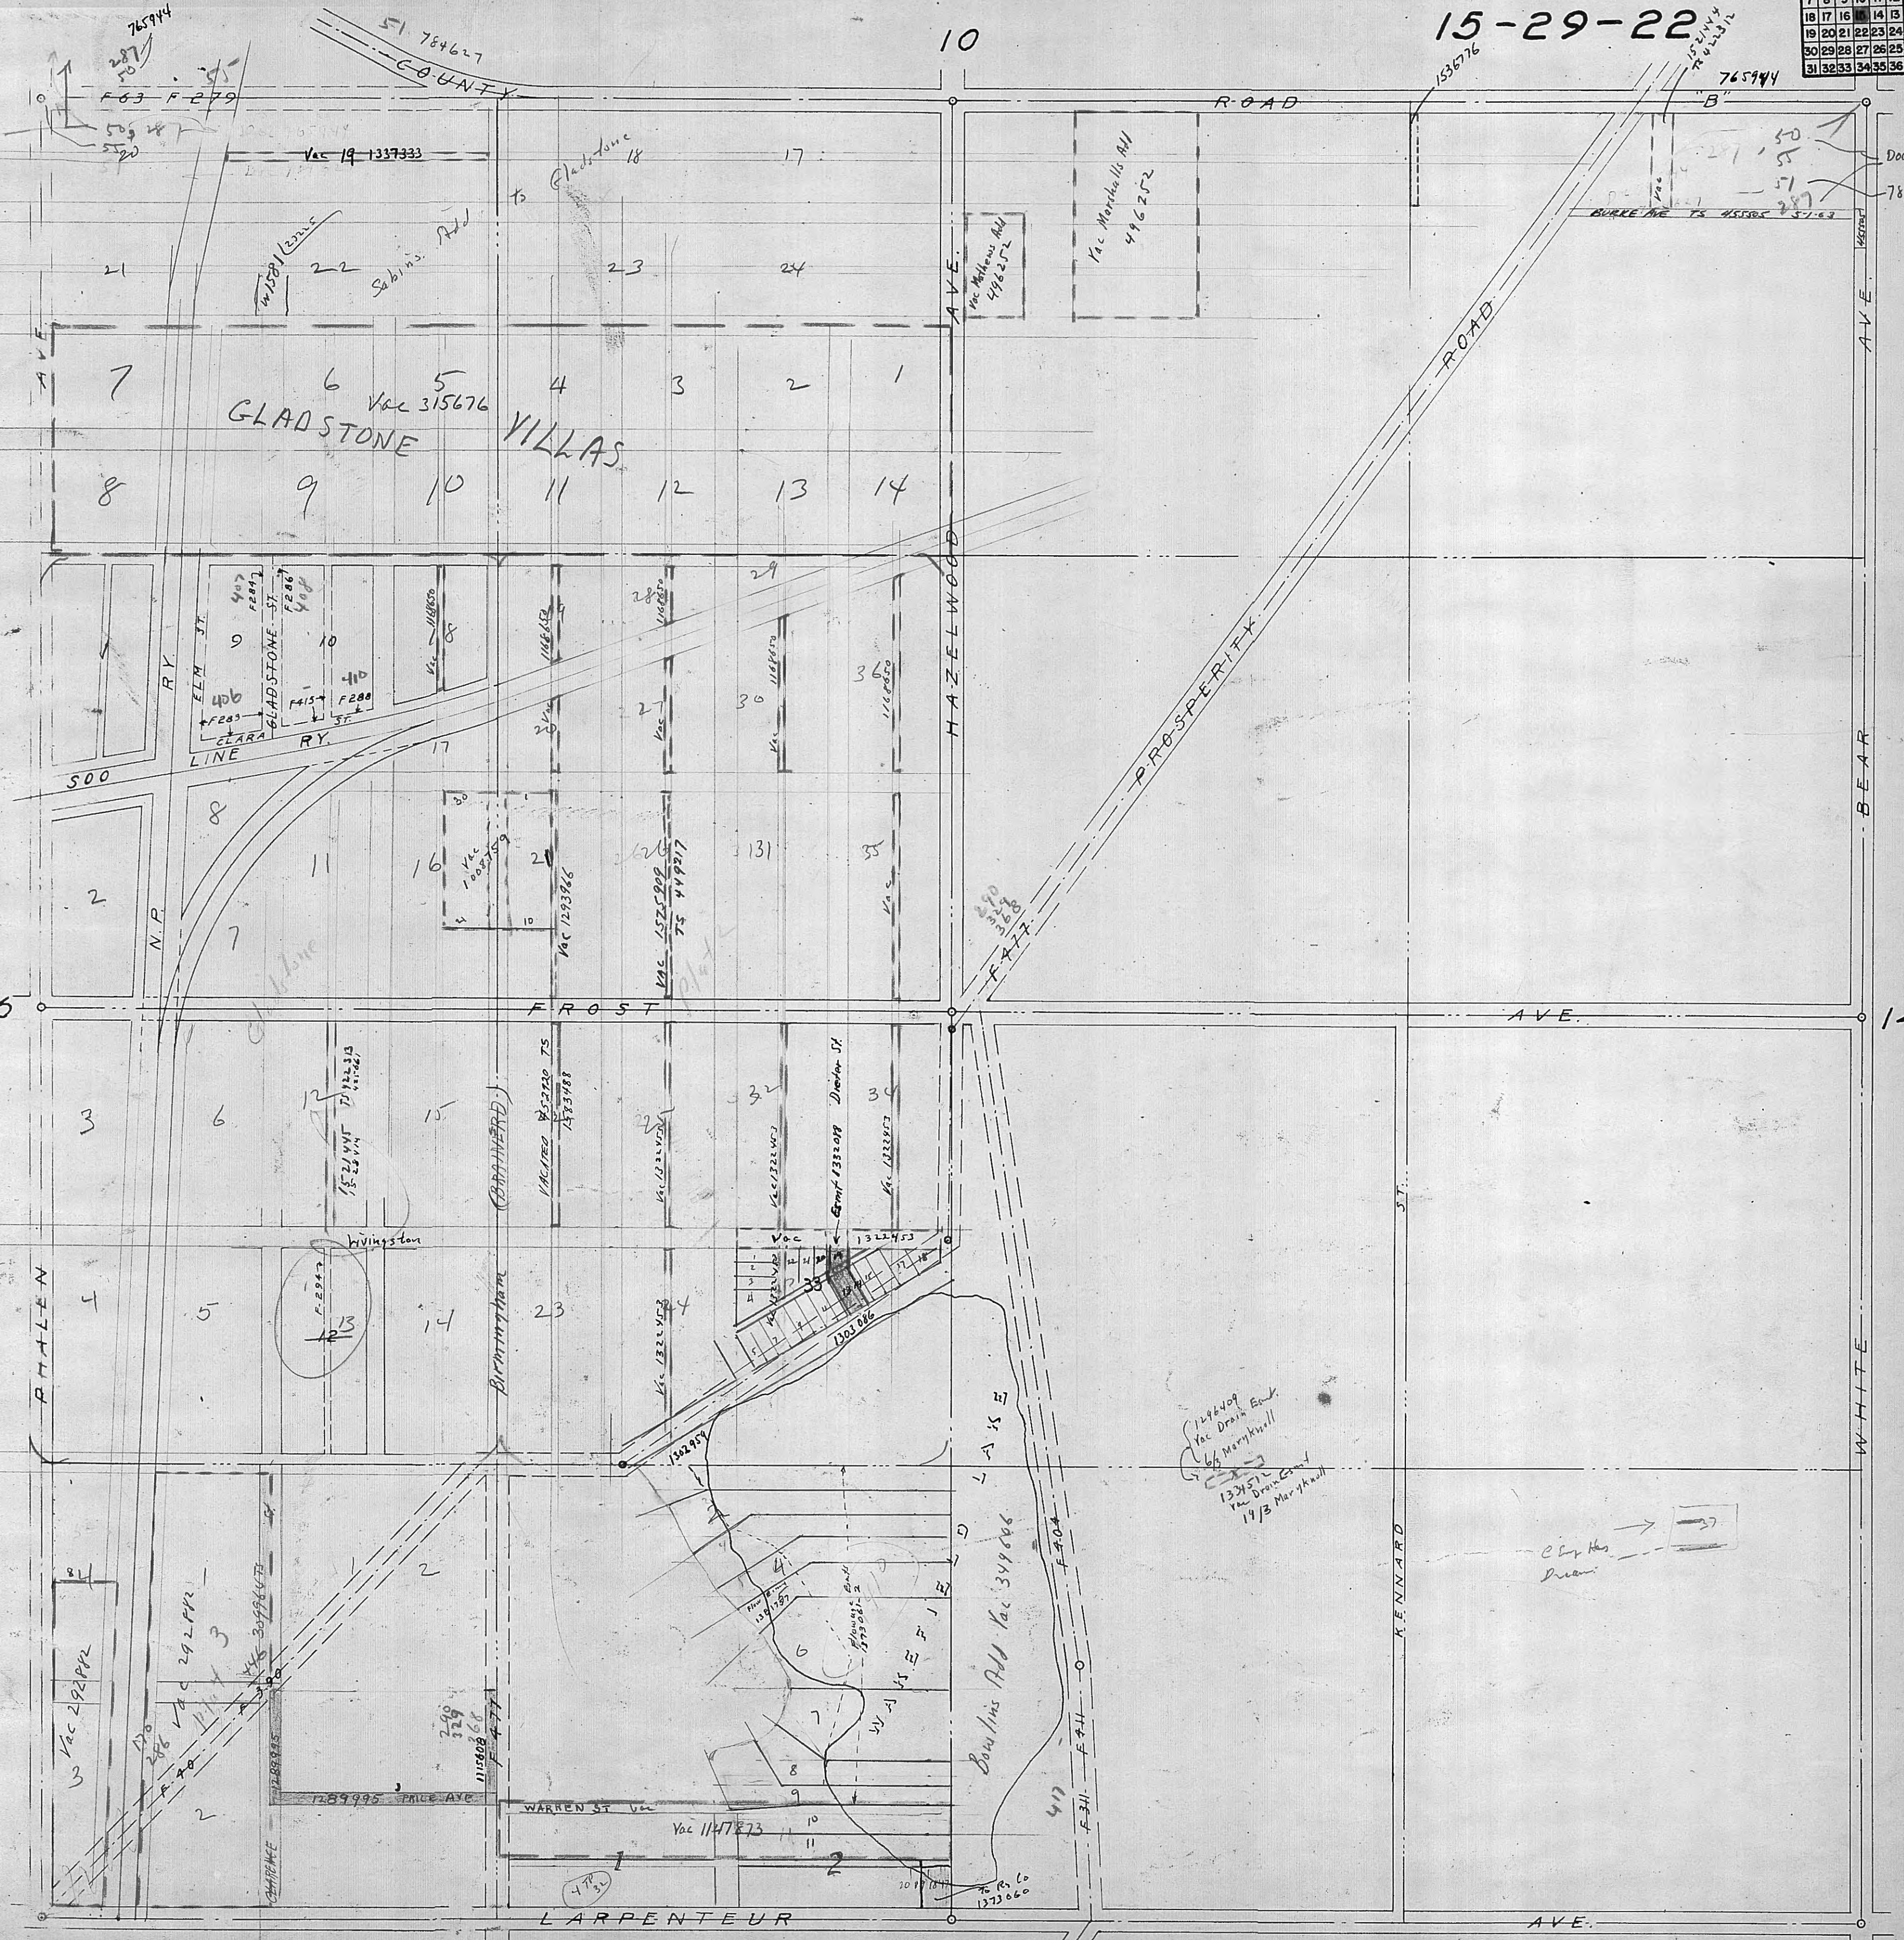

GLADSTONE VILLAS

PROSPERITY ROAD


FROST AVE


HAZELWOOD AVE

BEAR AVE

WHITE AVE

Vac 2926PR

Vac 2926PR

Vac 3099667A

Vac 11580866

WARREN ST Vac

Vac 1147873

Bowling Add Vac 349086

1248409  
Vac Drain  
166 Marshall  
133572  
Vac Drain Canal  
11/3 Marshall

City Has  
Drain