


16-29-22

6	5	4	3	2	1
7	8	9	10	11	12
13	14	15	16	17	18
19	20	21	22	23	24
25	26	27	28	29	30
31	32	33	34	35	36

See Sec. 10
For this
intersection

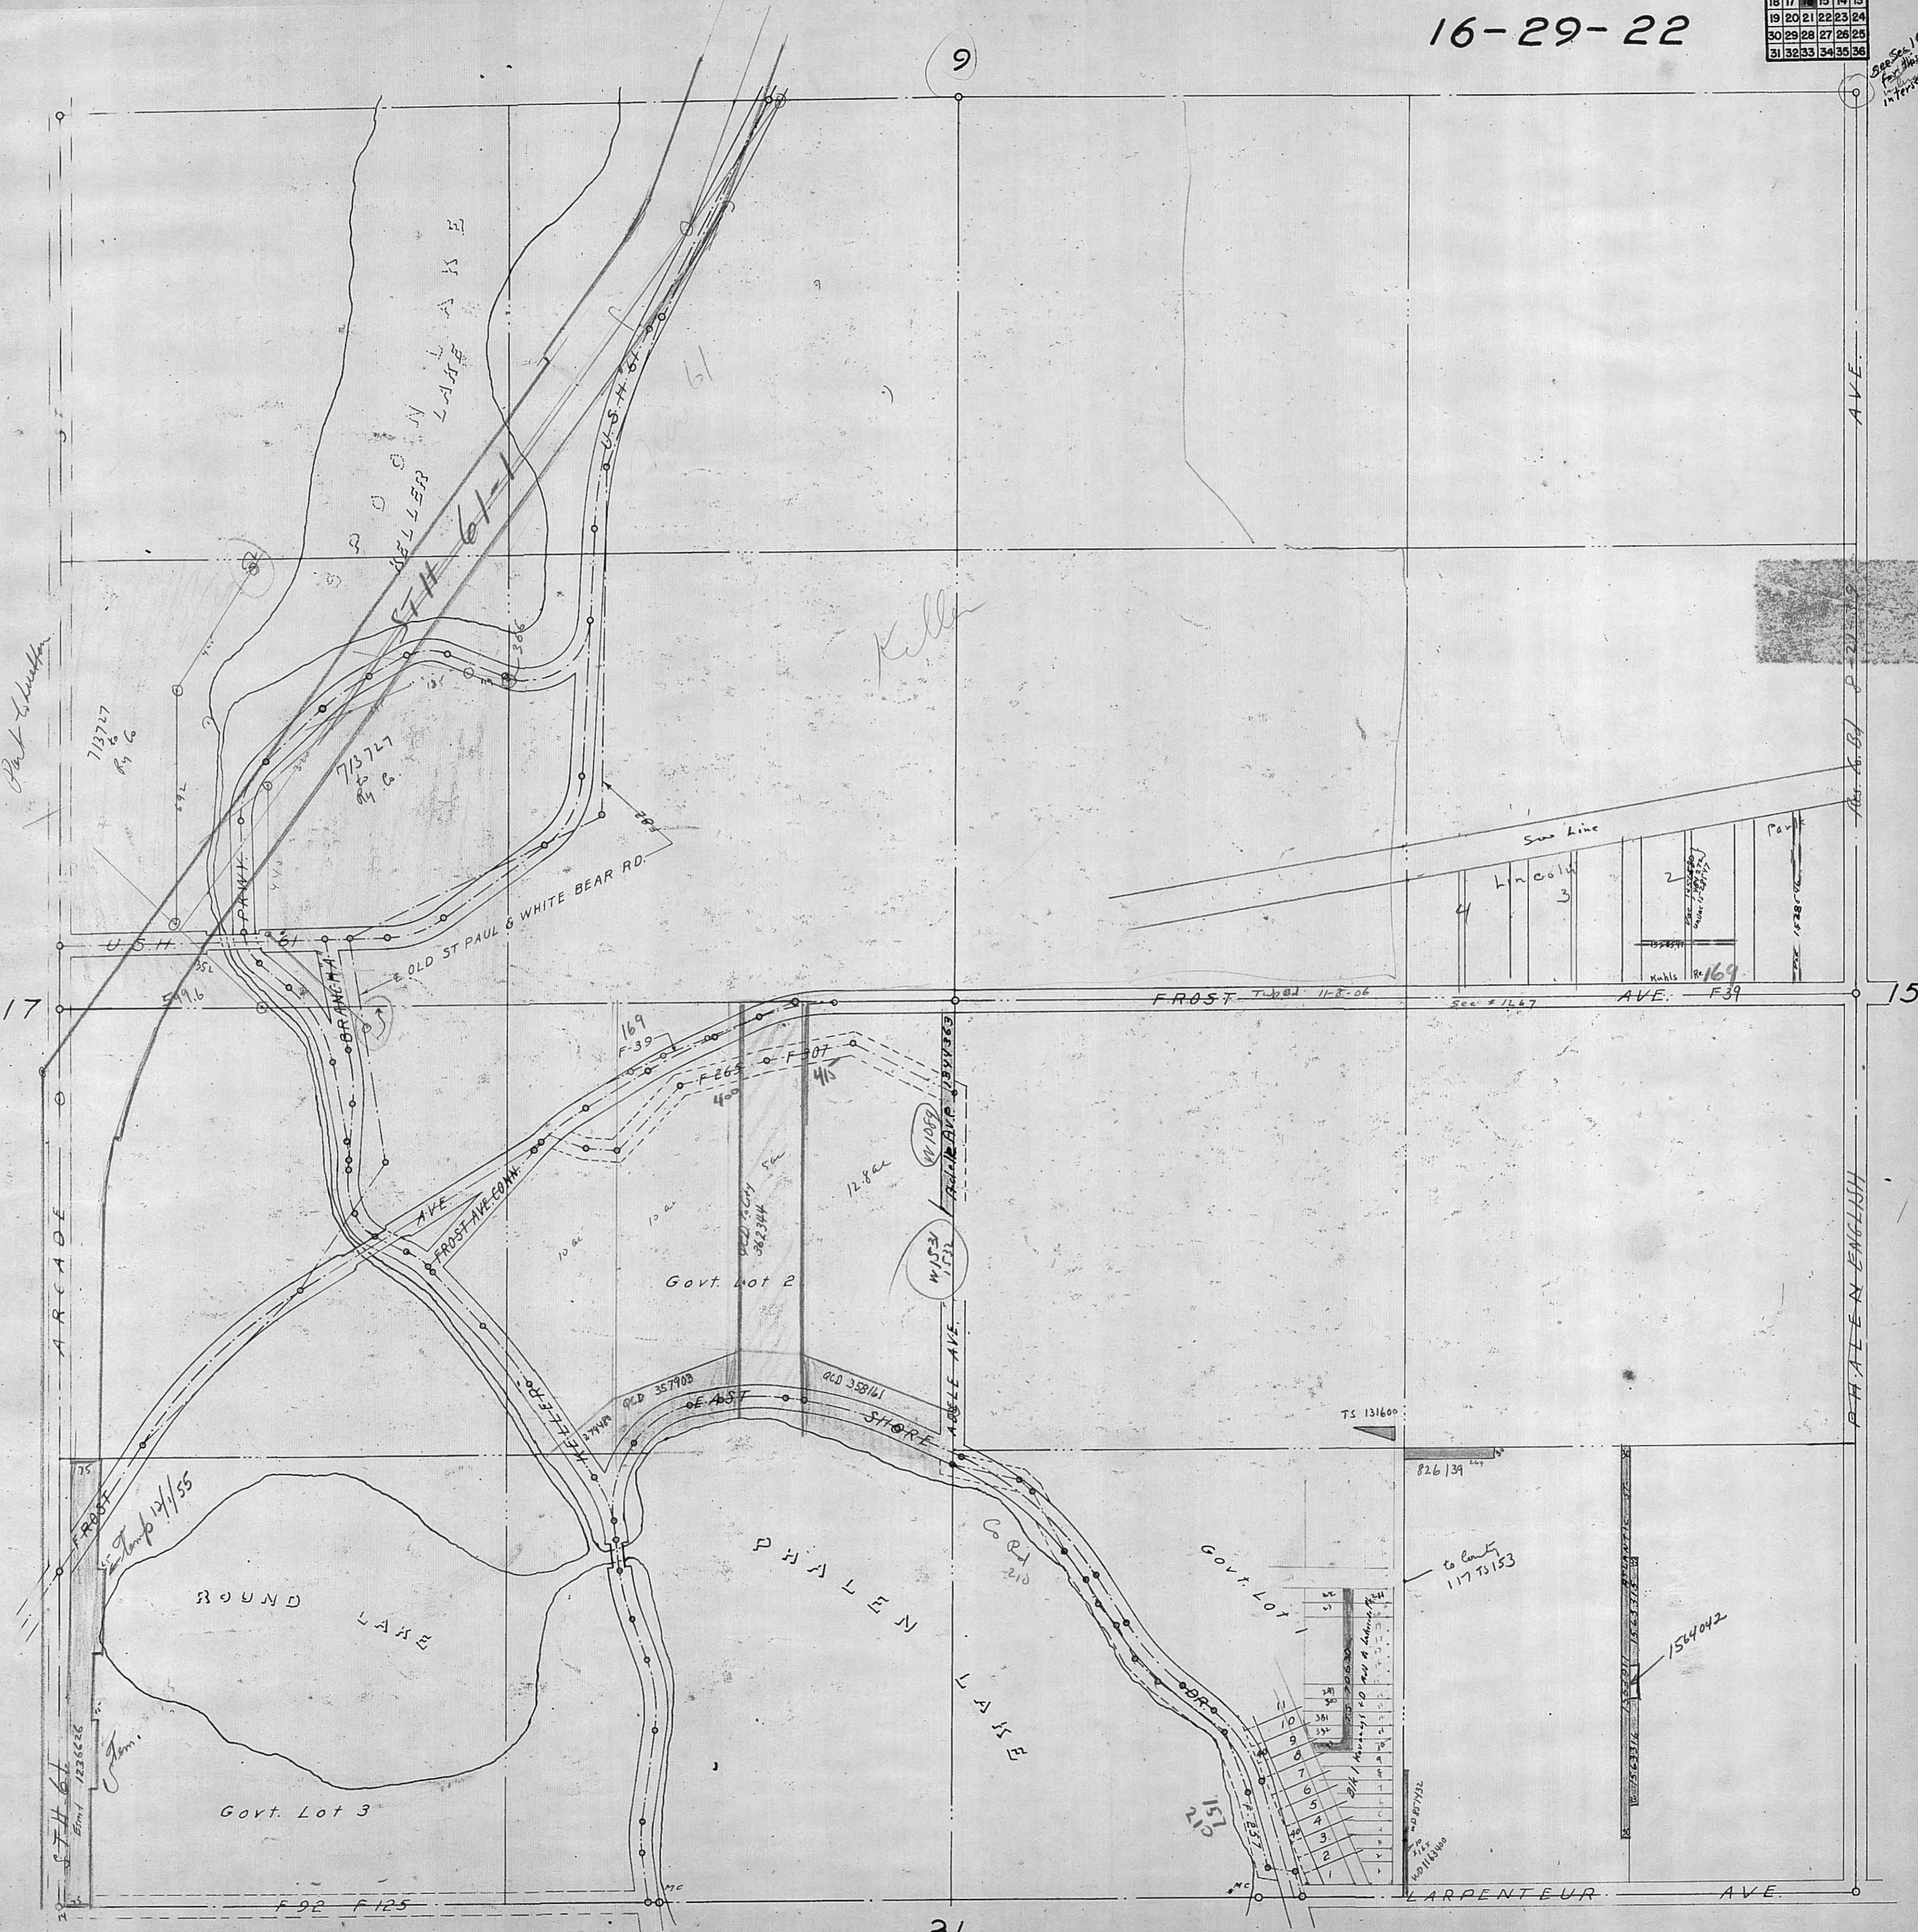

Part to location

Keller

713727
R.S. G.

713727
R.S. G.

549.6

169
F-39

F-65

F-07

40°

12.800

Govt. Lot 2

OLD 357903

E. 45° 30'

OLD 358161

SHORE

TS 131600

826.139

to center
117 TS 153

1564042

STH 61
Elev. 1236226

Govt. Lot 3

PHALEN
LAKE

MOBILE AVE.

GOVT. LOT 1

COURT ST

LARPEN TEUR AVE.

21