


17-29-22

6	5	4	3	2	1
7	8	9	10	11	12
13	14	15	16	17	18
19	20	21	22	23	24
25	26	27	28	29	30
31	32	33	34	35	36

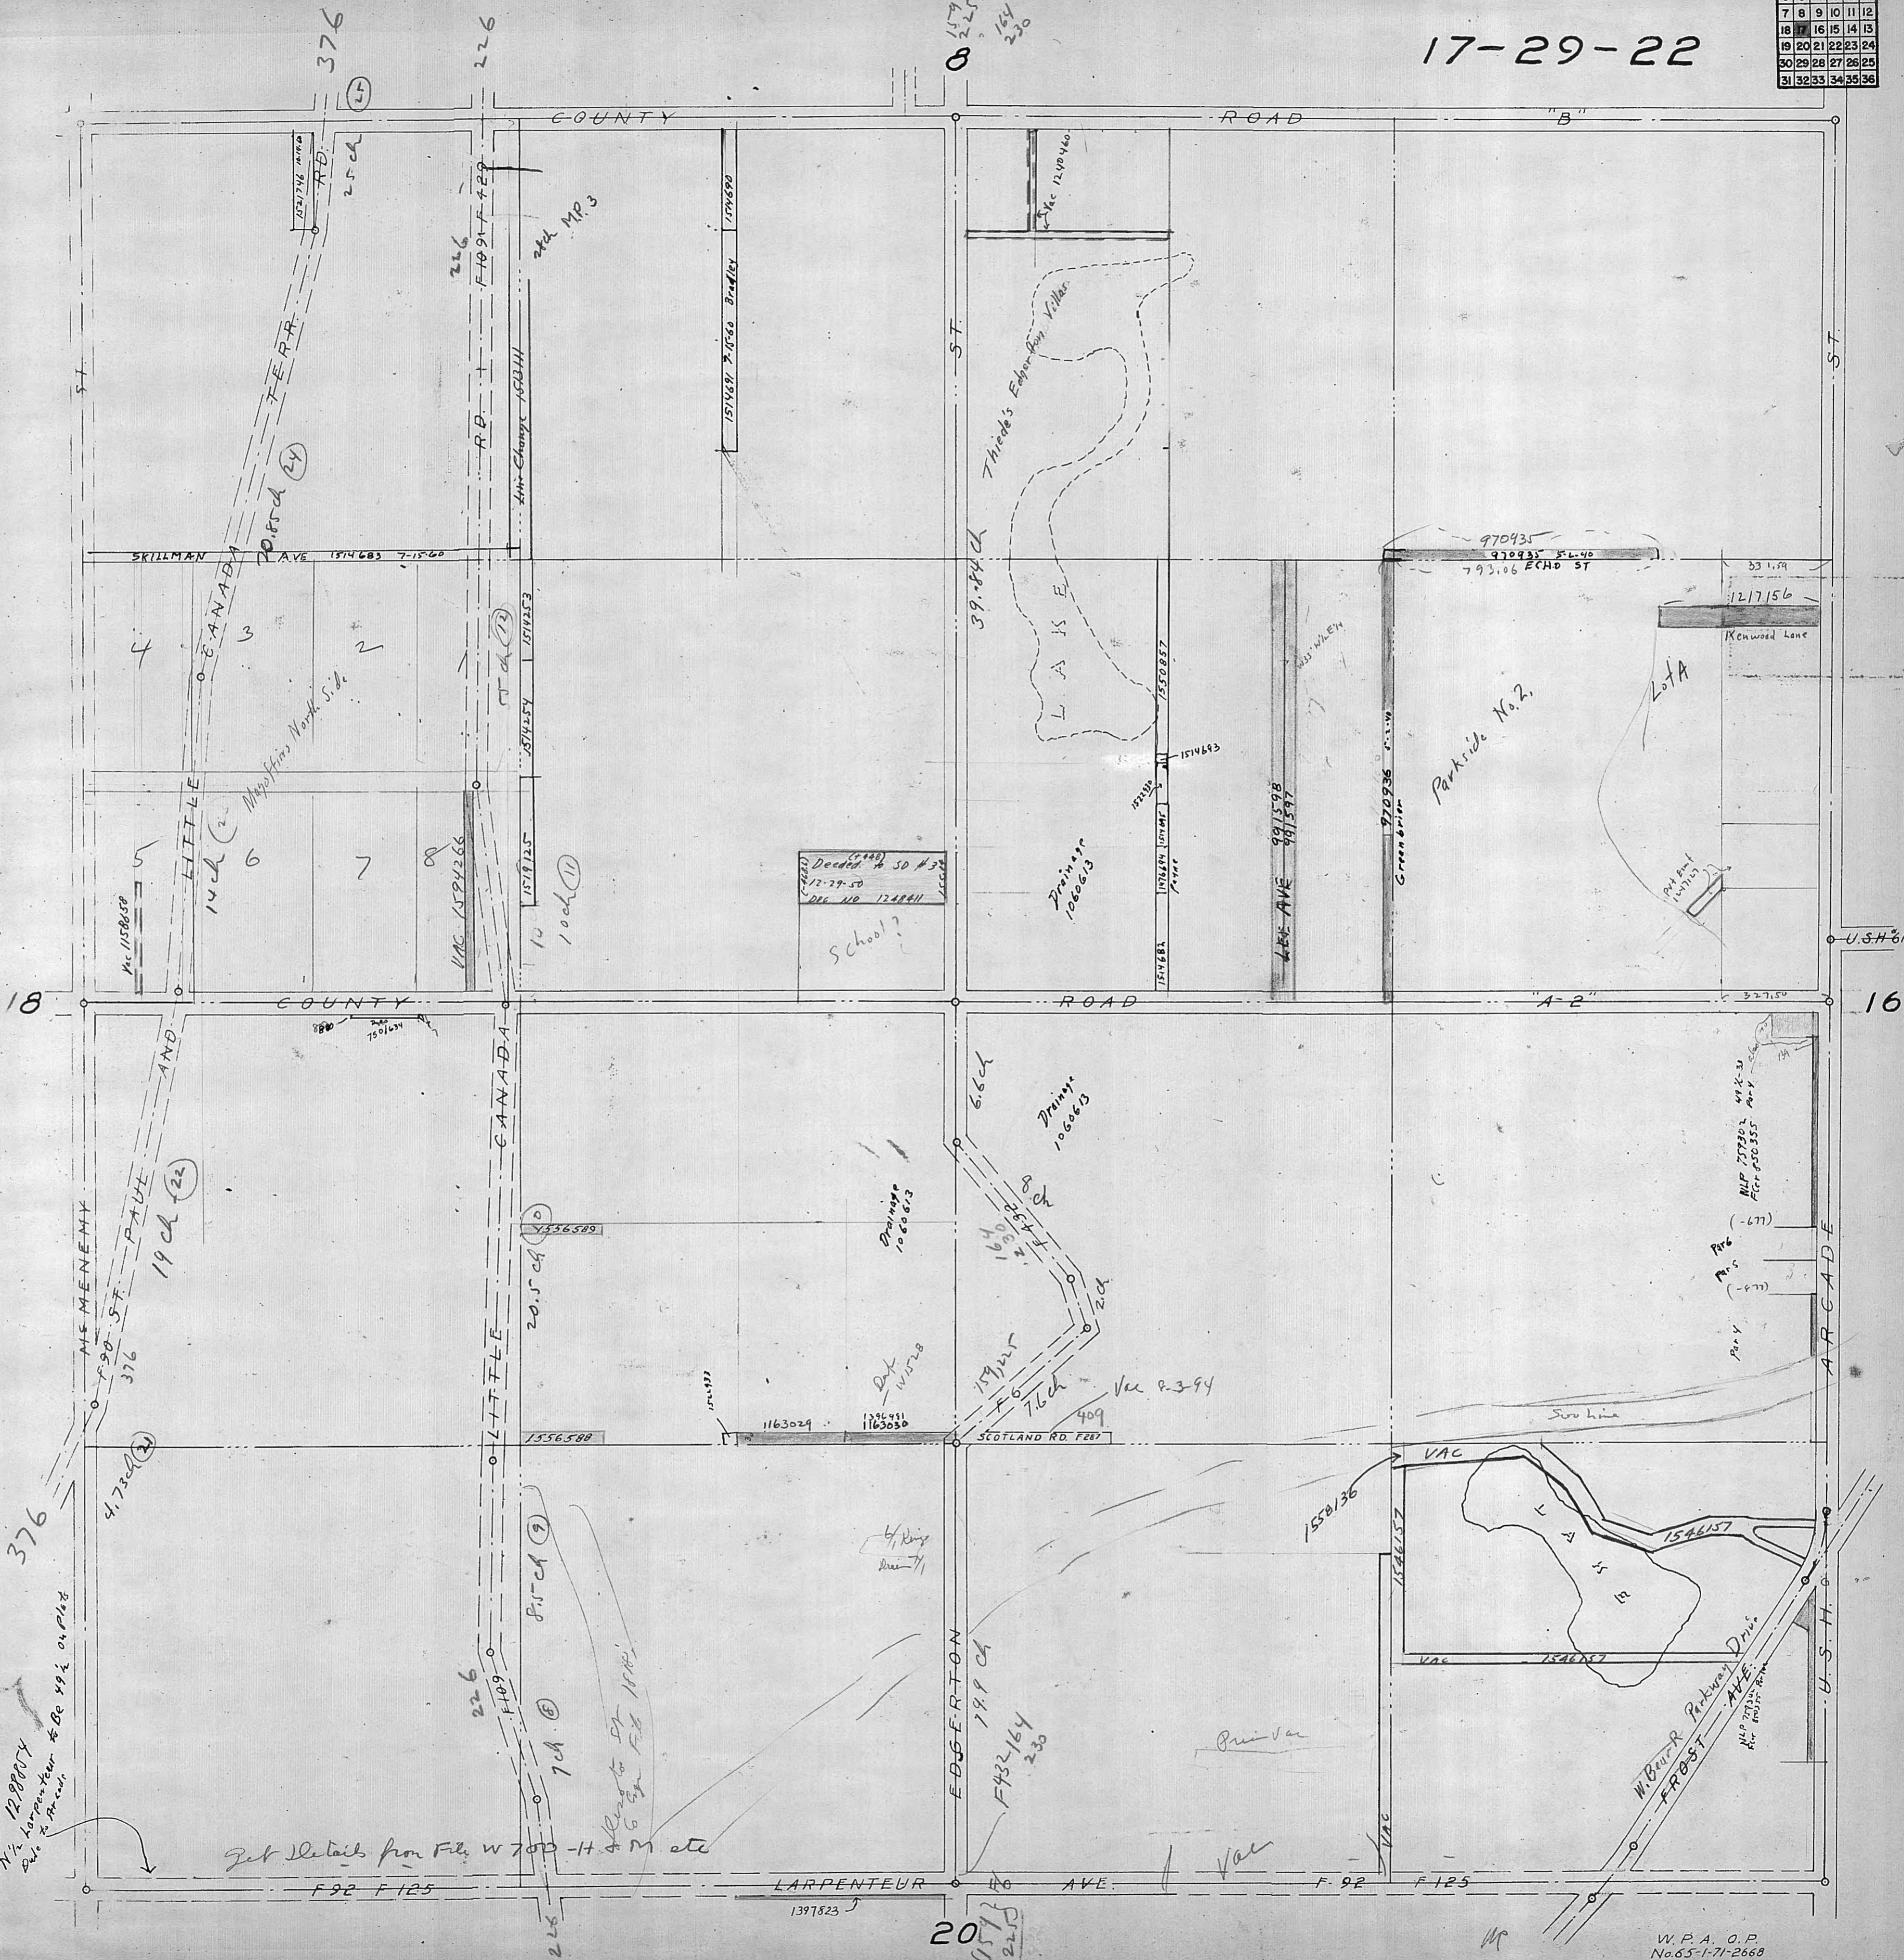

(448)
 Decided to SD #3
 12-29-50
 Dec No 1248411

1163029
 1163030

MAP 259302 492-31
 FIG. 250355
 (671)
 (67)
 (67)

Get details from File W 700-H & M etc

1298074
 1/2 Corporation to be 59 1/2 on Plat
 due to Proceed