


6	5	4	3	2	1
7	8	9	10	11	12
13	14	15	16	17	18
19	20	21	22	23	24
25	26	27	28	29	30
31	32	33	34	35	36

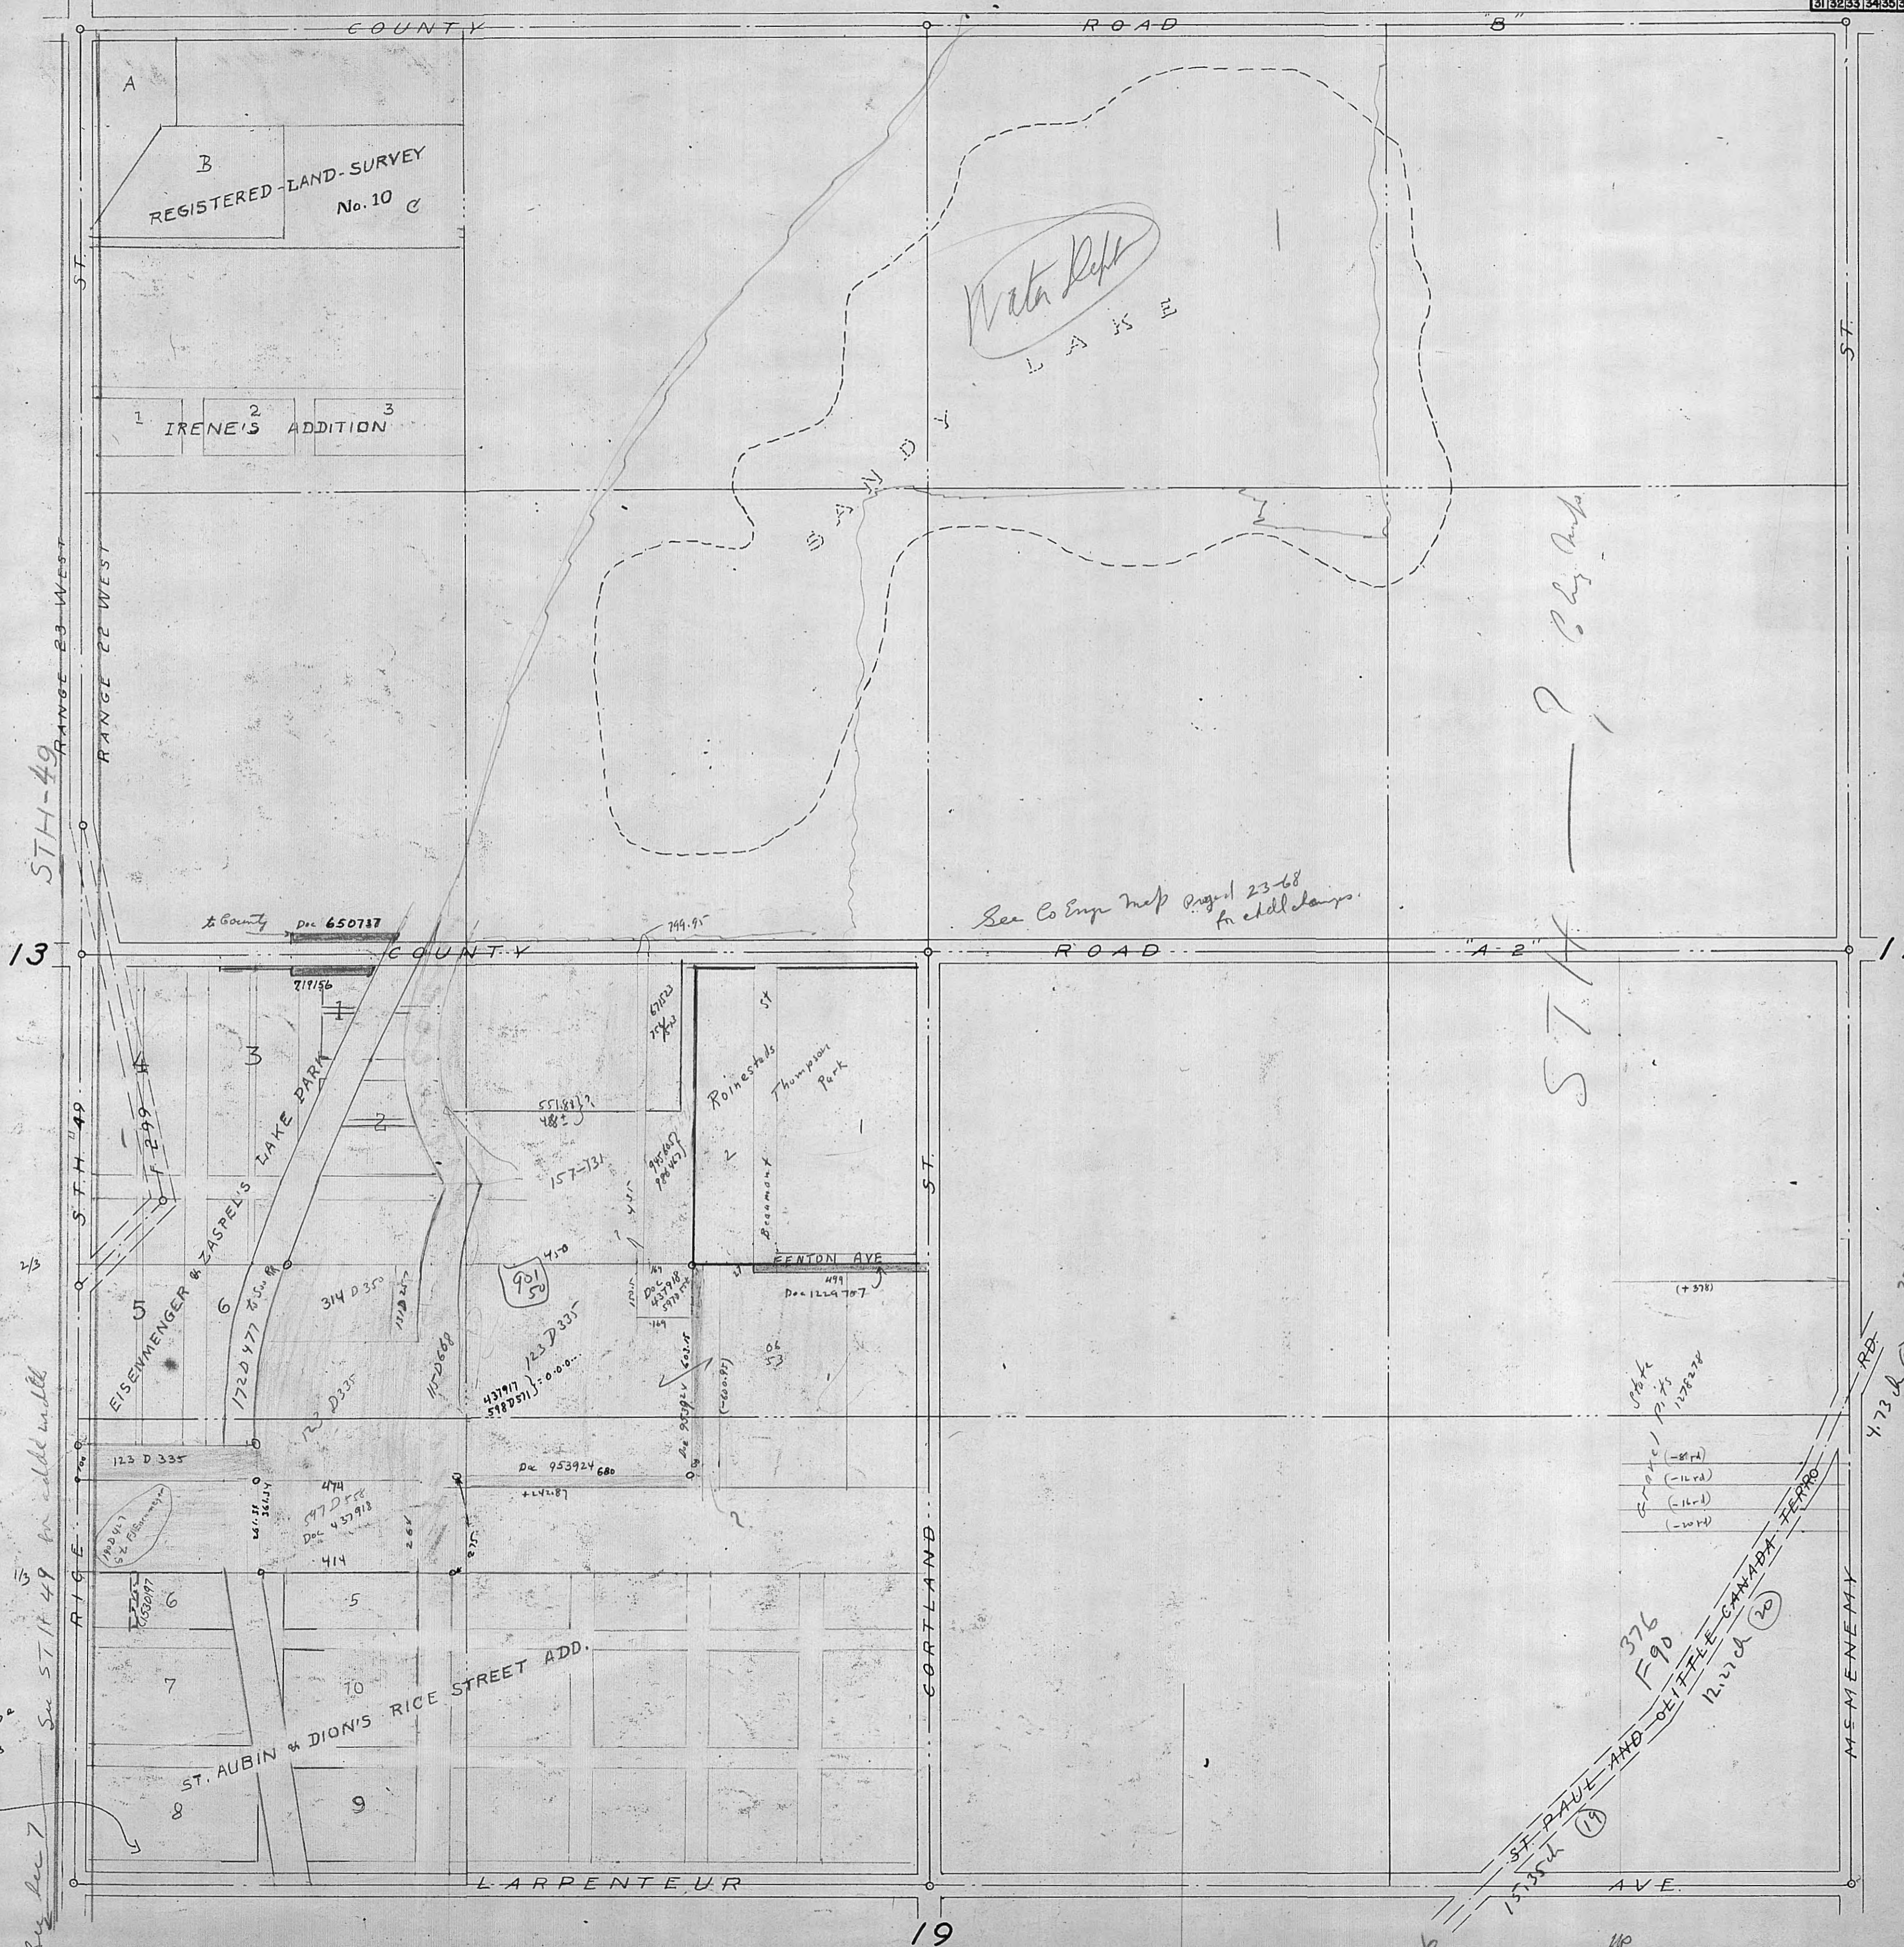

B REGISTERED LAND SURVEY No. 10

IRENE'S ADDITION

Water Refill LAKE

STH-49

13

17

See Co Eng map Proj 23-68 for chd clamps.

ST. 175

See STH 49 for chd clamps

1298854
N² Harper Ave to be
4 1/2 feet on plat
Date to Arcade

376
F 90
12.27 d (20)

376
F 90

ST. PAUL AND LITTLE CANADA FERRO
12.27 d (20)