


6	5	4	3	2	1
7	8	9	10	11	12
13	14	15	16	17	18
19	20	21	22	23	24
25	26	27	28	29	30
31	32	33	34	35	36

23	24
26	25

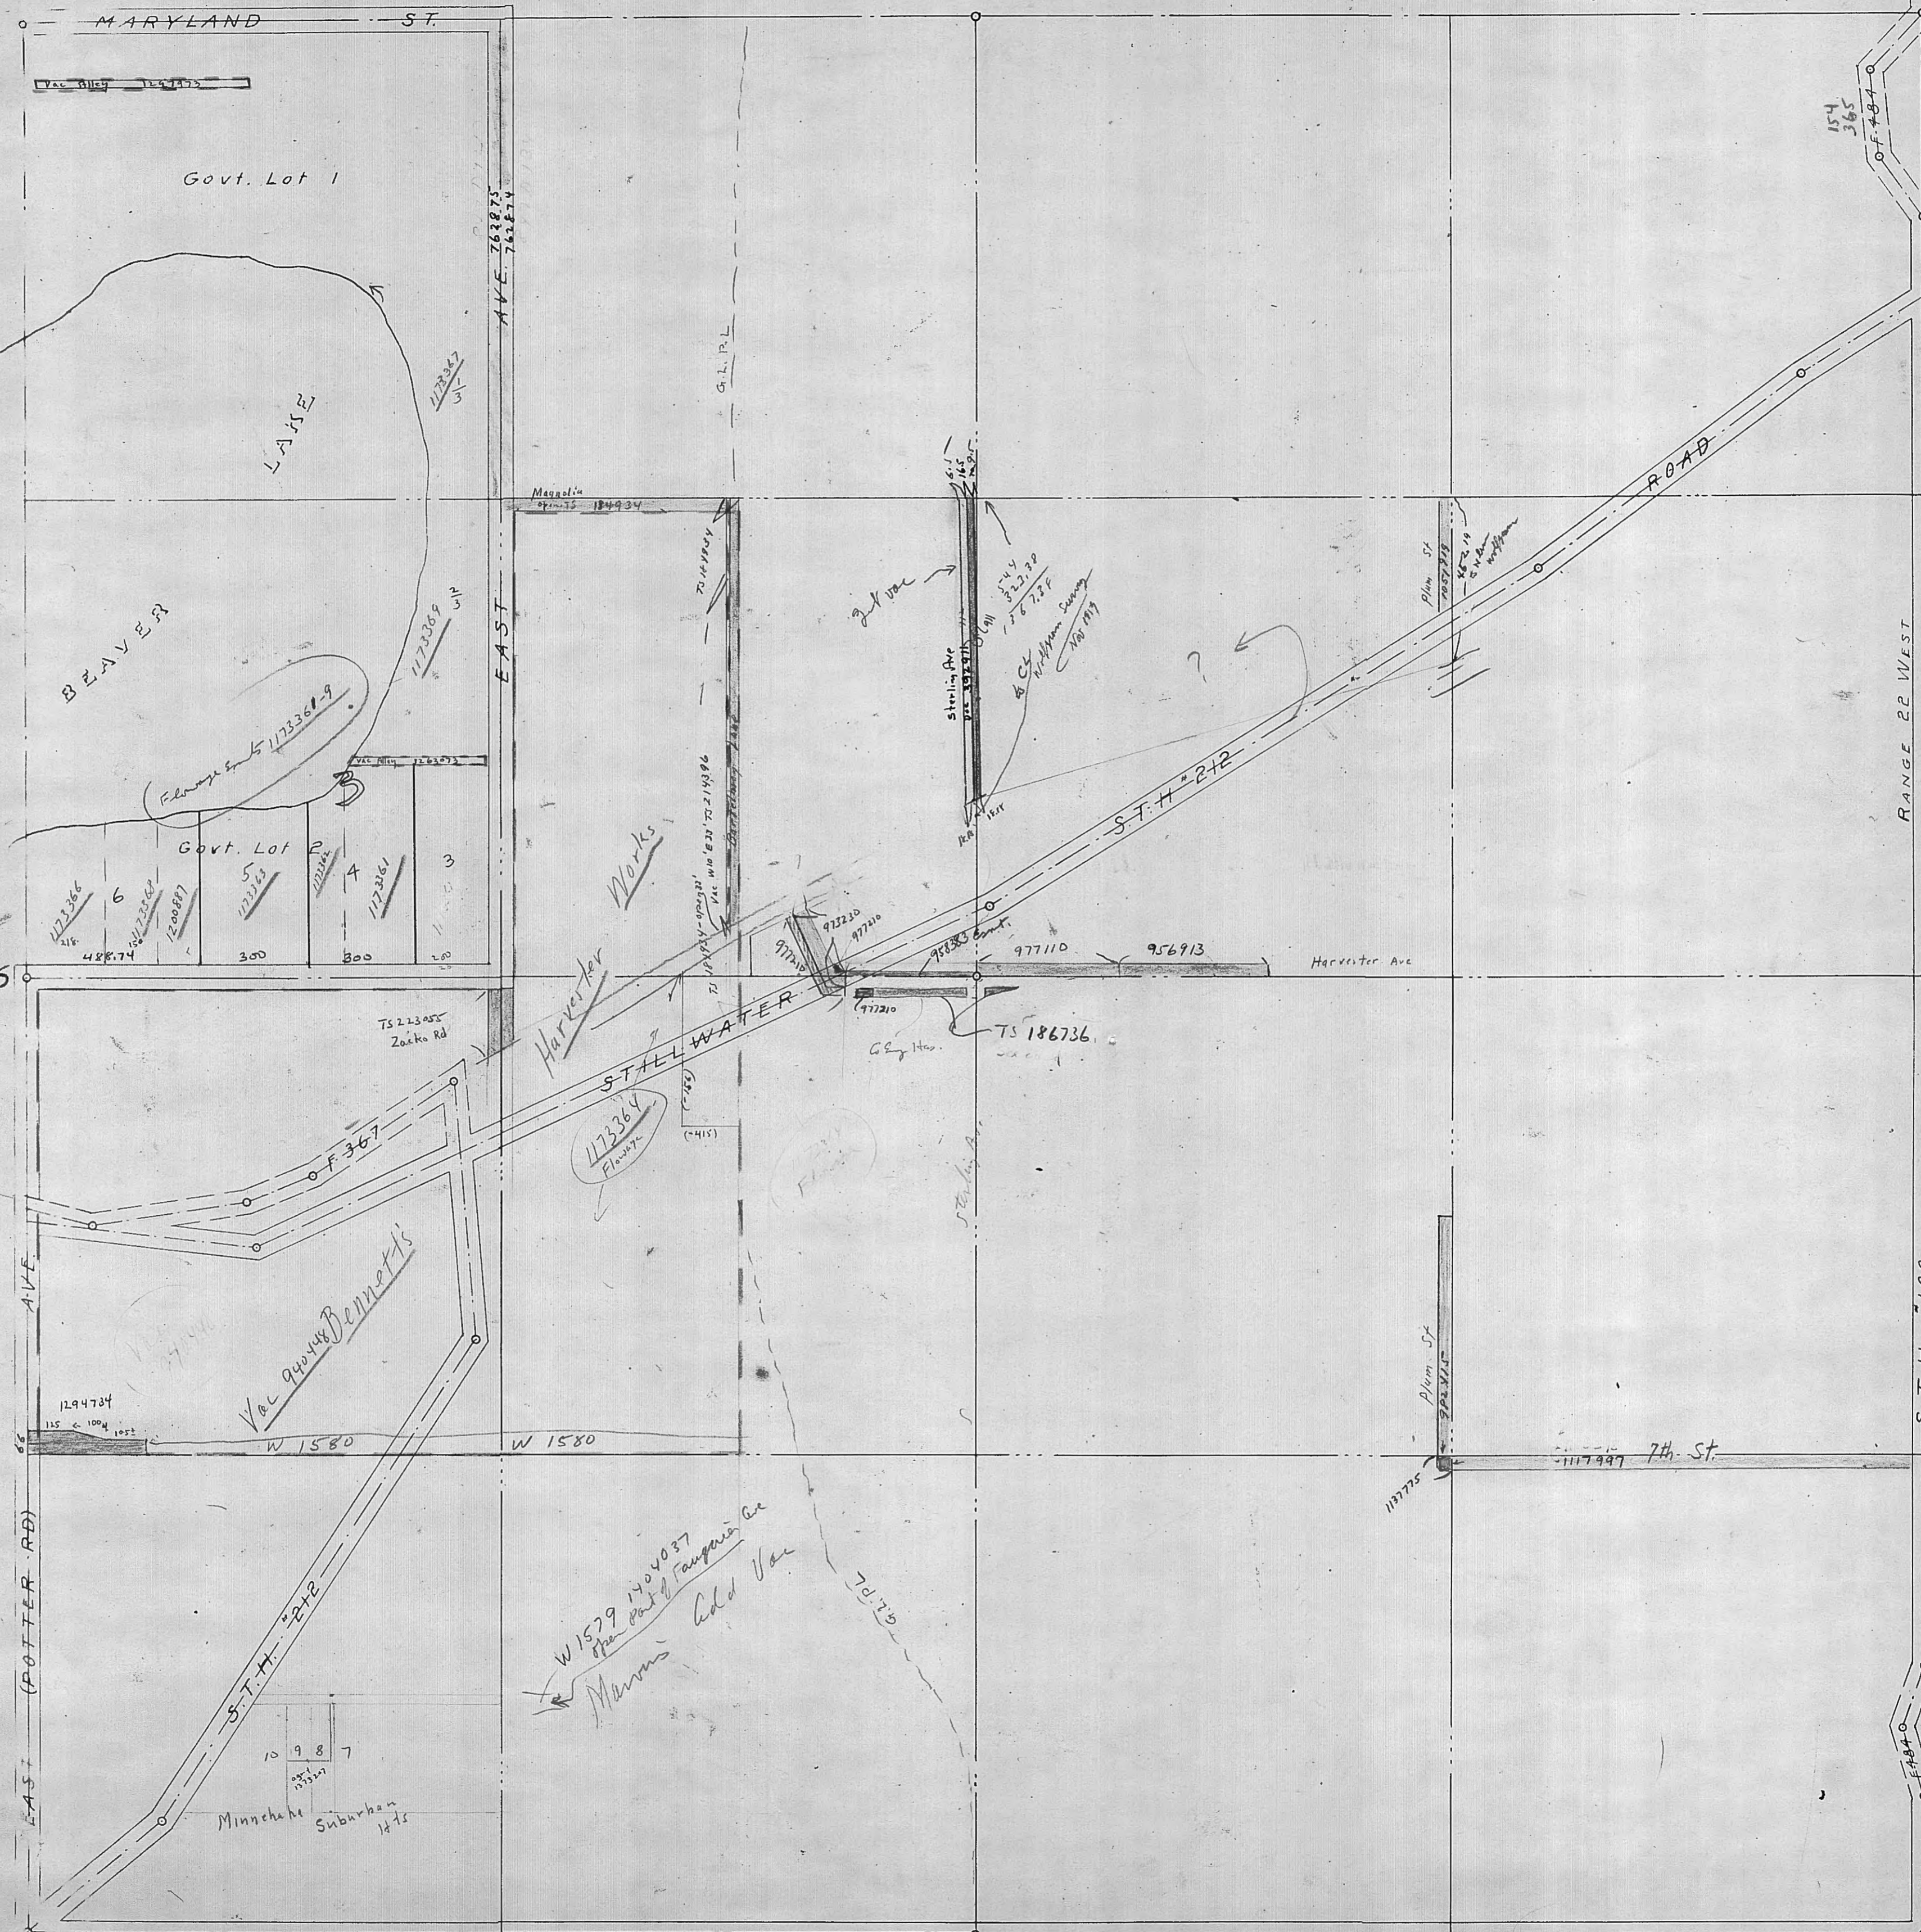

GL 3
5-22

5-30-23

26	25
35	36

25
36