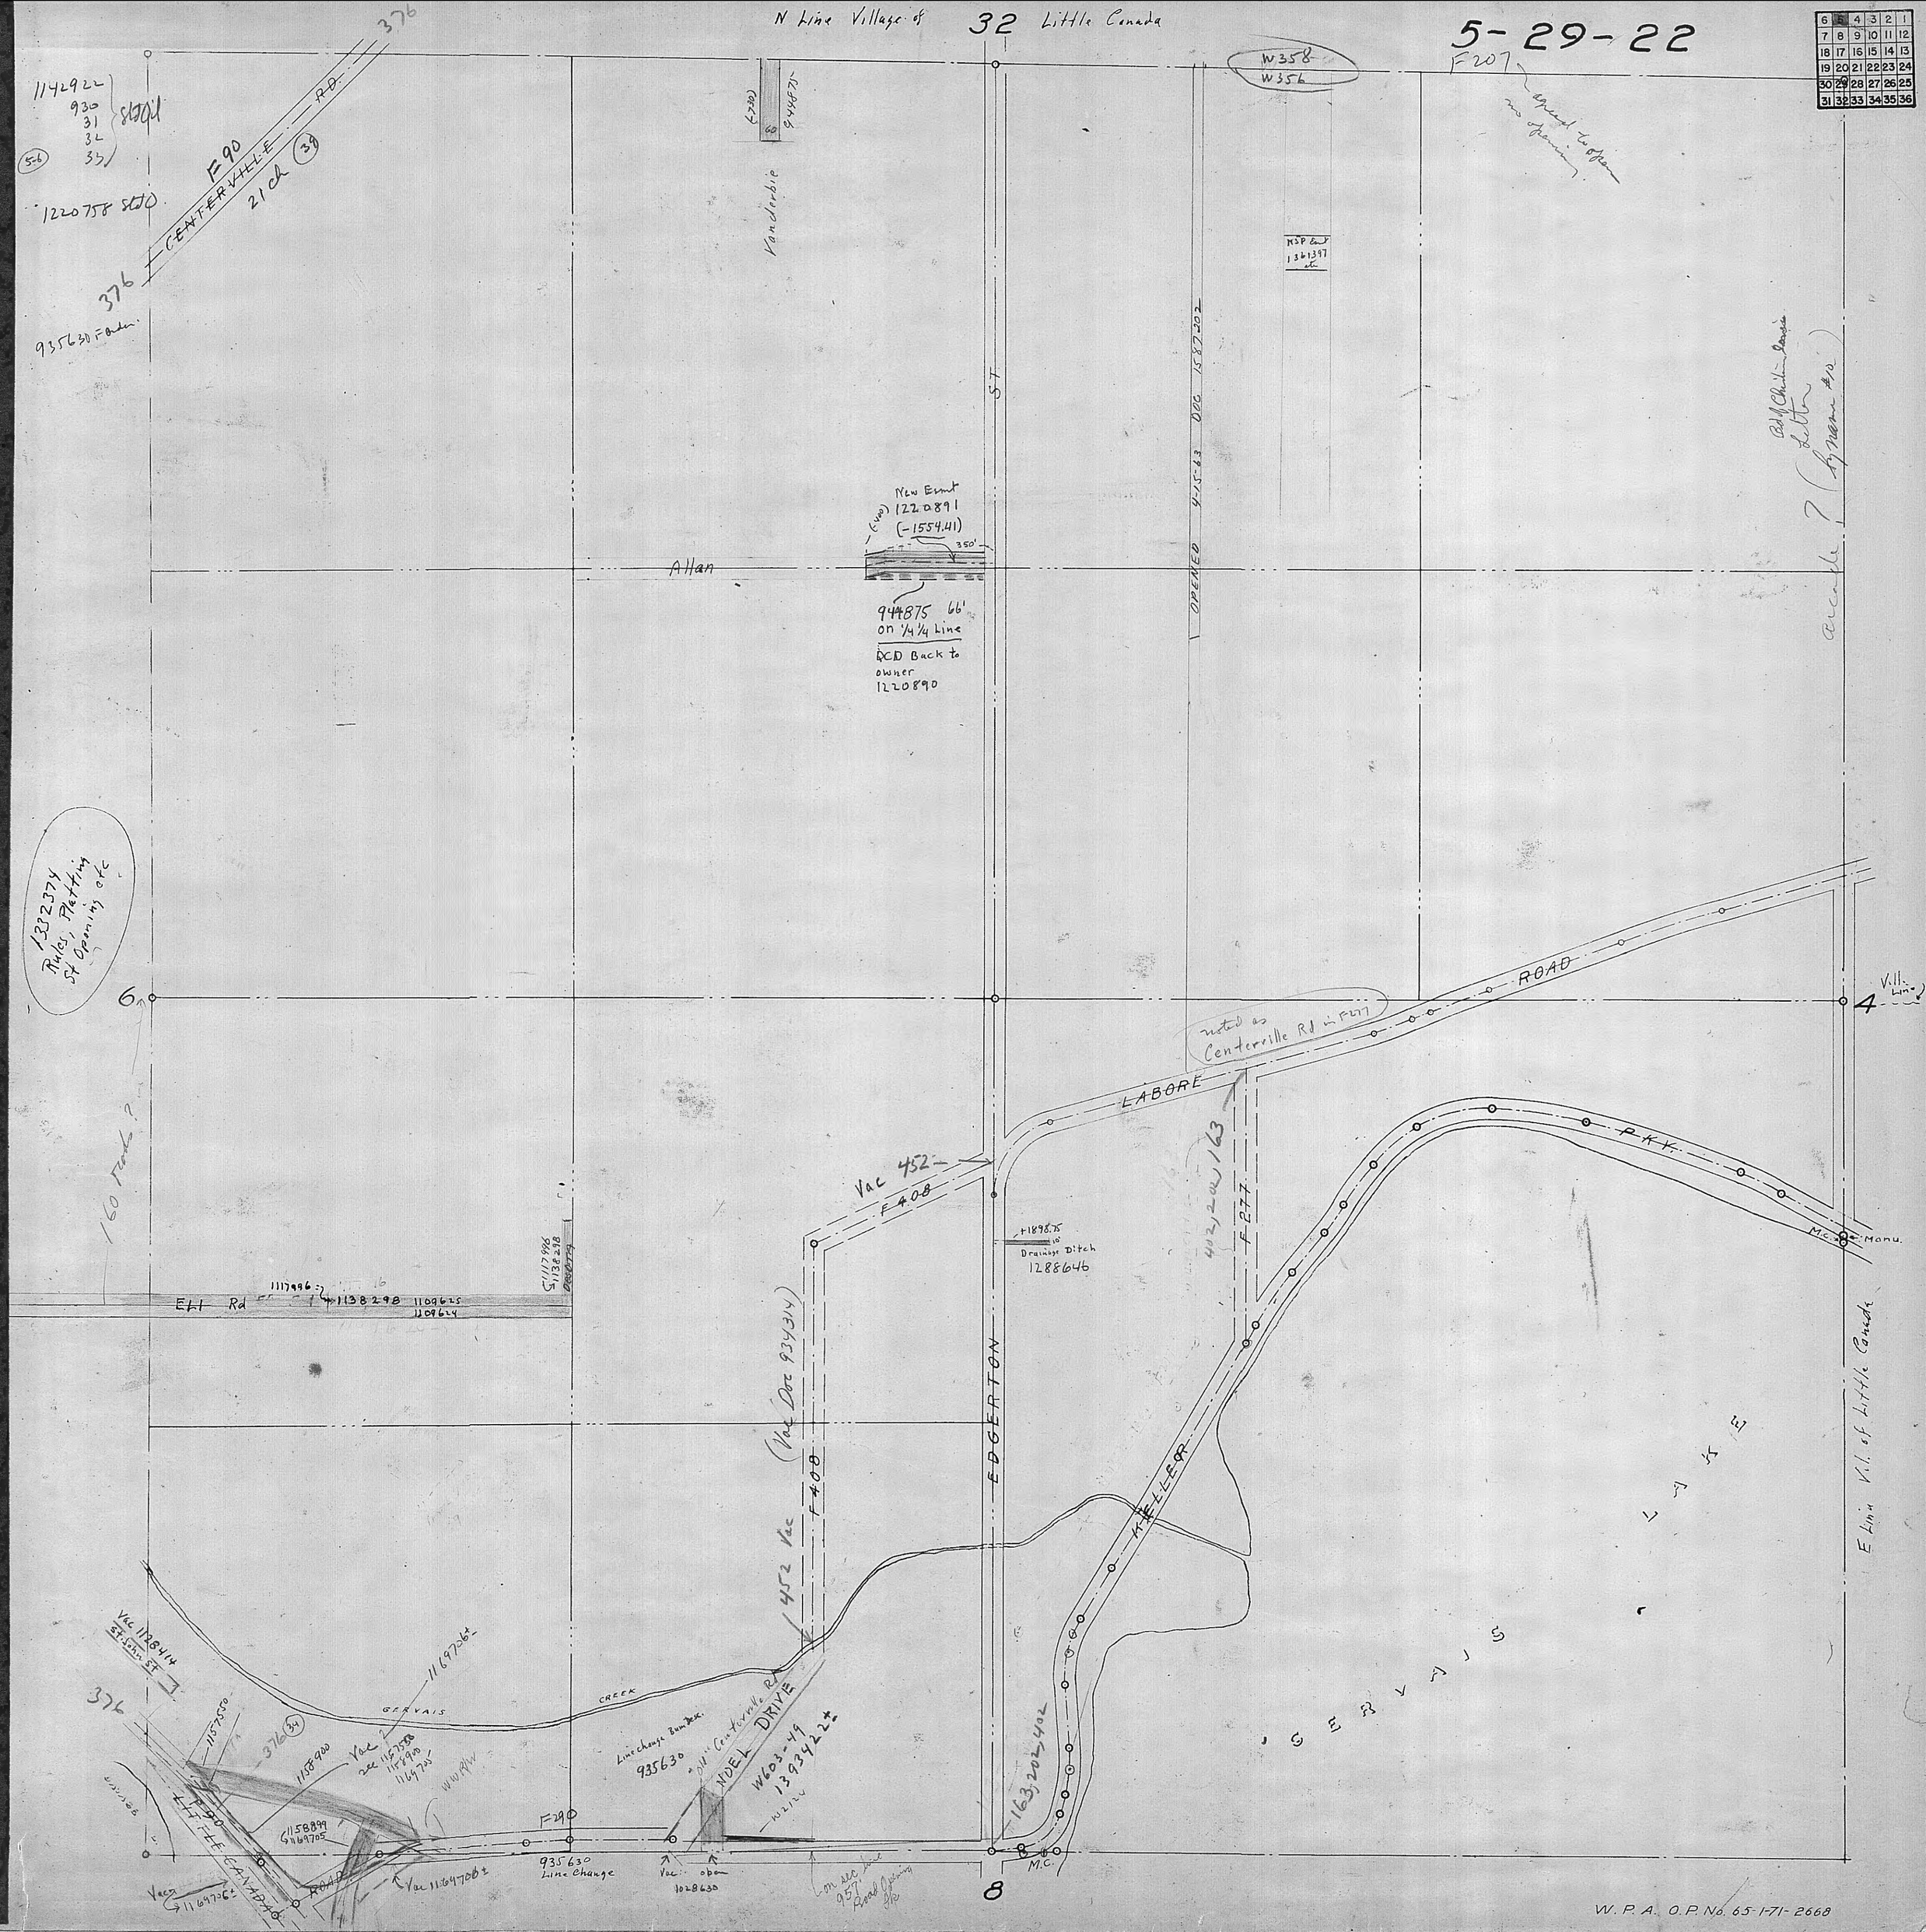

N Line Village of 32 Little Canada
5-29-22
F207
W358
W356
1142922
930
31
32
33
F90
CENTERVILLE RD
21 ch
376
1220758 Std
935630 Fender
Vanderbie
ST
OPENED 4-15-63 DOC 1587202
New Esmt
1220891
(-1554.41)
350'
Allan
944875 66'
on 1/4 1/4 Line
DCD Back to owner
1220890
1332374
Rules, Platting
St Opening etc
6
4
noted as Centerville Rd in F277
LABORE
ROAD
PKY
Vac 452
F408
Drainage Ditch
1288646
F277
Ell Rd
1138298
1109625
1109624
EDGERTON
KELLER
GERVAIS
CREEK
NOEL DRIVE
W603-49
1393422±
935630
Line Change
Vac 1128414
St John St
LITTLE CANADA
ROAD
F290
8
M.C.
E Line Vil. of Little Canada
W.P.A. O.P. No. 65-1-71-2668