

6	5	4	3	2	1
7	8	9	10	11	12
13	14	15	16	17	18
19	20	21	22	23	24
25	26	27	28	29	30
31	32	33	34	35	36


9-29-22

4

COUNTY ROAD

S.F.H. "36"

6-8-198

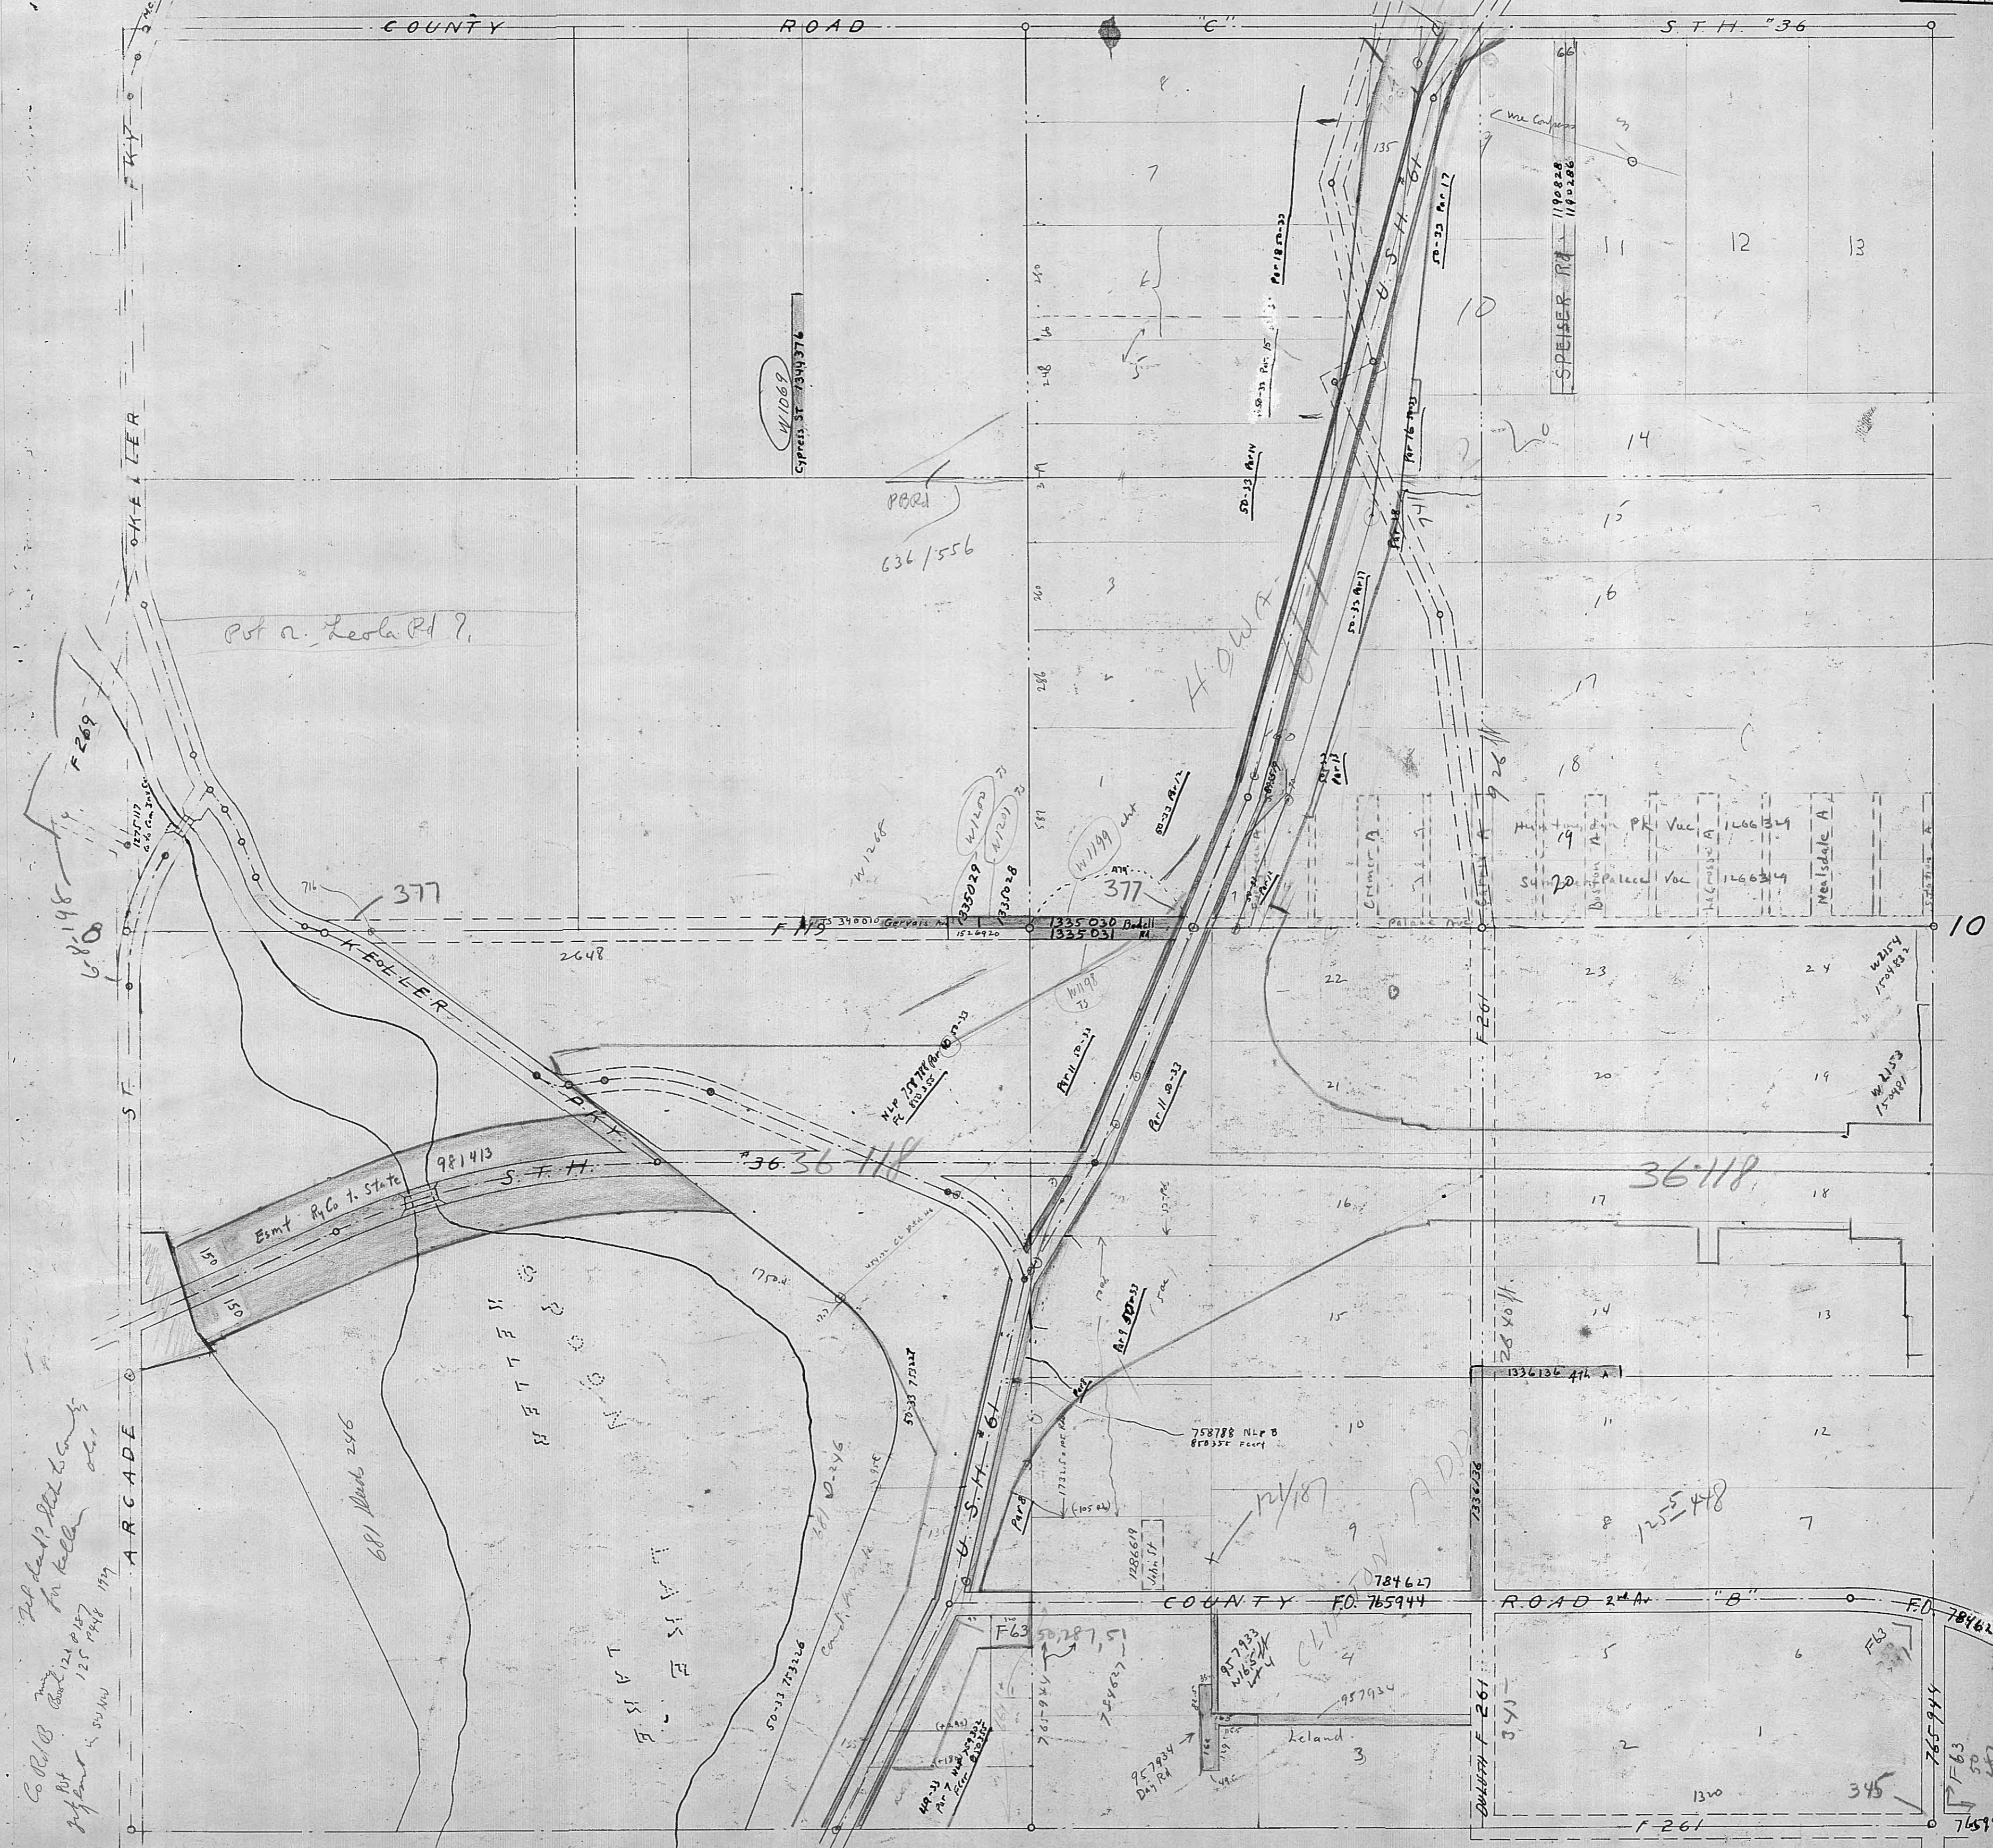

Co Rd 13  
 125 124 125 124 125 124  
