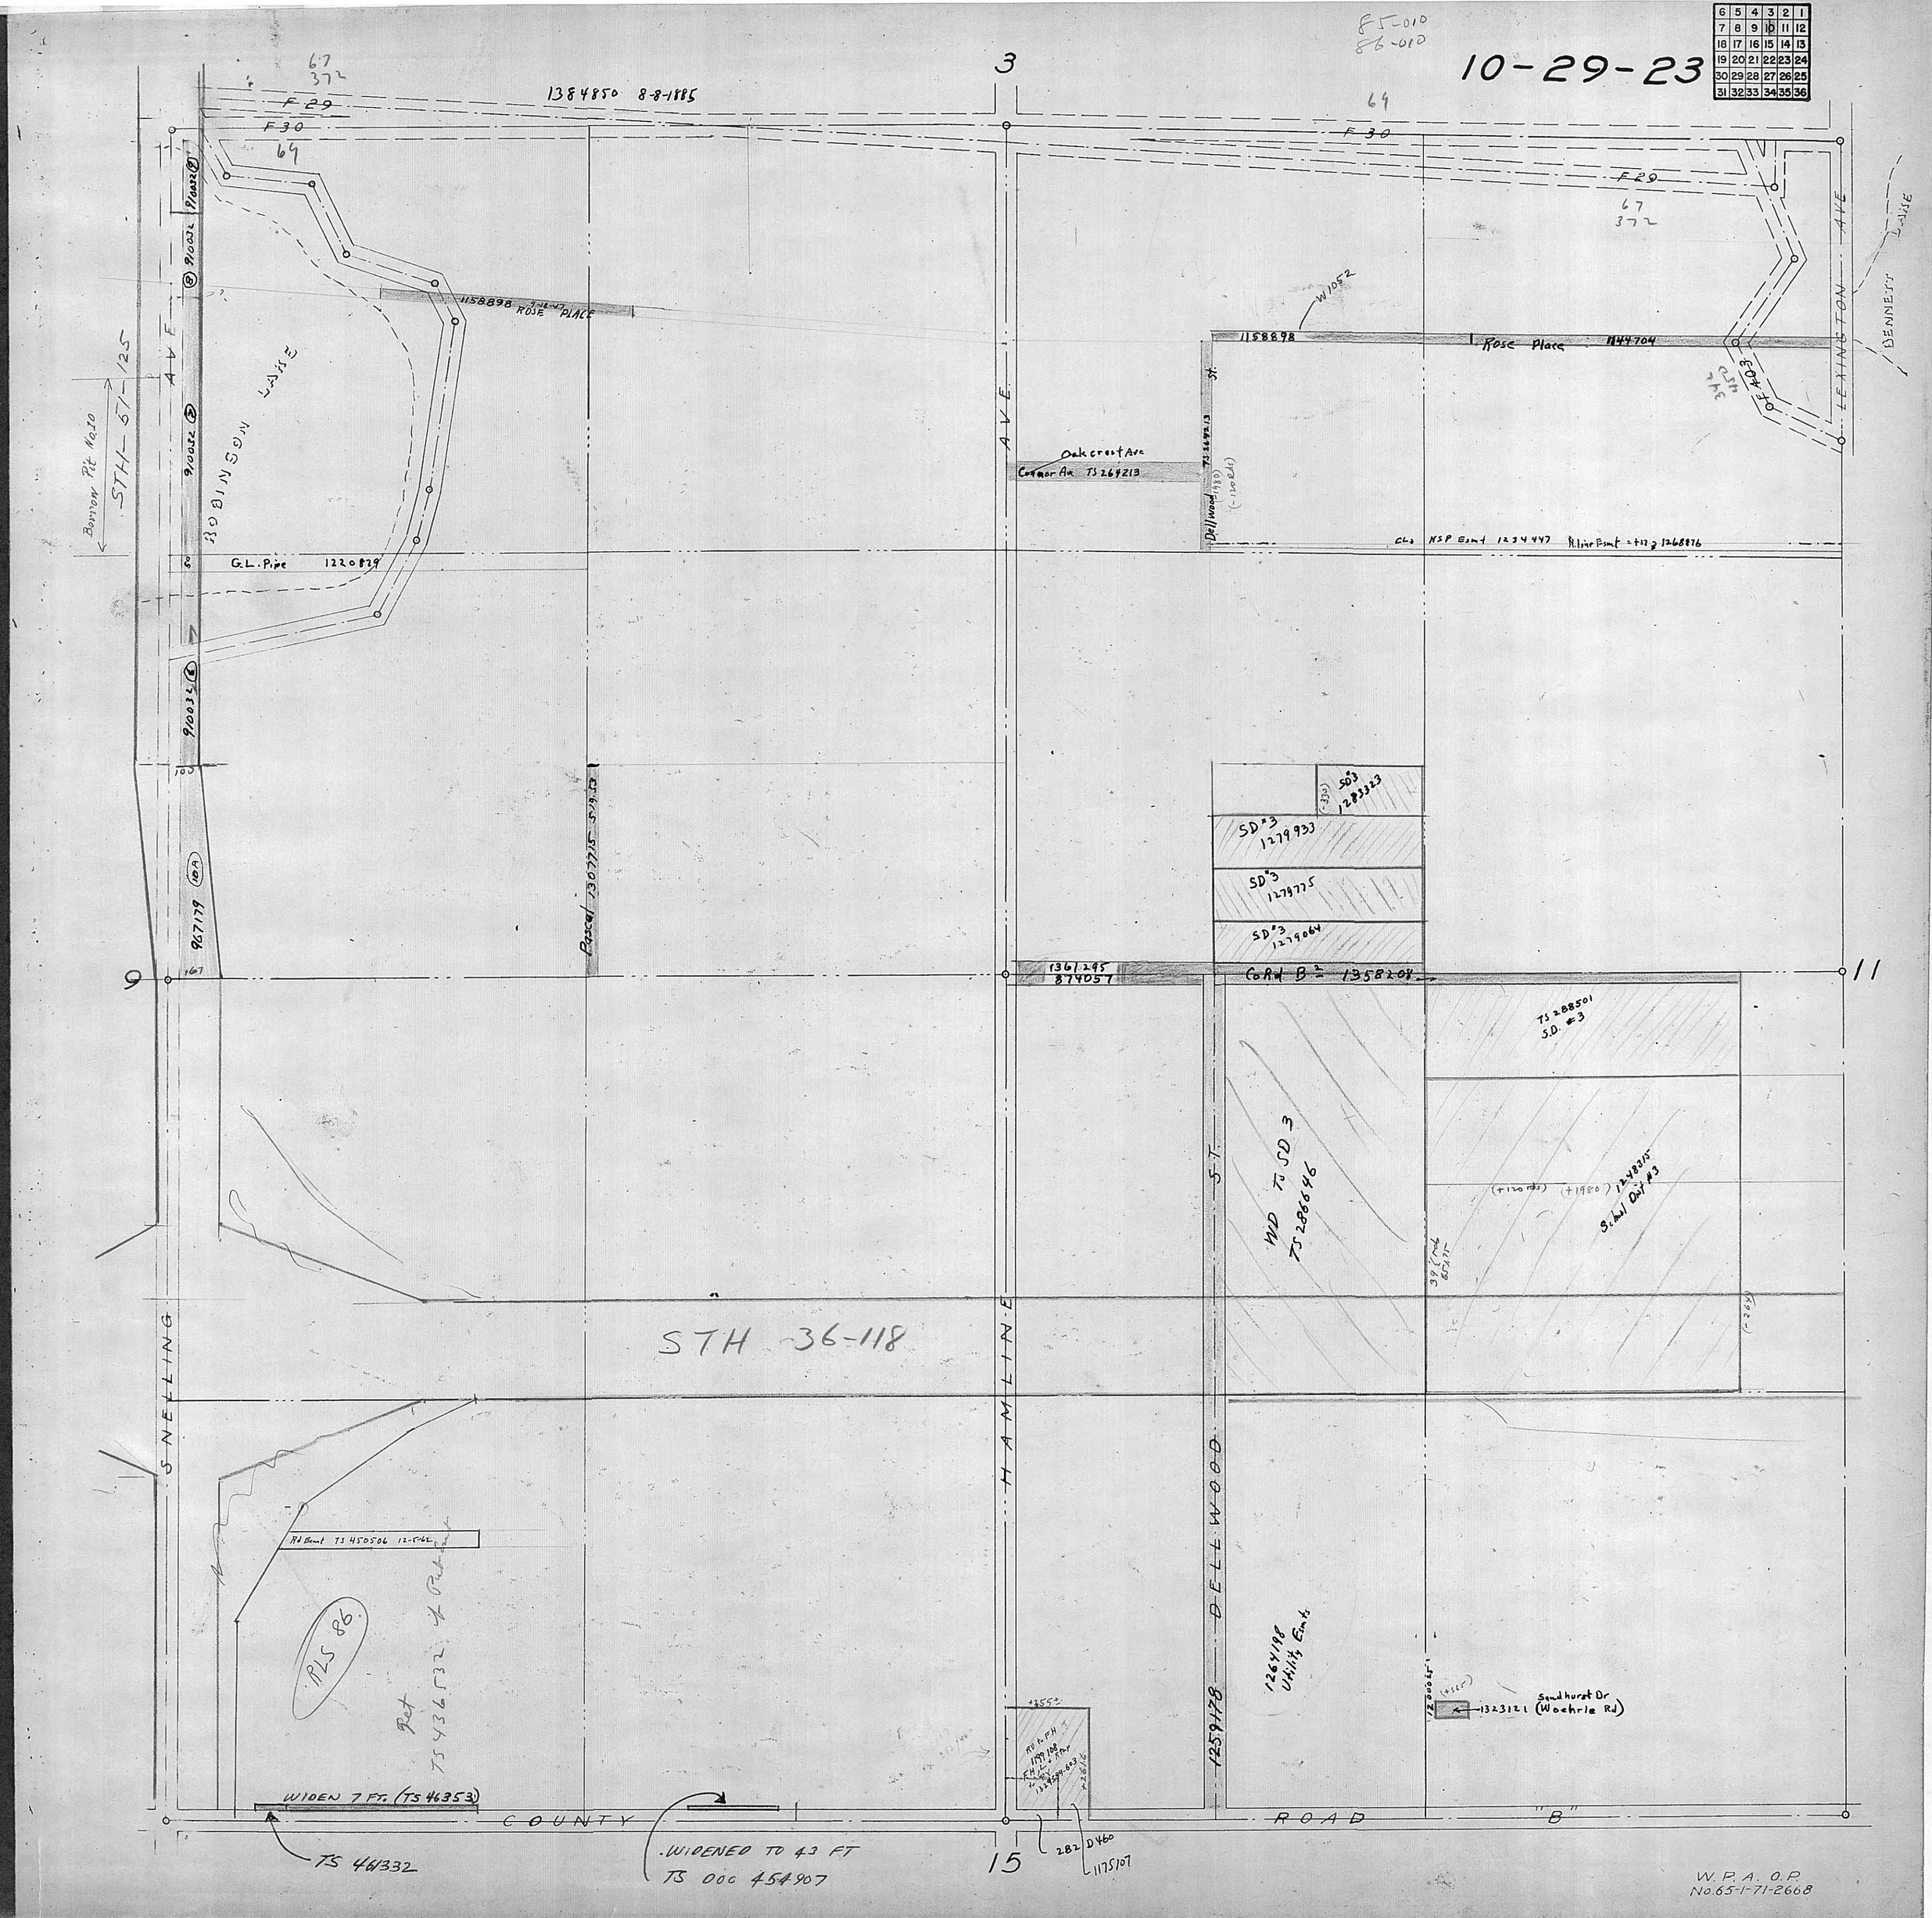

10-29-23
85-010
86-010
3
1384850 8-8-1885
F 29
F 30
1158898 ROSE PLACE
ROBINSON LAKE
STH-51-125
Borrow Pit No. 10
G.L. Pipe 1220829
Oakcrest Ave
Connor Ave TS 264213
Dellwood St.
1158898
Rose Place 1144704
LEXINGTON AVE
BENNETT LAKE
SD#3 1279933
SD#3 1279775
SD#3 1279064
SD#3 1283323
1361295 874057
CoRd B 1358208
TS 288501 S.D. #3
WD To SD 3 TS 286646
School Dist #3
STH 36-118
SNELLING AVE
HAMLINE AVE
DELLWOOD ST.
1259178
1264198 Utility Esmts
Sandhurst Dr (Woehrle Rd)
1323121
Rd Esmt TS 450506 12-5-62
RLS 86
Ret TS 436532
WIDEN 7 FT. (TS 46353)
COUNTY ROAD "B"
TS 461332
WIDENED TO 43 FT
TS 000 454907
15
282 D460
1175107
9
11
W.P.A. O.P.
No. 65-1-71-2668