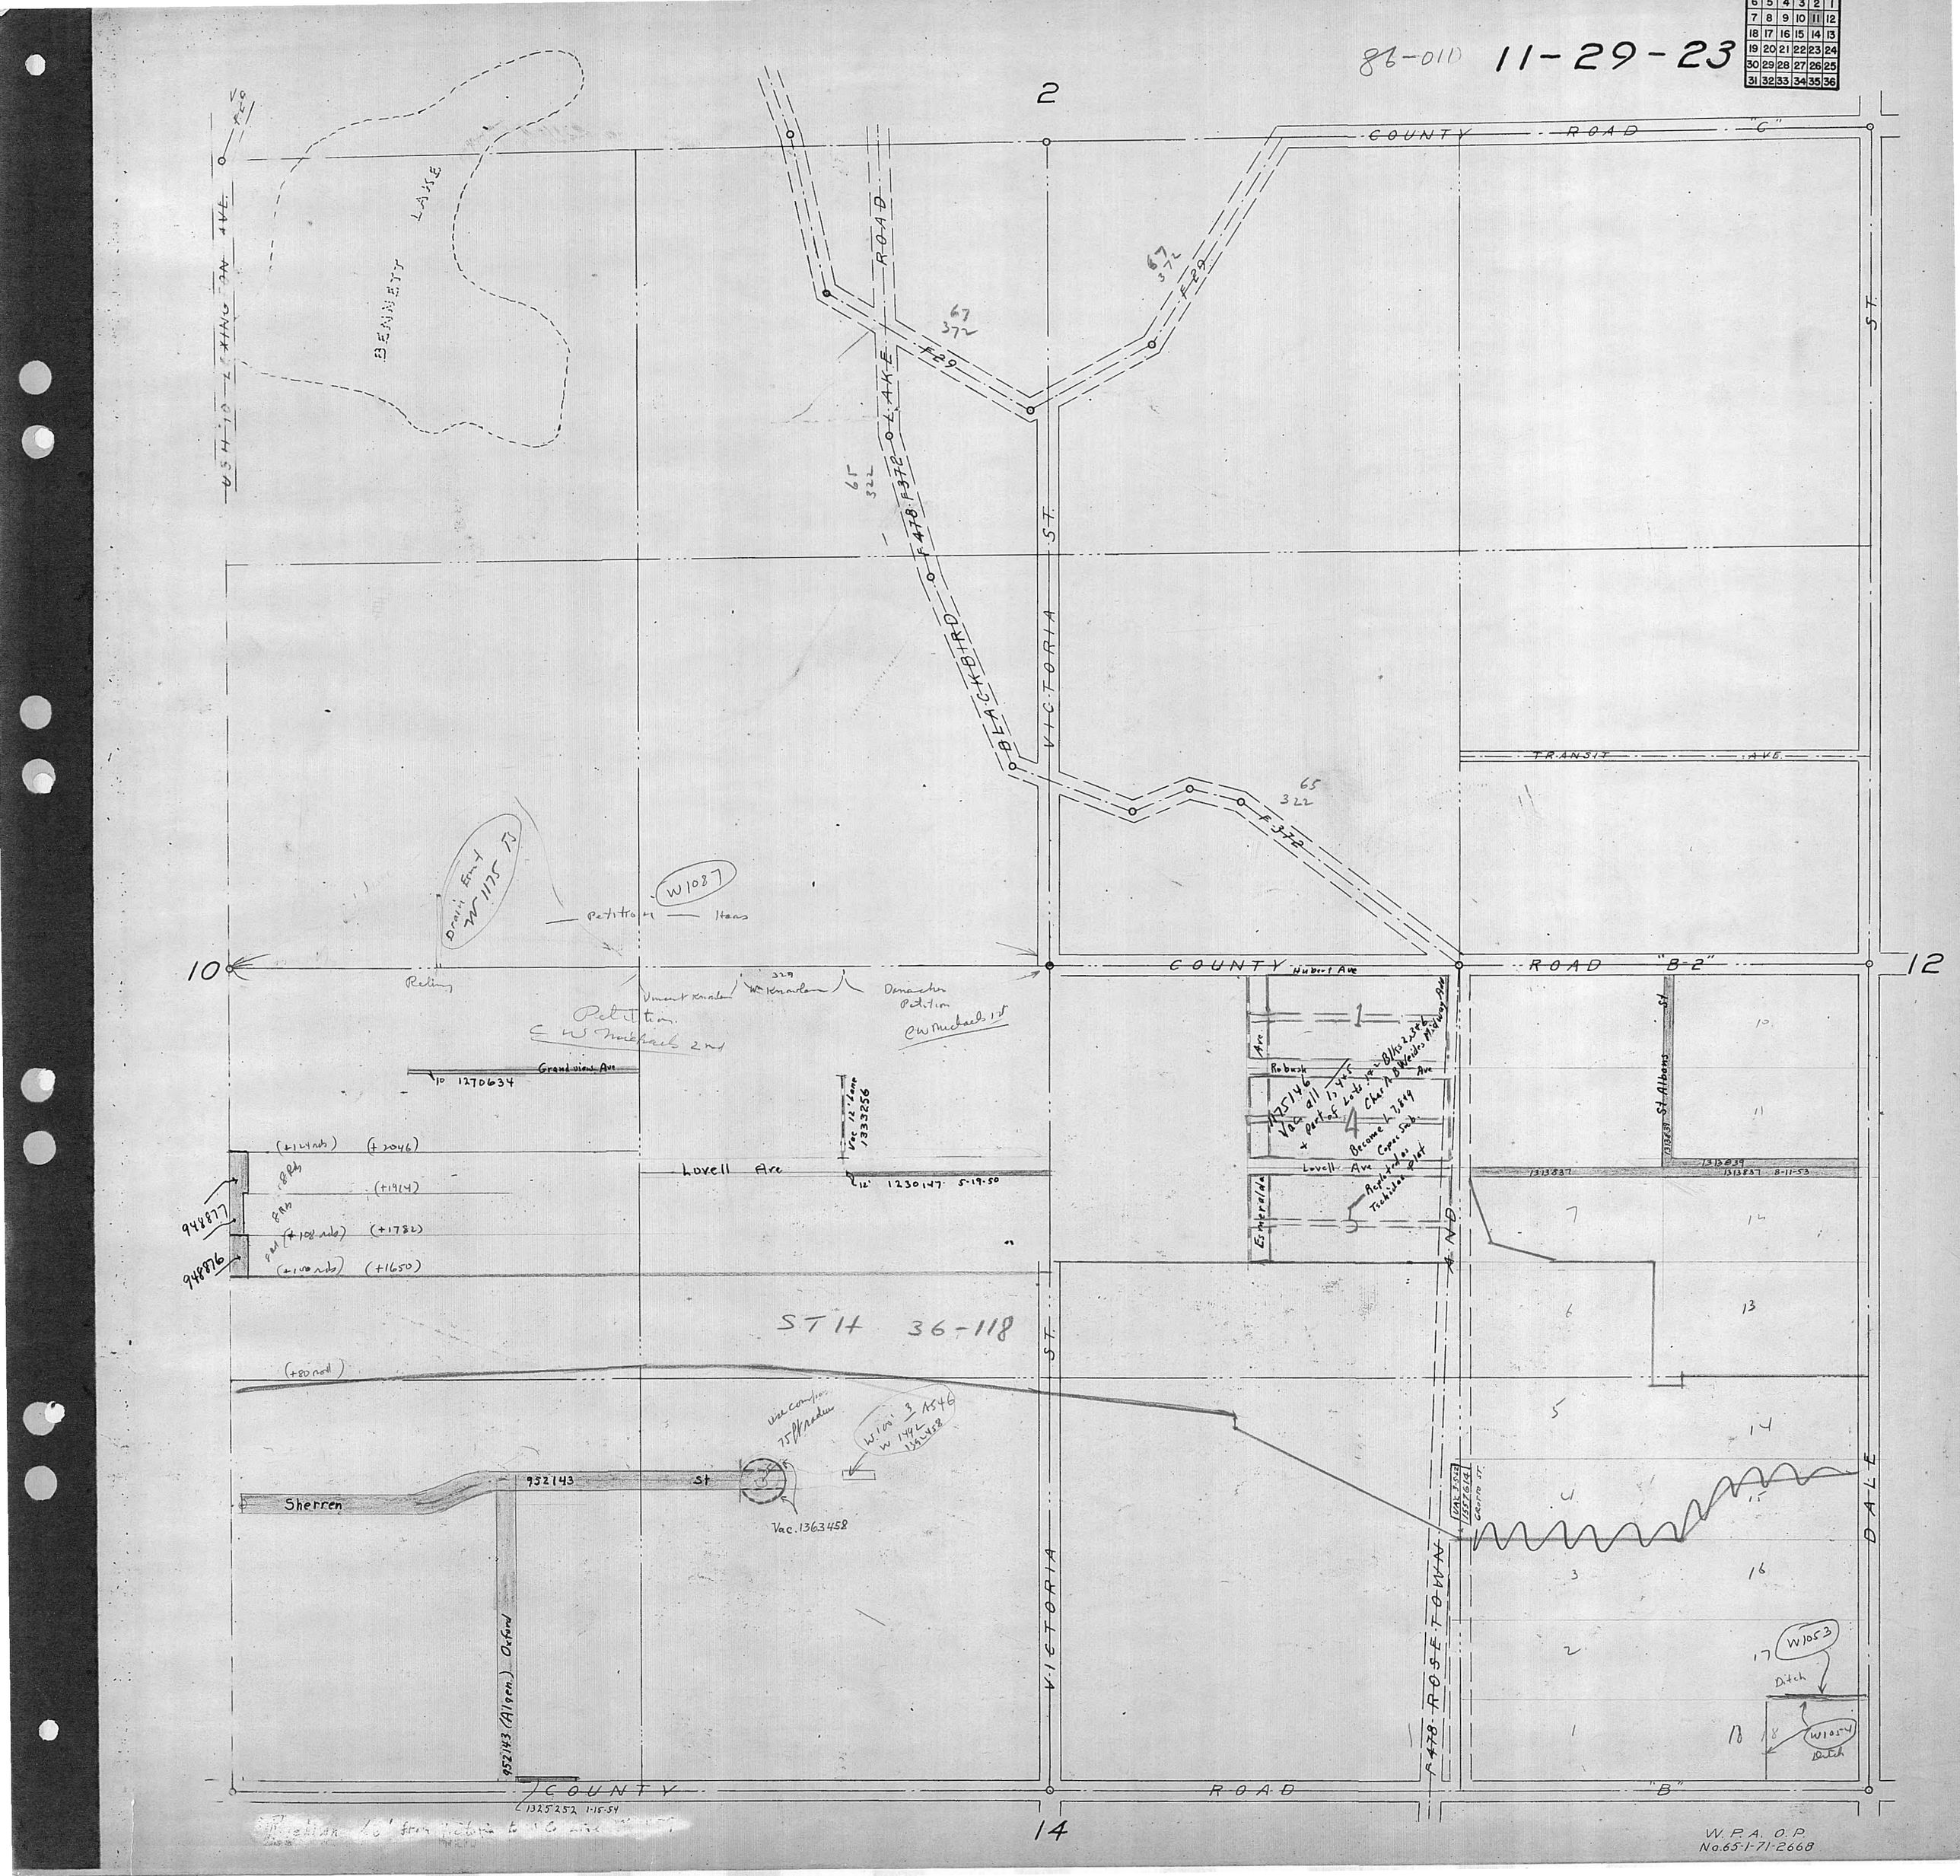
86-011D
11-29-23
2
COUNTY ROAD "C"
BENNETT LAKE
USH 10 LEXINGTON AVE.
LAKE ROAD
BLACKBIRD
F 478 F 372
VICTORIA ST.
TRANSIT AVE.
COUNTY ROAD "B-2"
10
12
Hubert Ave
Grandview Ave
Lovell Ave
Robusk
Esmeralda
St Albans St
Petition
Heas
Reling
Vincent Knowlan
Wm Knowlan
Danacher Petition
C W Michaels 1st
Vac 12' Lane 1333256
1270634
1230147 5-19-50
1313837
1313839
1313837 8-11-53
948877
948876
STH 36-118
Sherren
952143 St
Vac. 1363458
952143 (Algen) Oxford
1325252 1-15-54
ROSETOWN AND
DALE
COUNTY ROAD "B"
14
W.P.A. O.P.
No.65-1-71-2668