


6	5	4	3	2	1
7	8	9	10	11	12
13	14	15	16	17	18
19	20	21	22	23	24
25	26	27	28	29	30
31	32	33	34	35	36

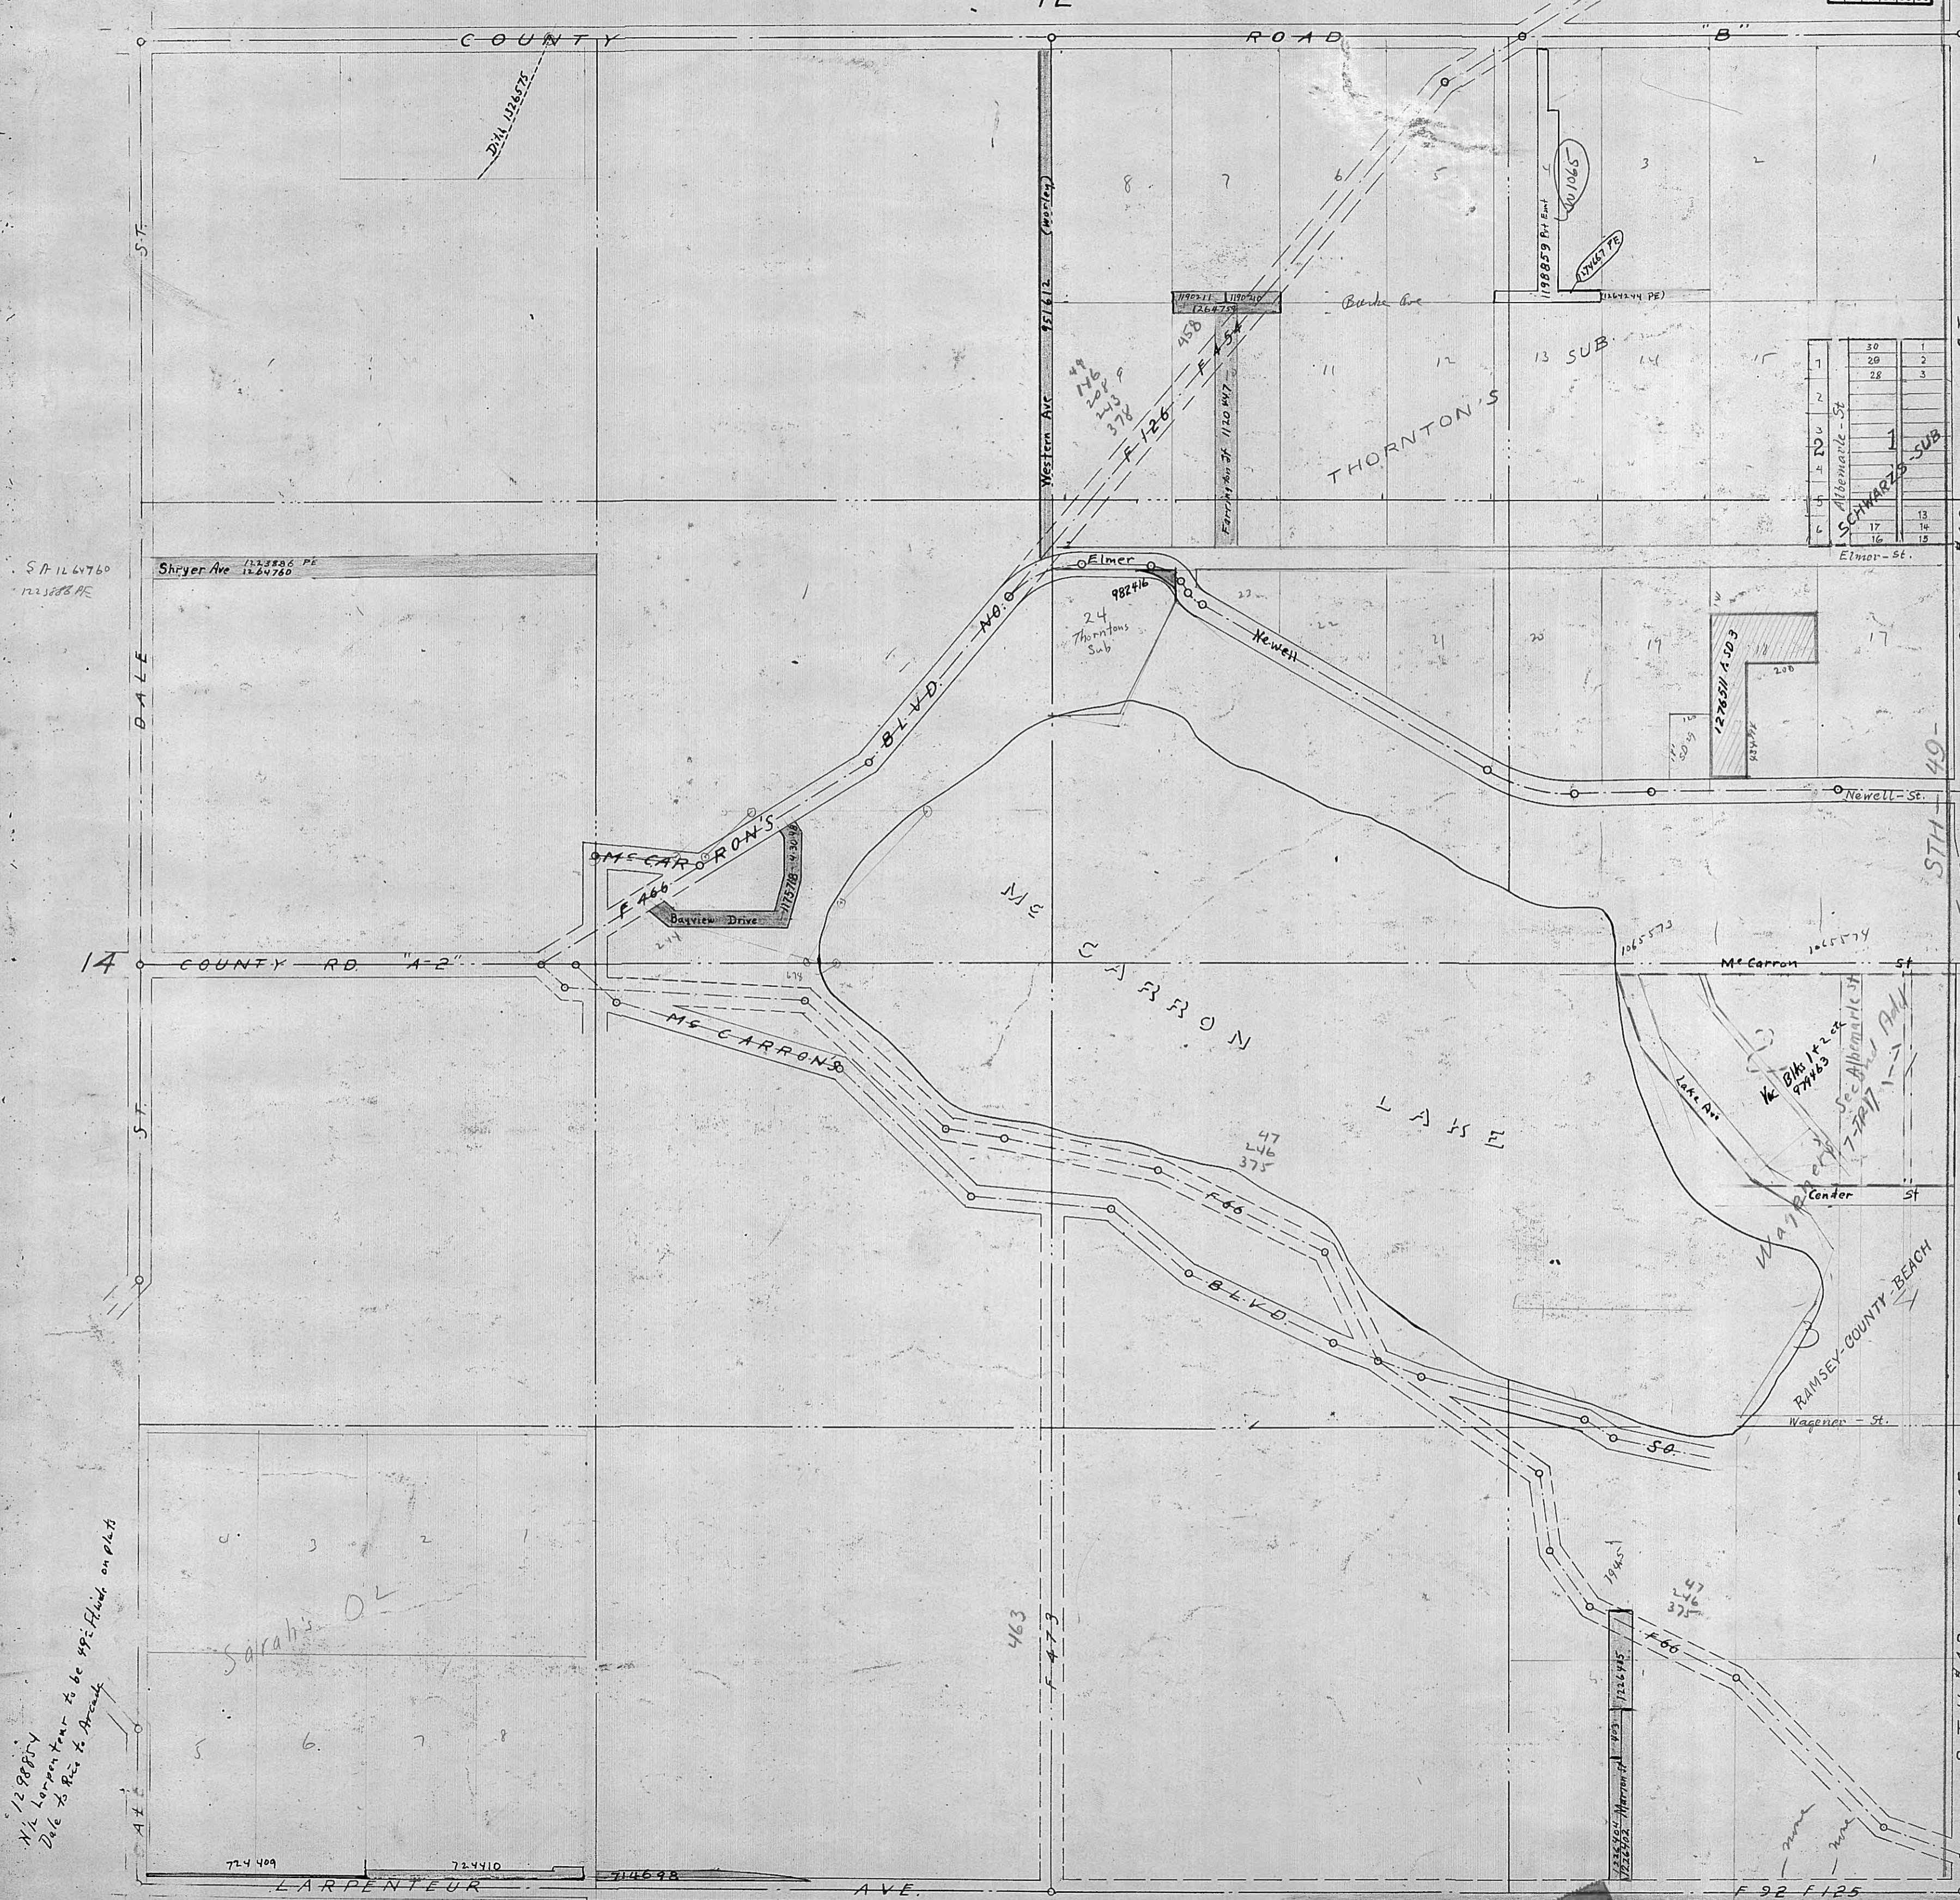

1	30	1
2	29	2
3	28	3
4		
5		
6		

SCHWARTZ SUB

1298874
 N/2 Larpenneur to be 49' wide Dale to Arcade
 Dale to Rice to Arcade

1287238, Part NWNW Sec 24

1293271 S10W3/4E4
 Lot 1 D-4411+ released

1298854
 Larpenneur to be 99' wide Dale to Arcade

427997 Plan 5/8 Rice to Farrington

W.P.A. O.P.
 No. 65-1-71-2668

1883 year