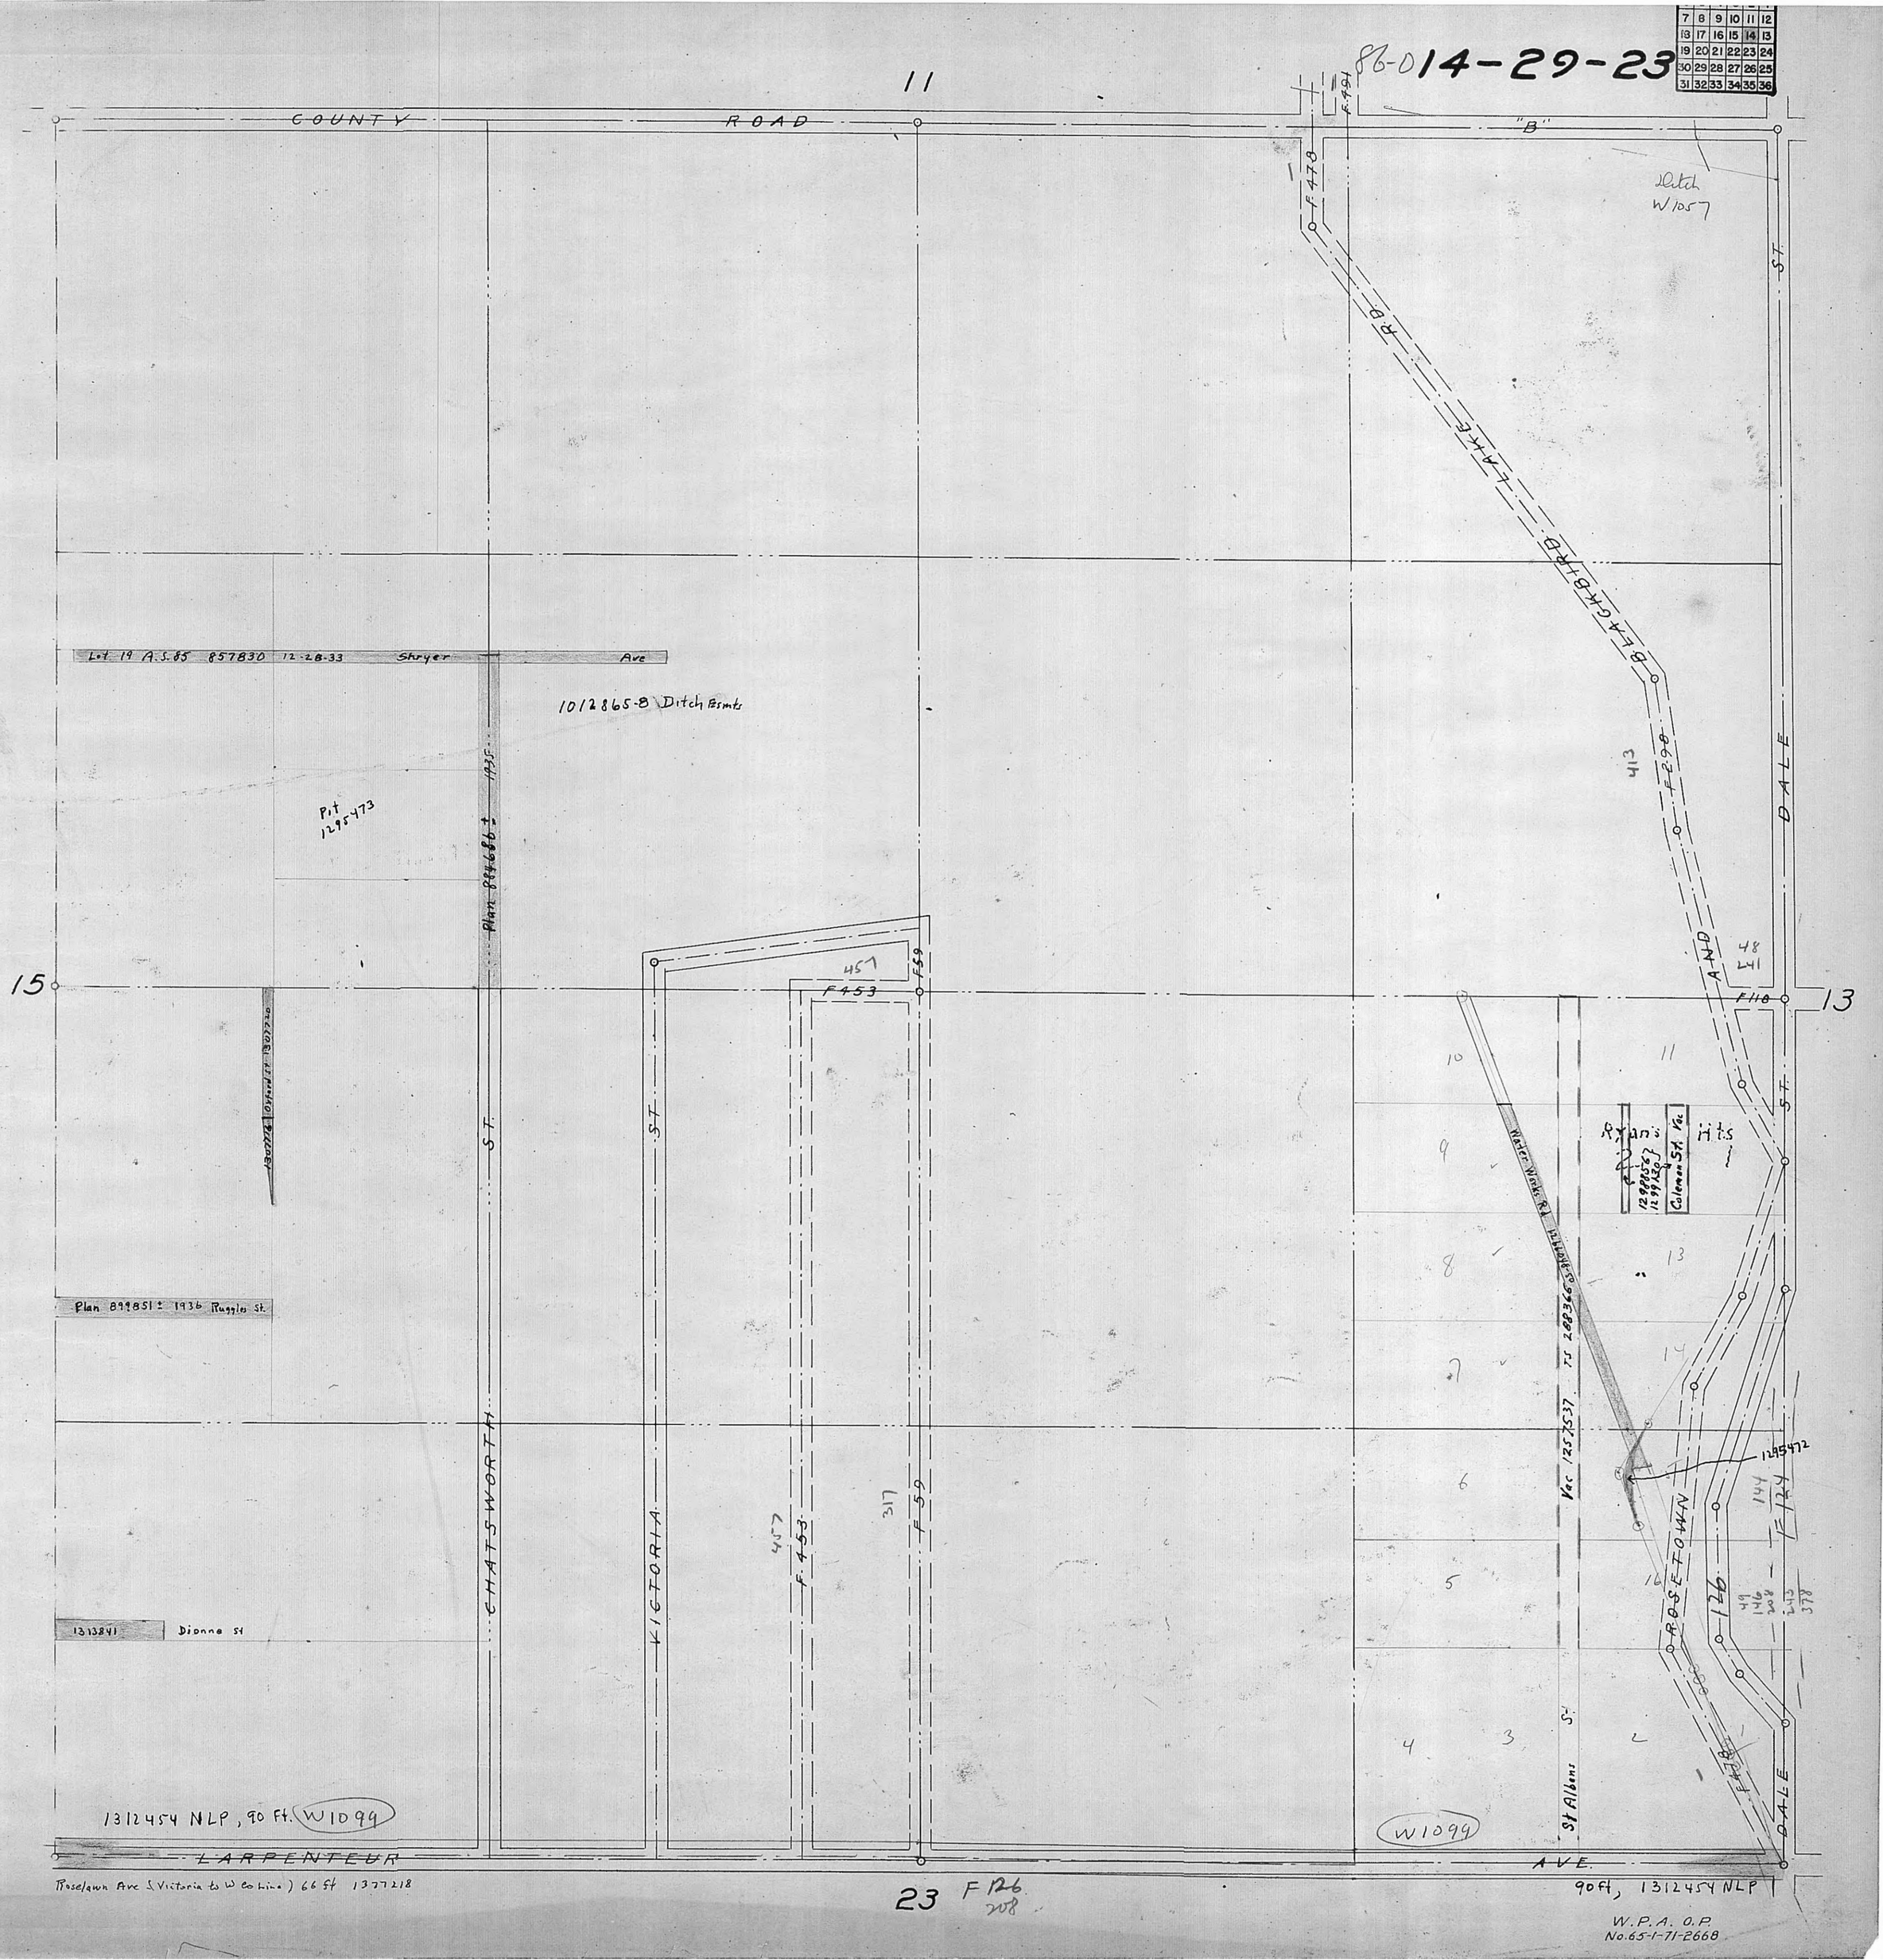

86-014-29-23
11
COUNTY ROAD "B"
Ditch W1057
F 478
F 491
BLACKBIRD LAKE R.D.
Lot 19 A.S.85 857830 12-28-33 Shryer Ave
1012865-8 Ditch Esmts
Pit 1295473
Plan 884686± 1935
15
13
CHATSWORTH ST.
VICTORIA ST.
F 453
F 59
457
317
Plan 899851± 1936 Ruggles St.
1313841 Dionne St
Water Works Rd
Vac 1257537 TS 288366
St Albans St.
ROSETOWN
DALE ST.
AND
F 110
F 124
126
1295472
1312454 NLP, 90 Ft. W1099
W1099
LARPENTEUR AVE.
Roselawn Ave (Victoria to W Co Line) 66 ft 1377218
23
F 126
208
90 ft, 1312454 NLP
W.P.A. O.P.
No.65-1-71-2668