

85-015
86-015
99-015


15-29 23

6	5	4	3	2	1
7	8	9	10	11	12
13	14	15	16	17	18
19	20	21	22	23	24
25	26	27	28	29	30
31	32	33	34	35	36

85
86
10

99
16
85

14

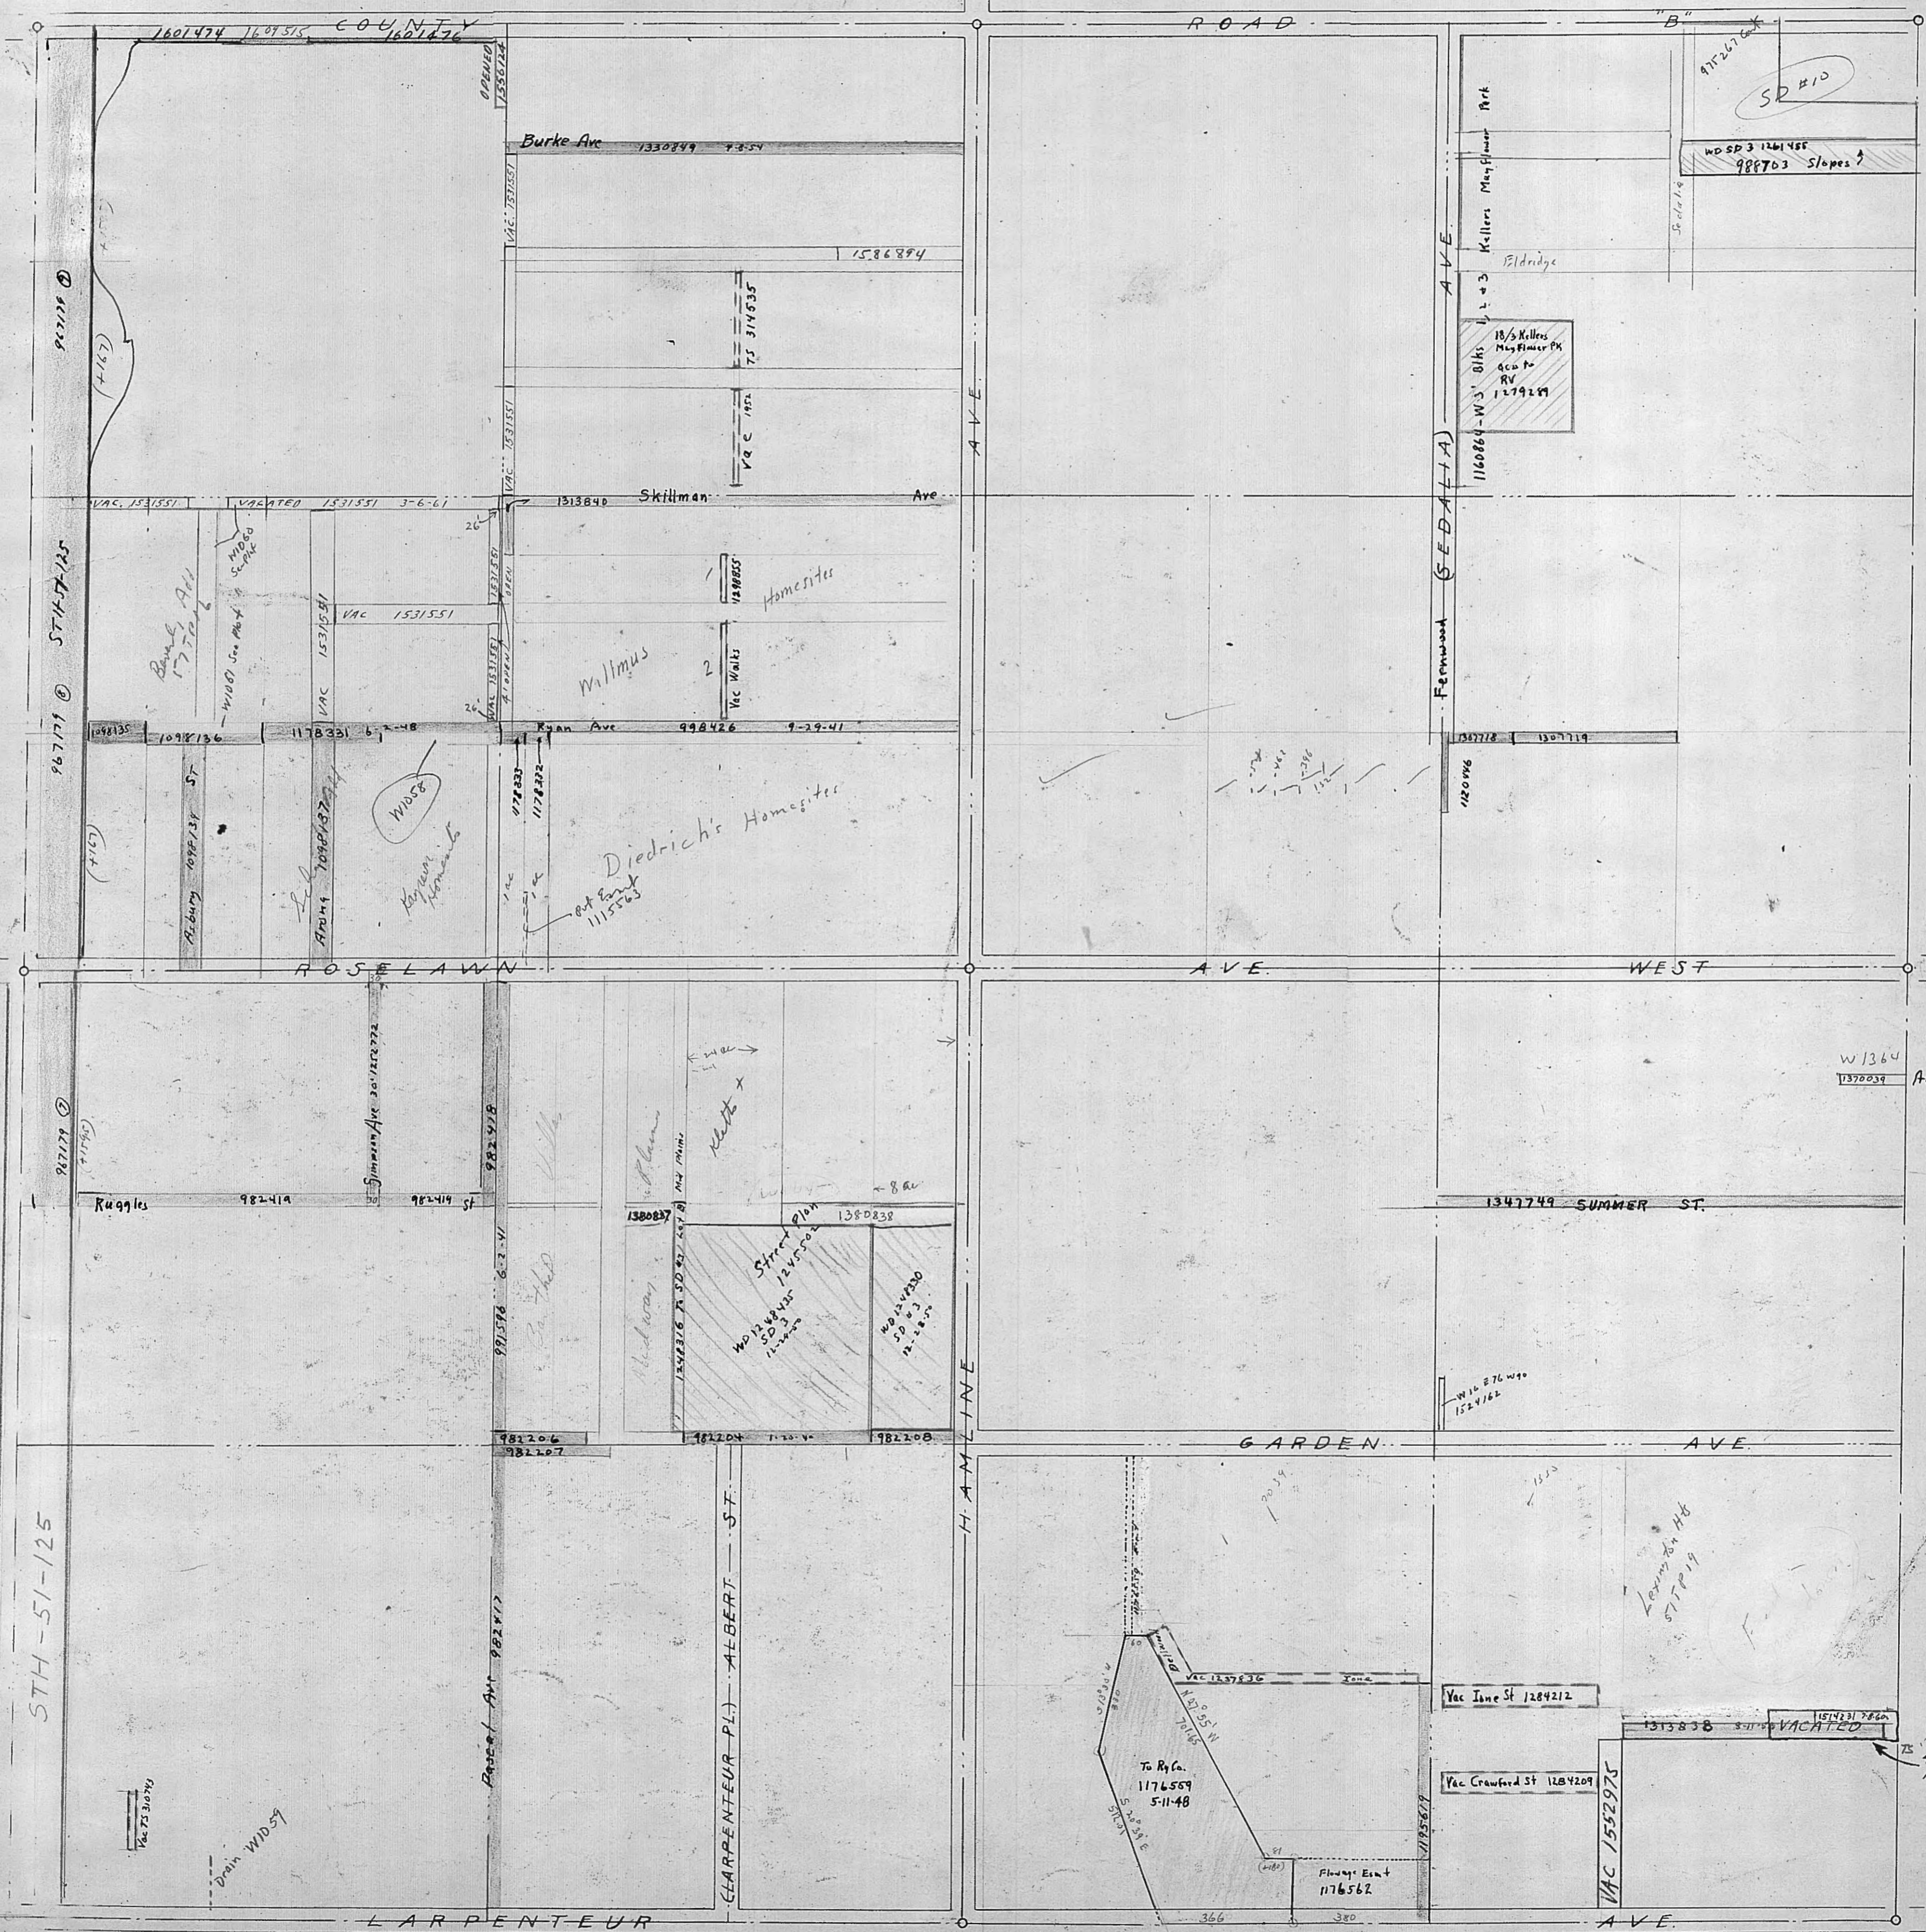

STH-51-125

Rose Lawn Ave (Victoria L.W. Line) 66' 1372218

99
22
86

F/26
208

W.P.A. O.P.
No. 65-71-2668