


17-29-23

7	8	9	10	11	12
13	14	15	16	17	18
19	20	21	22	23	24
25	26	27	28	29	30
31	32	33	34	35	36

8

86017
97017
98017
99017

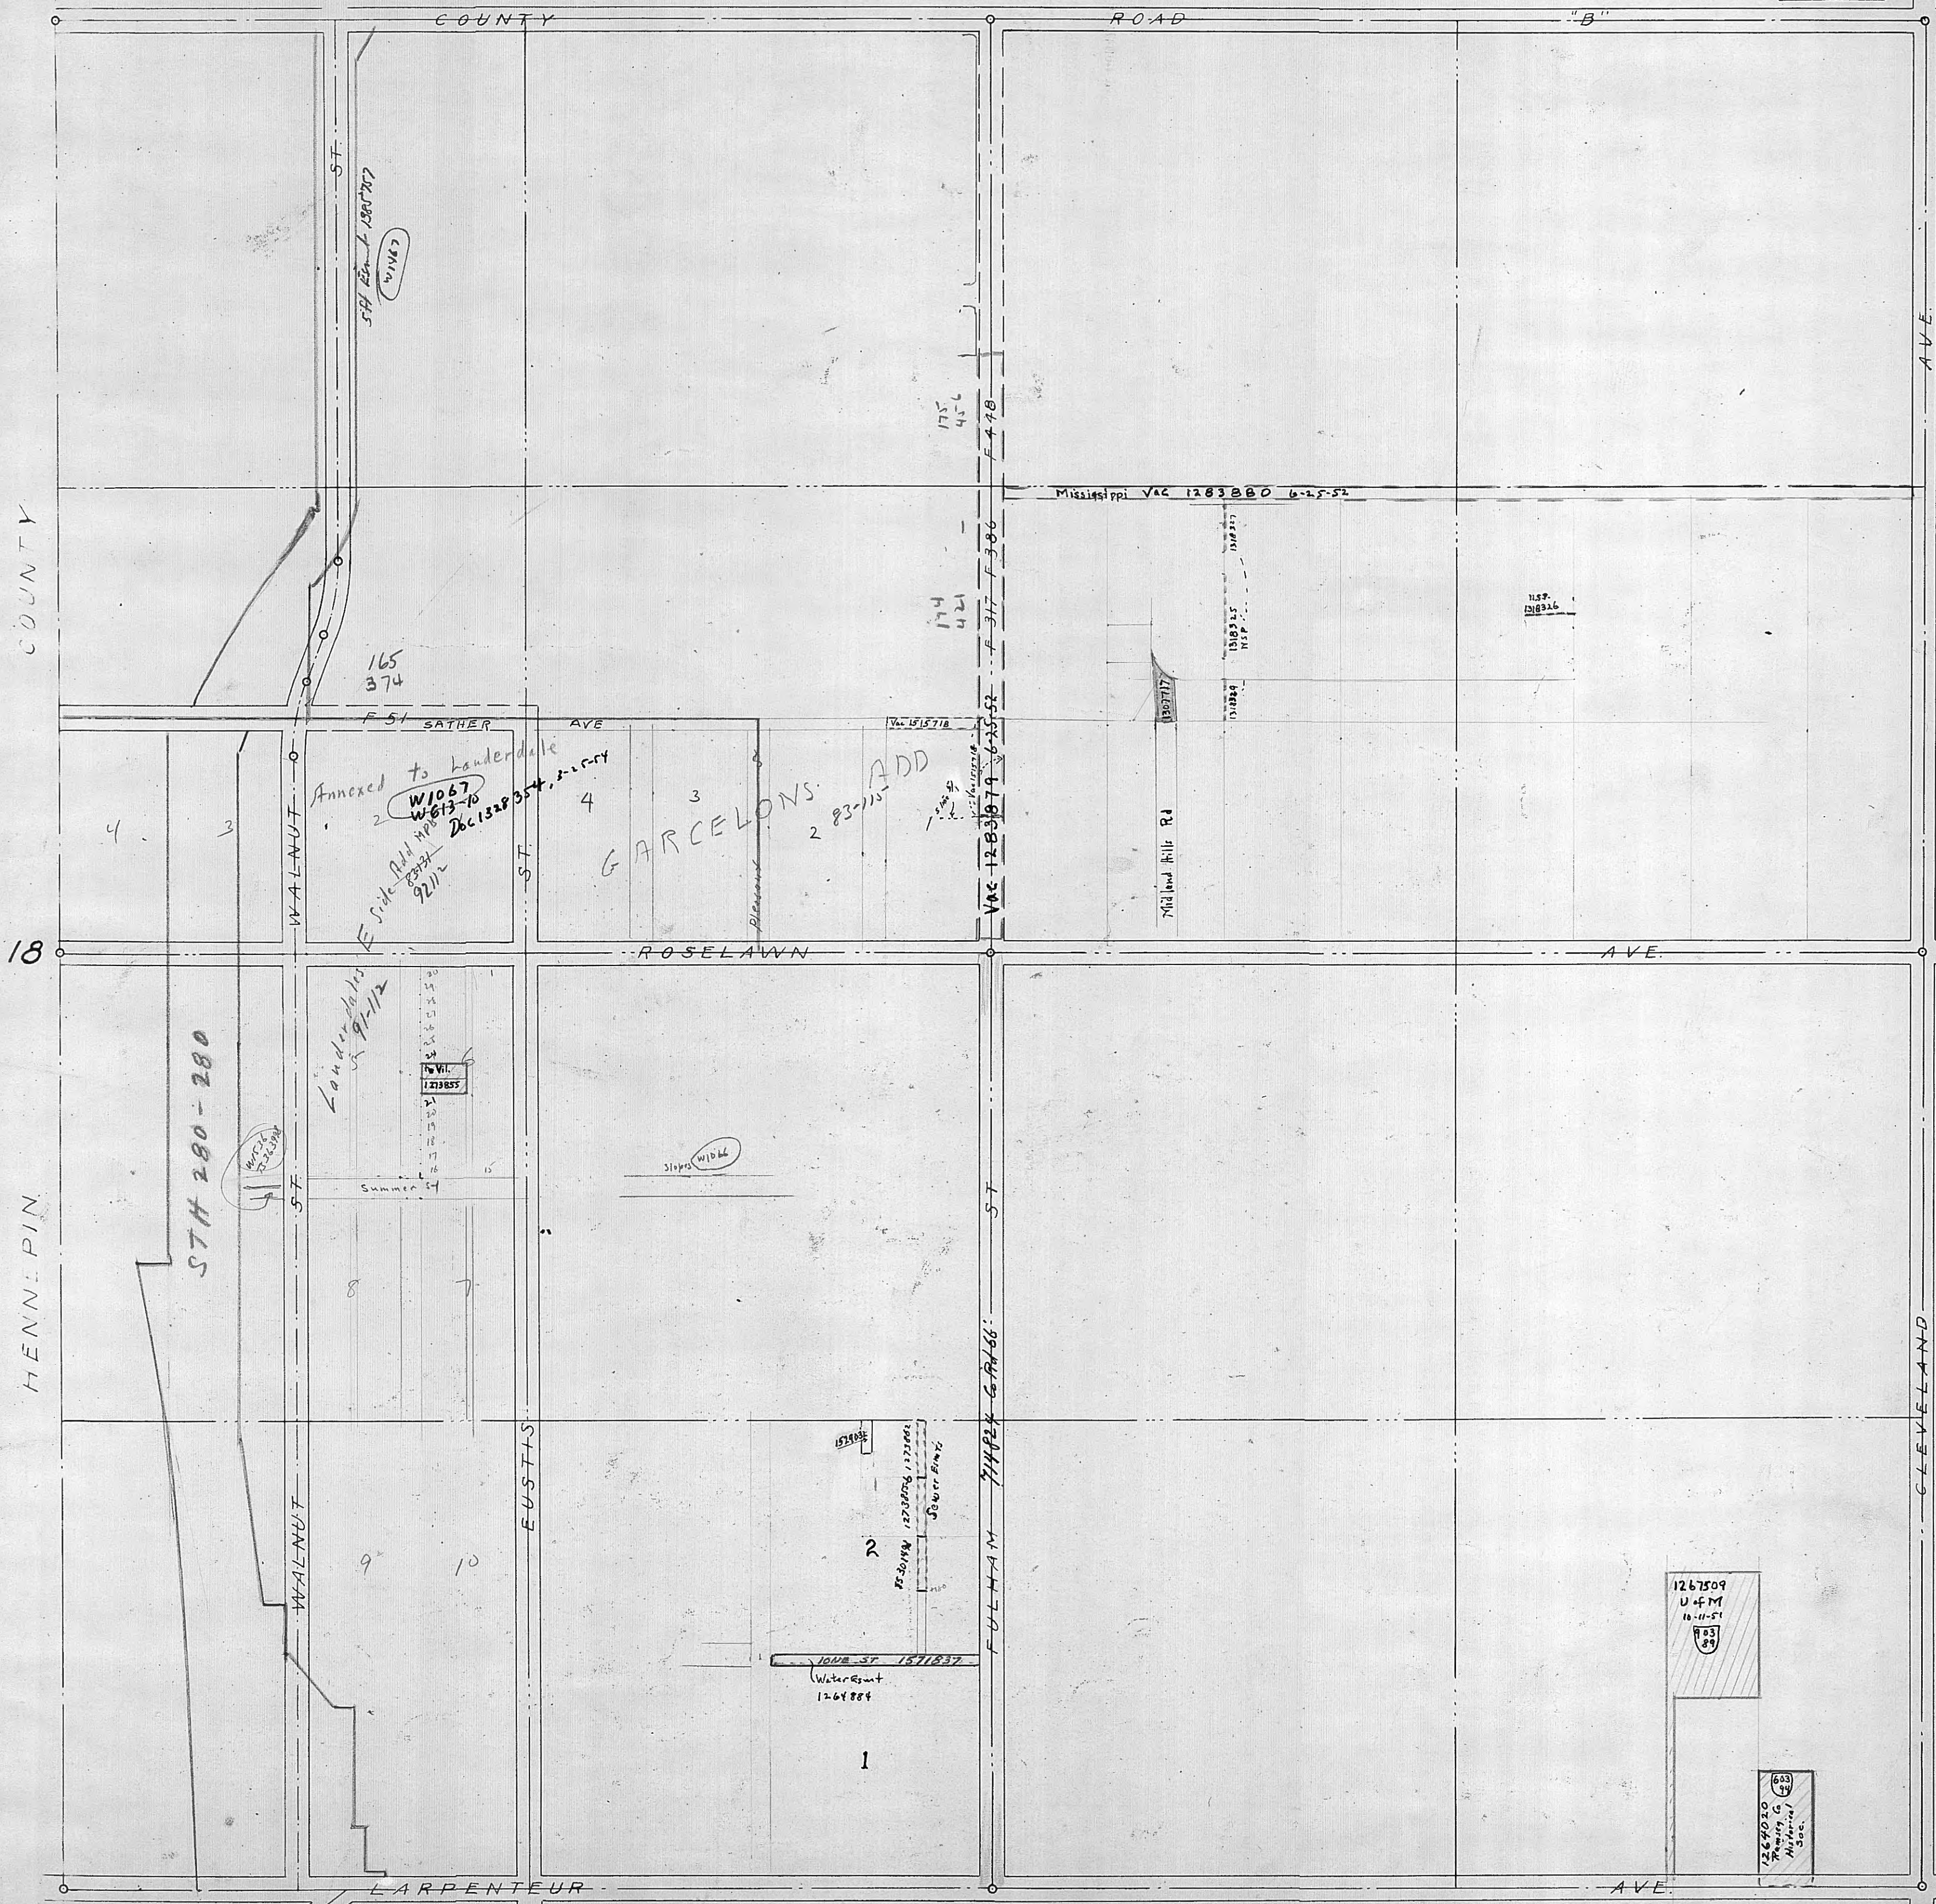

COUNTY

18

HENNEPIN

AVE.

16

CLEVELAND

Roselawn Ave (Victoria & W. Line)
1377218

20