


6	5	3	2	1	
7	8	9	10	11	12
13	14	15	16	17	18
19	20	21	22	23	24
25	26	27	28	29	30
31	32	33	34	35	36

82-004 29-23

33

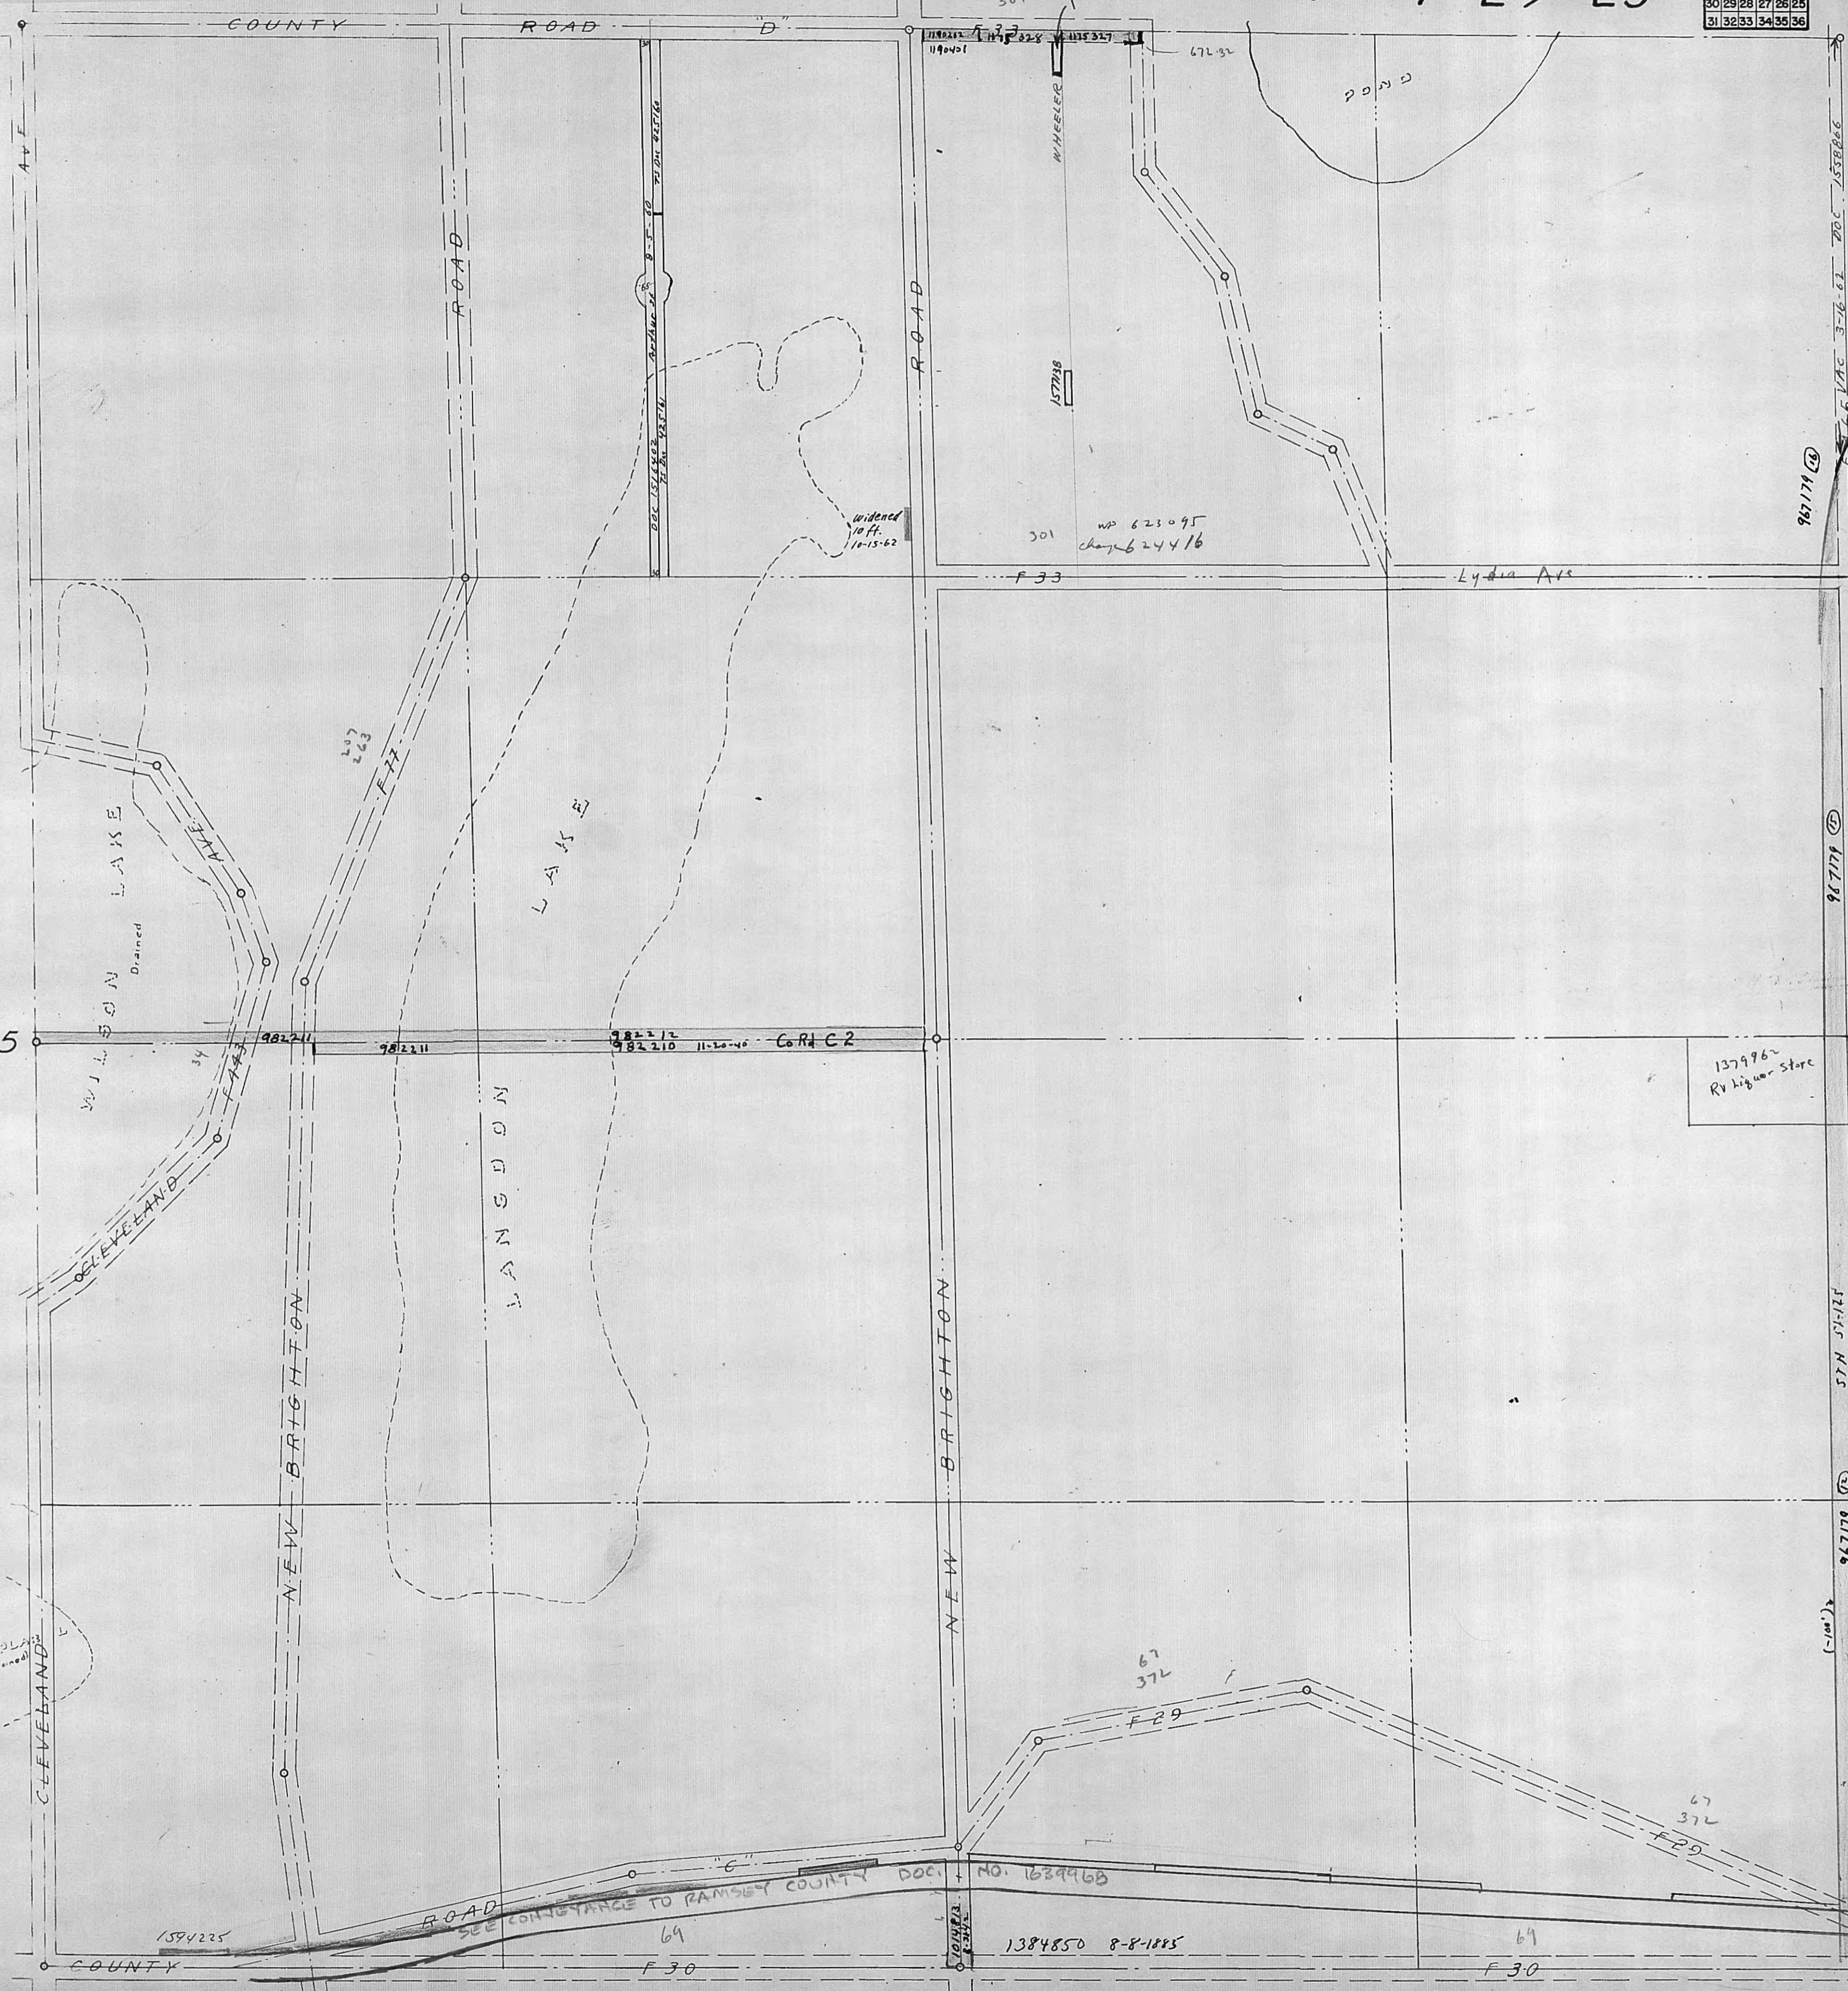

967179 (B)  
 967179 (C)  
 967179 (D)  
 967179 (E)  
 967179 (F)  
 967179 (G)