

6	7	8	9	10	11	12
13	14	15	16	17	18	19
20	21	22	23	24	25	26
27	28	29	30	31	32	33
34	35	36				

82-005-29-23


32

TOWNSHIP 30 NORTH  
TOWNSHIP 29 NORTH

COUNTY ROAD "D" COUNTY ROAD "D"

Put Esmt in NW 1/4  
Reserving RA to grant  
Public Esmt. Filed with  
11/4/91  
11/5/91  
HENNEPIN COUNTY

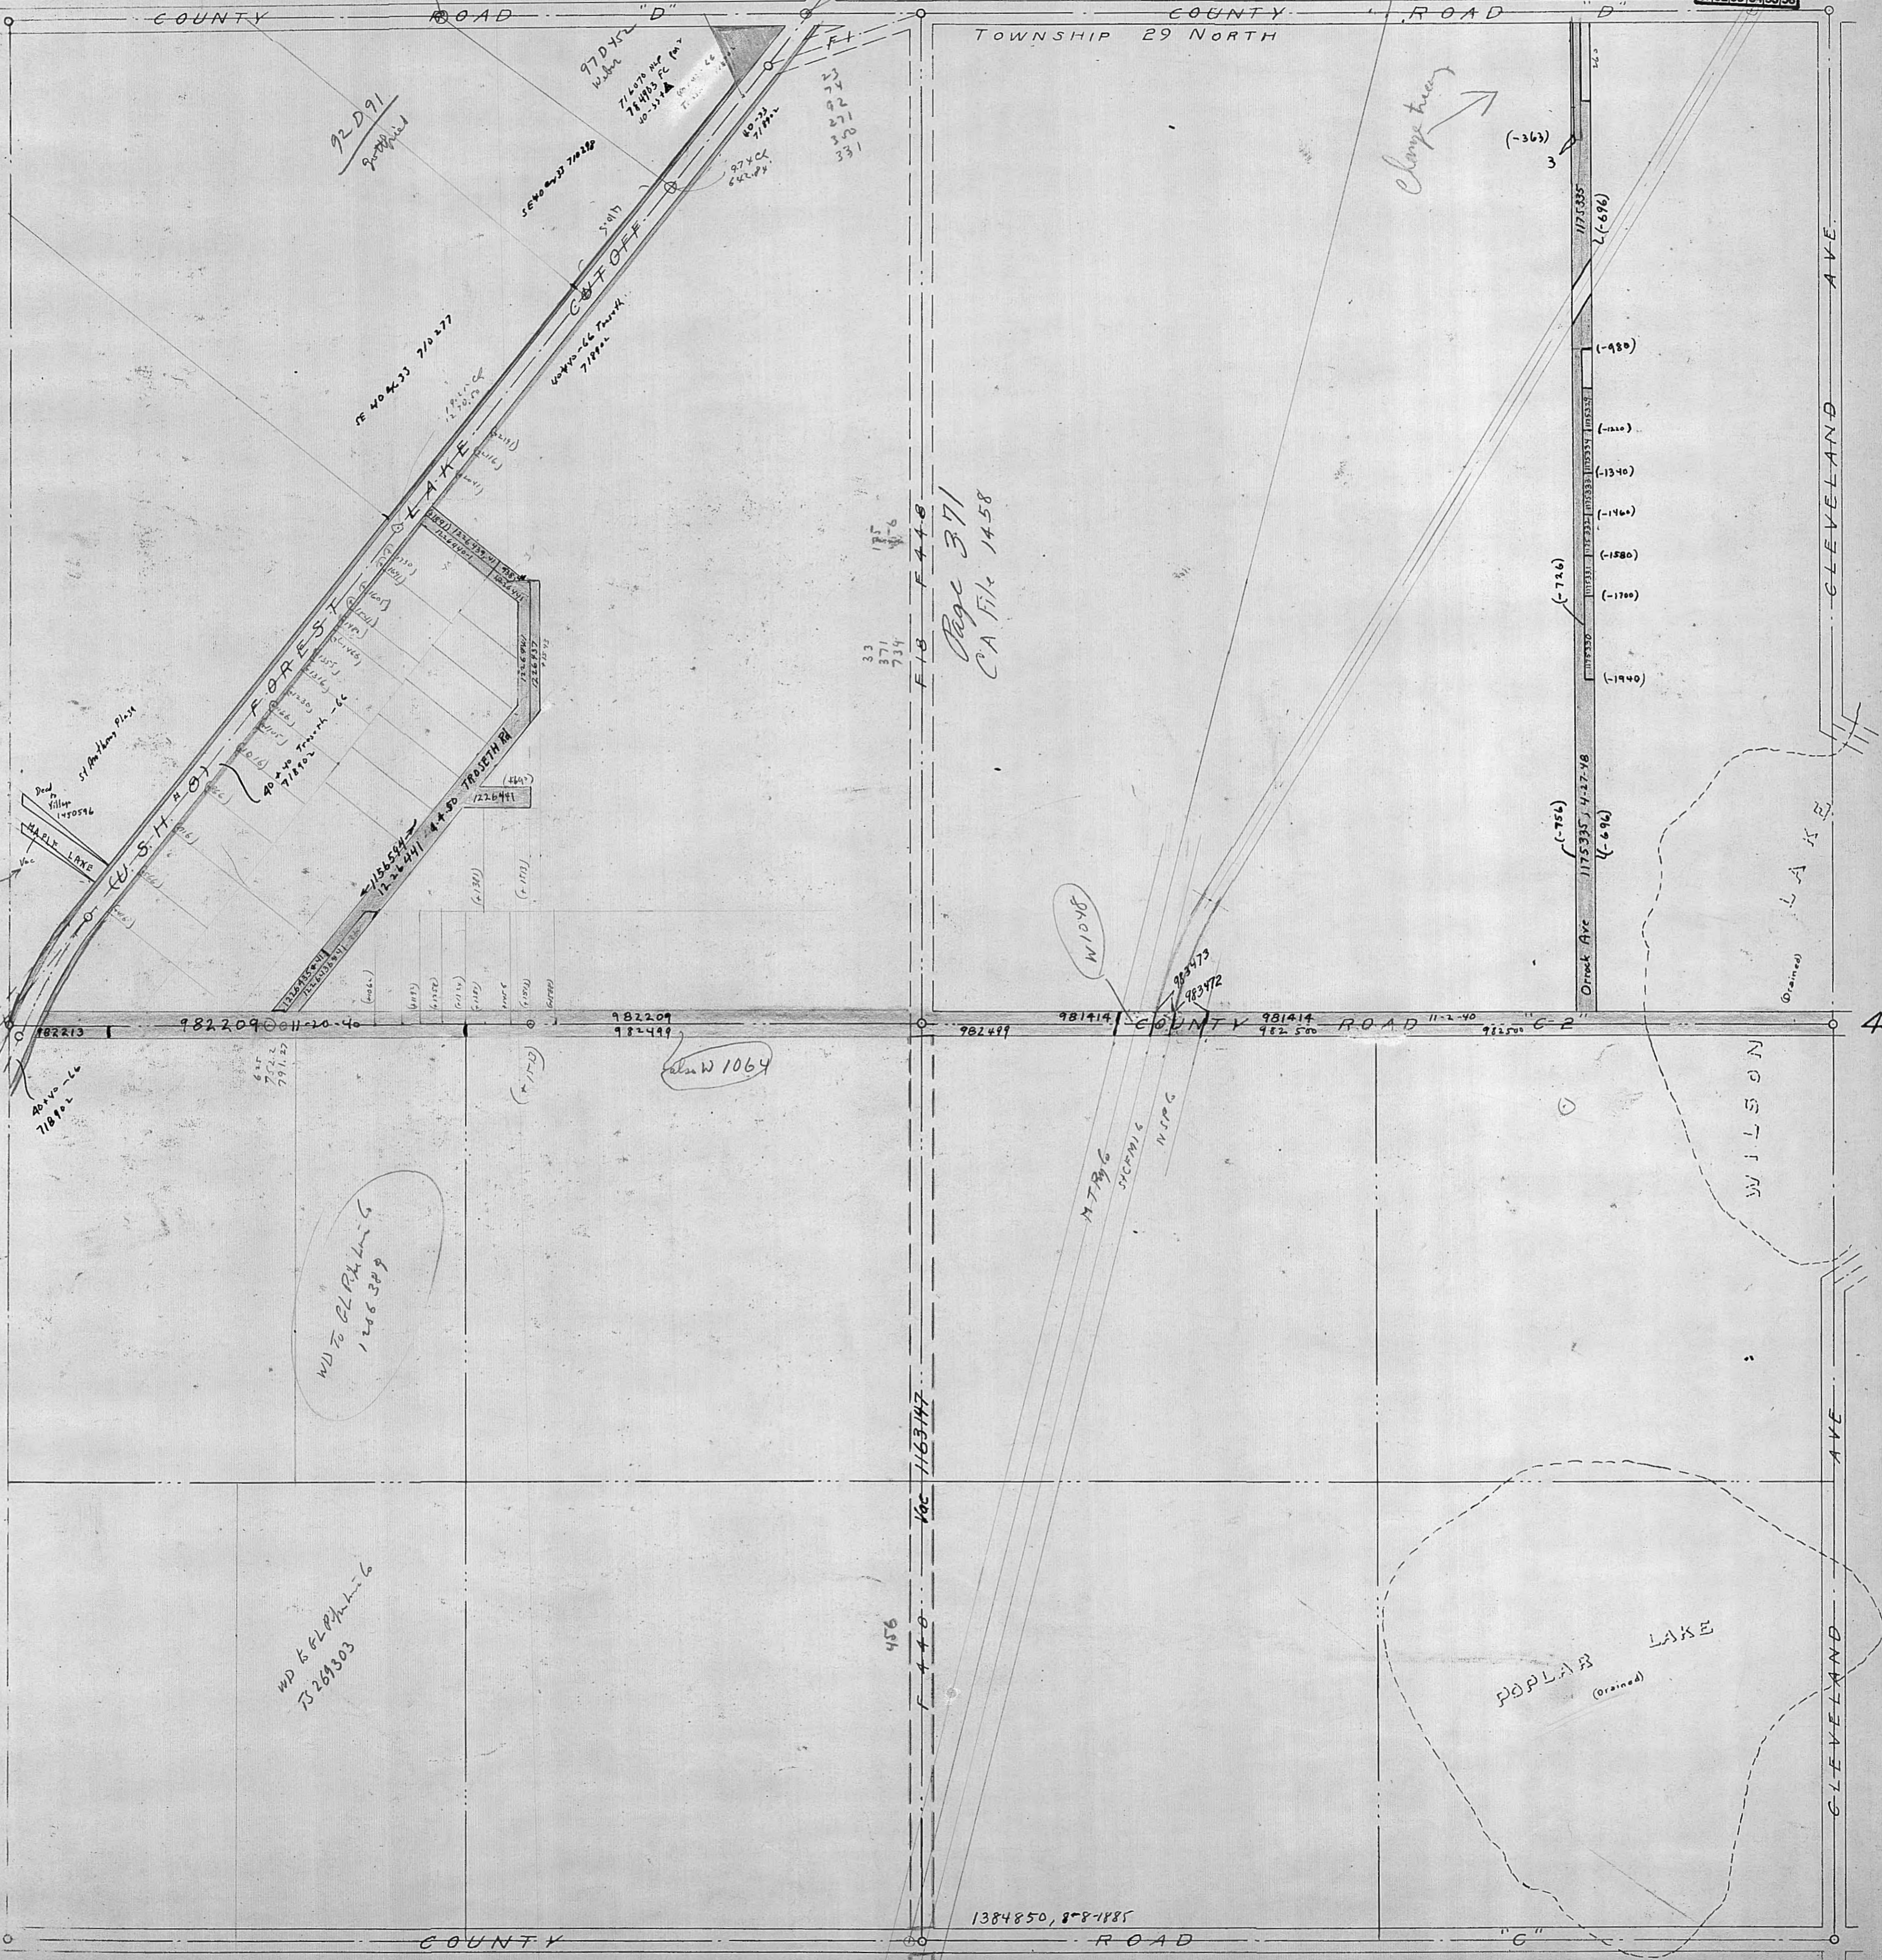

Page 371  
CA File 1458

WJ To PLP Linc 6  
1206389

WD to PLP Linc 6  
7328303

1384850, 8-8-1885