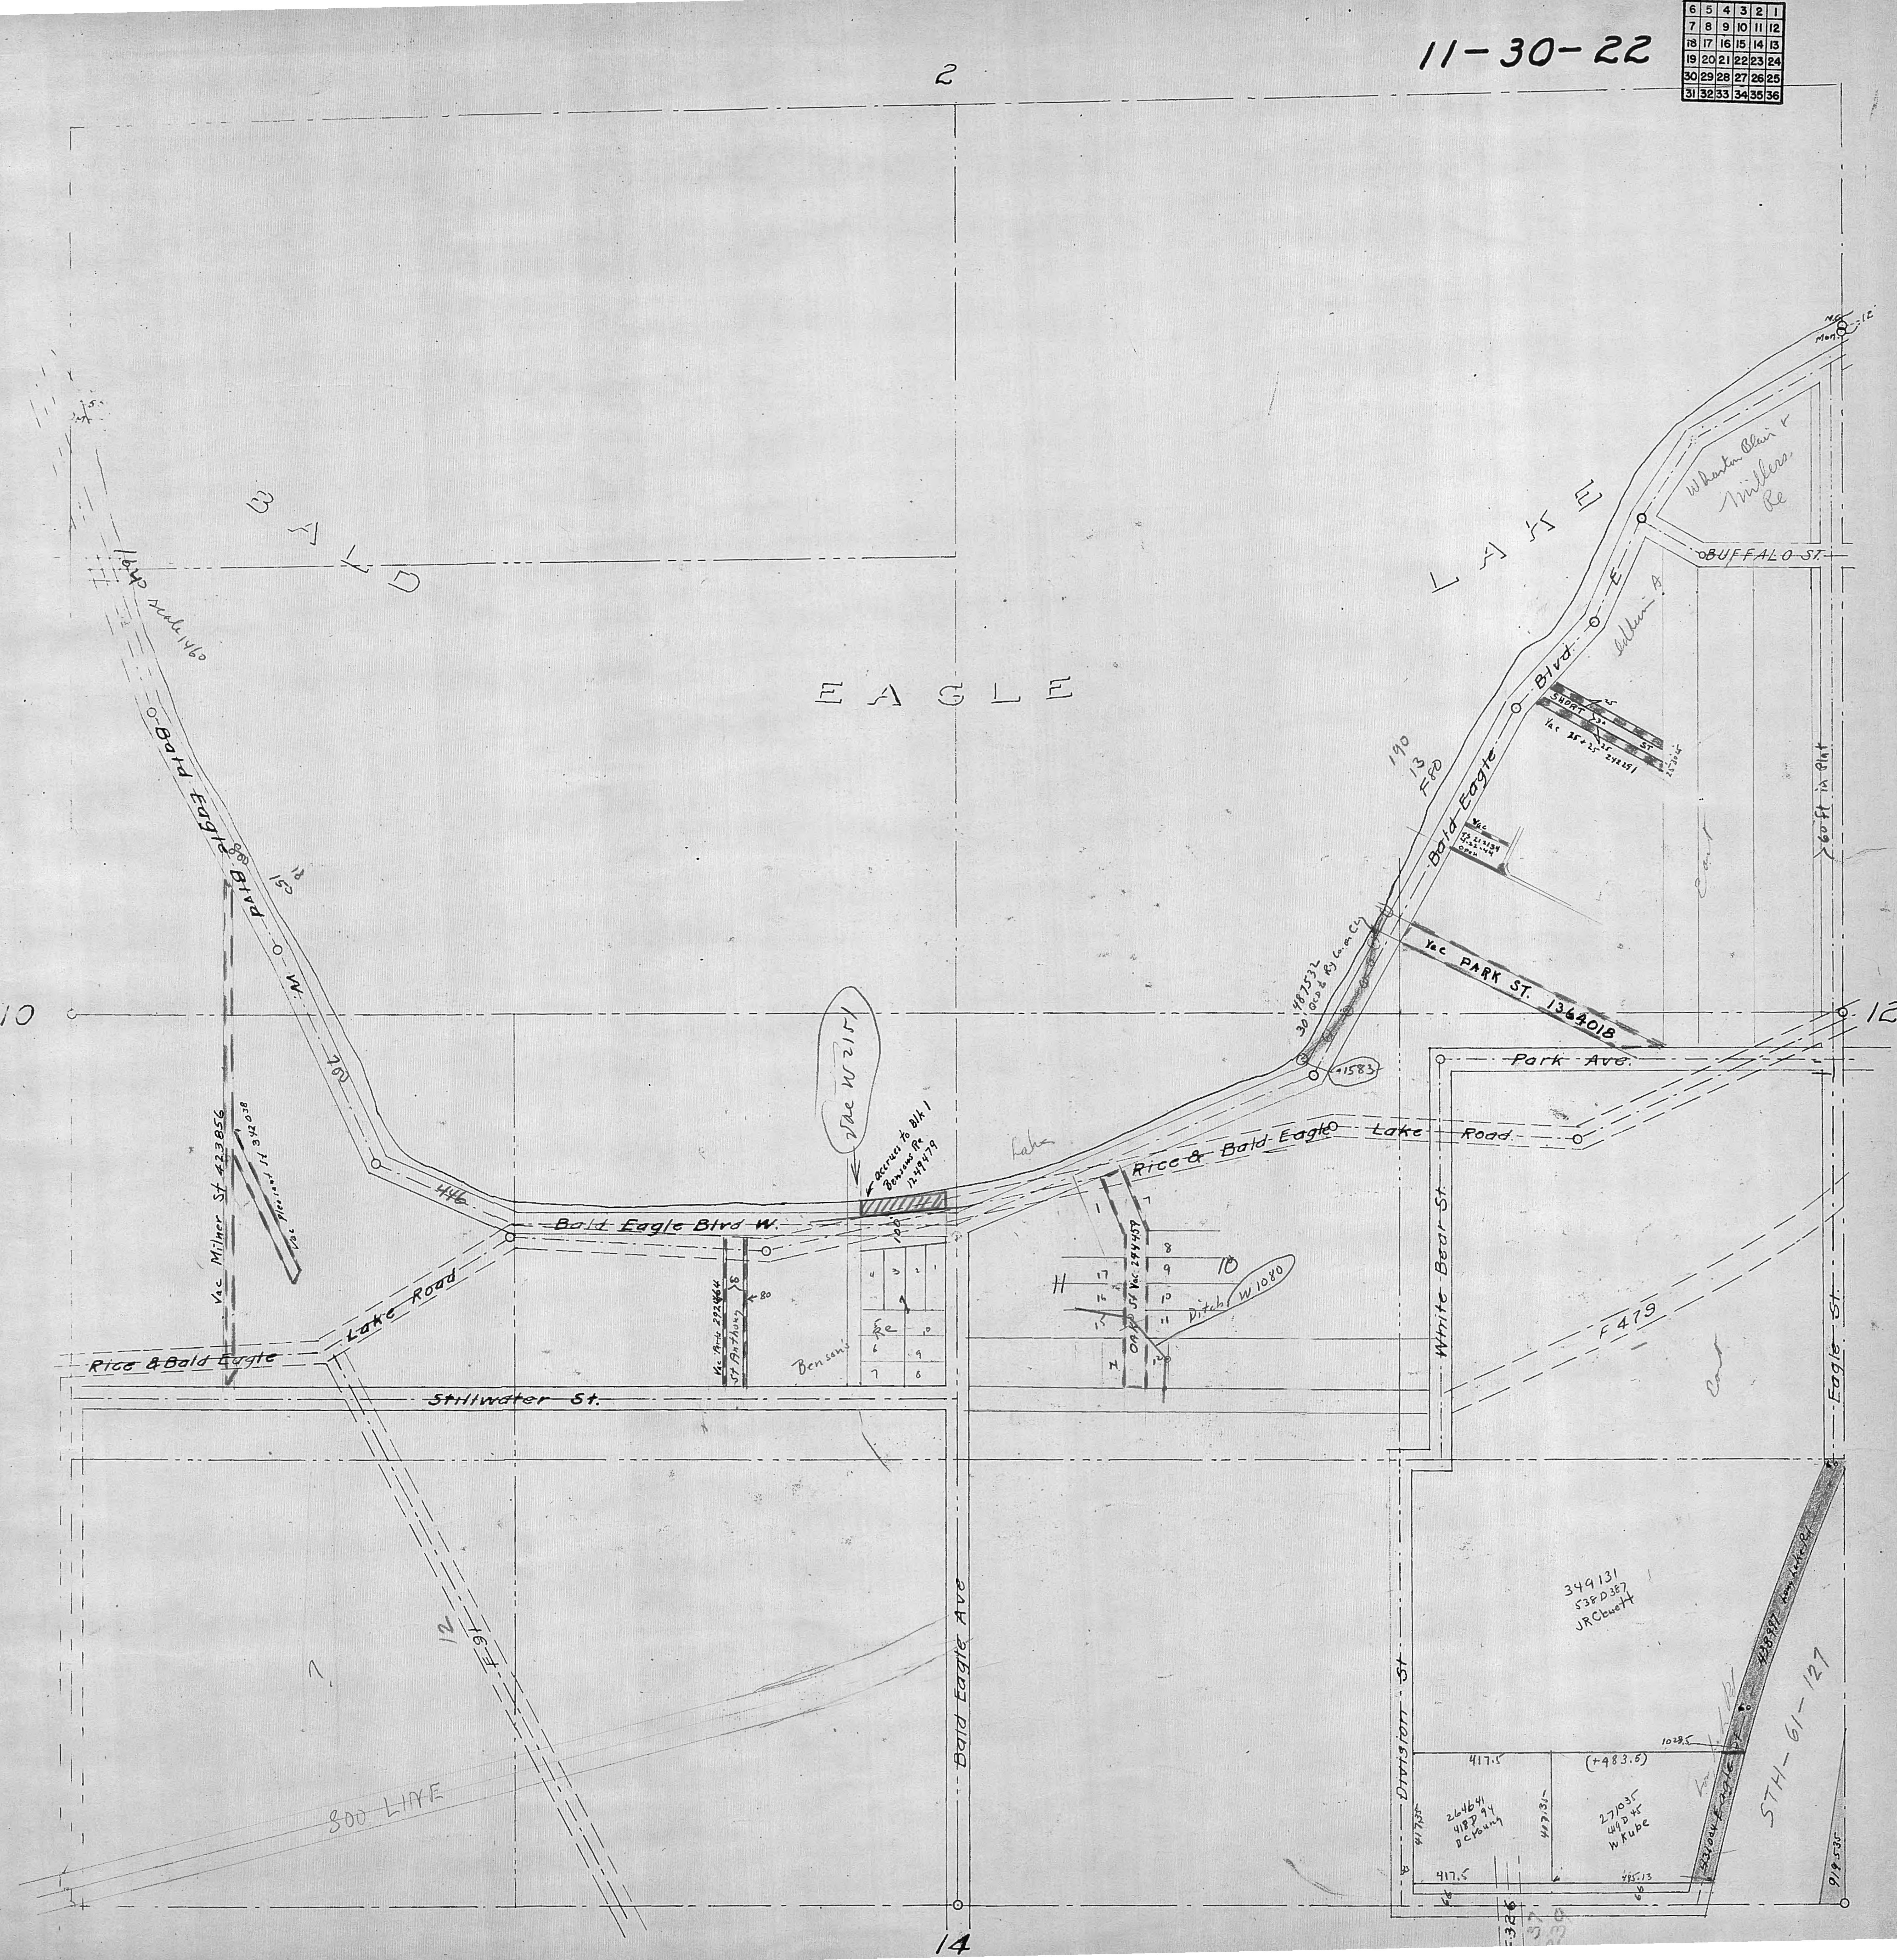

11-30-22
6 5 4 3 2 1
7 8 9 10 11 12
18 17 16 15 14 13
19 20 21 22 23 24
30 29 28 27 26 25
31 32 33 34 35 36
2
10
12
14
BALD EAGLE LAKE
Bald Eagle Blvd W.
Bald Eagle Blvd E
scale 1460
Vac Milner St 423856
Vac Pleasant St 342038
Rice & Bald Eagle
Lake Road
Stillwater St.
Vac Parts 292464
St Anthony
Vac W215
accrues to Blk 1 Bensons Re 1249479
Benson's Re
Rice & Bald Eagle Lake Road
OAK St Vac. 244459
Ditch W1080
White Bear St
Park Ave.
Vac PARK ST. 1364018
30' 487532 Oco & Ry Co on CL
+1583
190 13 F80
SHORT ST
Vac 242251
BUFFALO ST.
Wharton Blair & Millers Re
60 ft in Plat
Eagle St.
F479
800 LINE
Bald Eagle Ave
Division St
349131 538D387 JRClewett
264641 418D94 DCYoung
271035 449D45 WKube
417.5
(+483.5)
485.13
1028.5
Eagle St
438997
STH-61-127
919535