


7	8	9	10	11	12
13	14	15	16	17	18
19	20	21	22	23	24
25	26	27	28	29	30
31	32	33	34	35	36

12-30-22
598708 Taylor

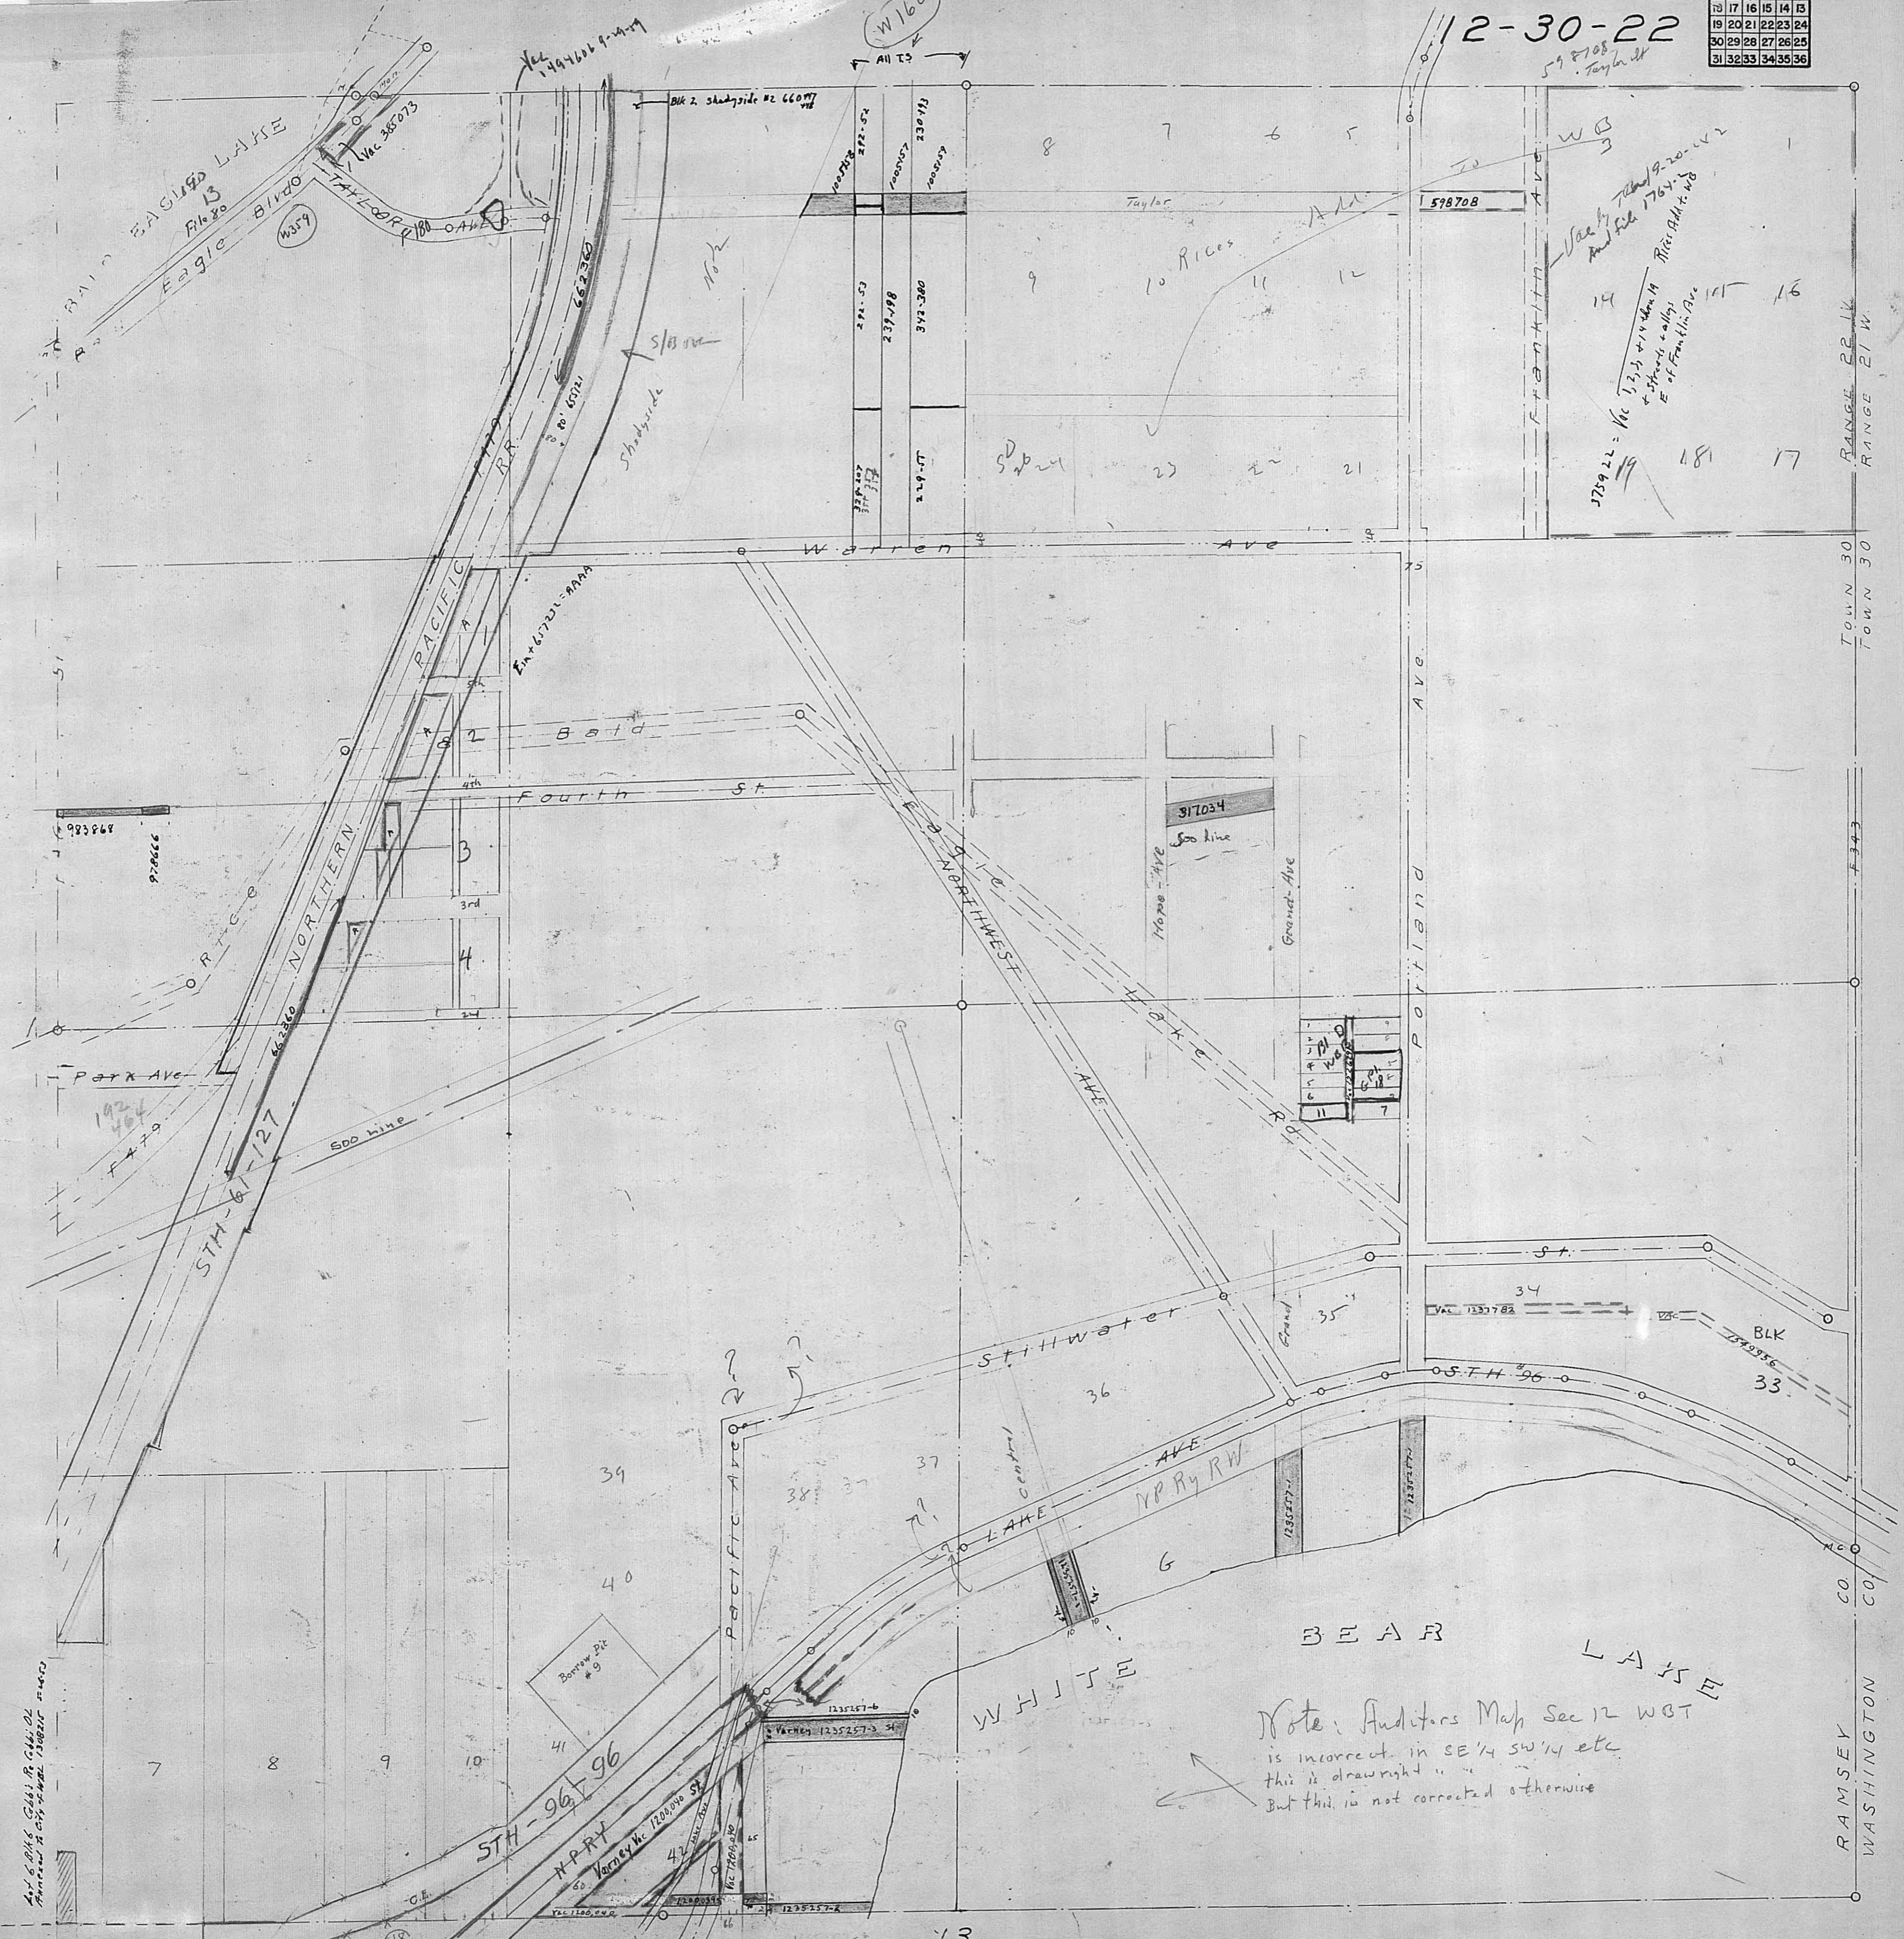

Note: Auditors Map Sec 12 WBT is incorrect in SE 1/4 SW 1/4 etc this is drawn right but this is not corrected otherwise