


27-30-22

6	5	4	3	2	1
7	8	9	10	11	12
13	14	15	16	17	18
19	20	21	22	23	24
25	26	27	28	29	30
31	32	33	34	35	36

57461

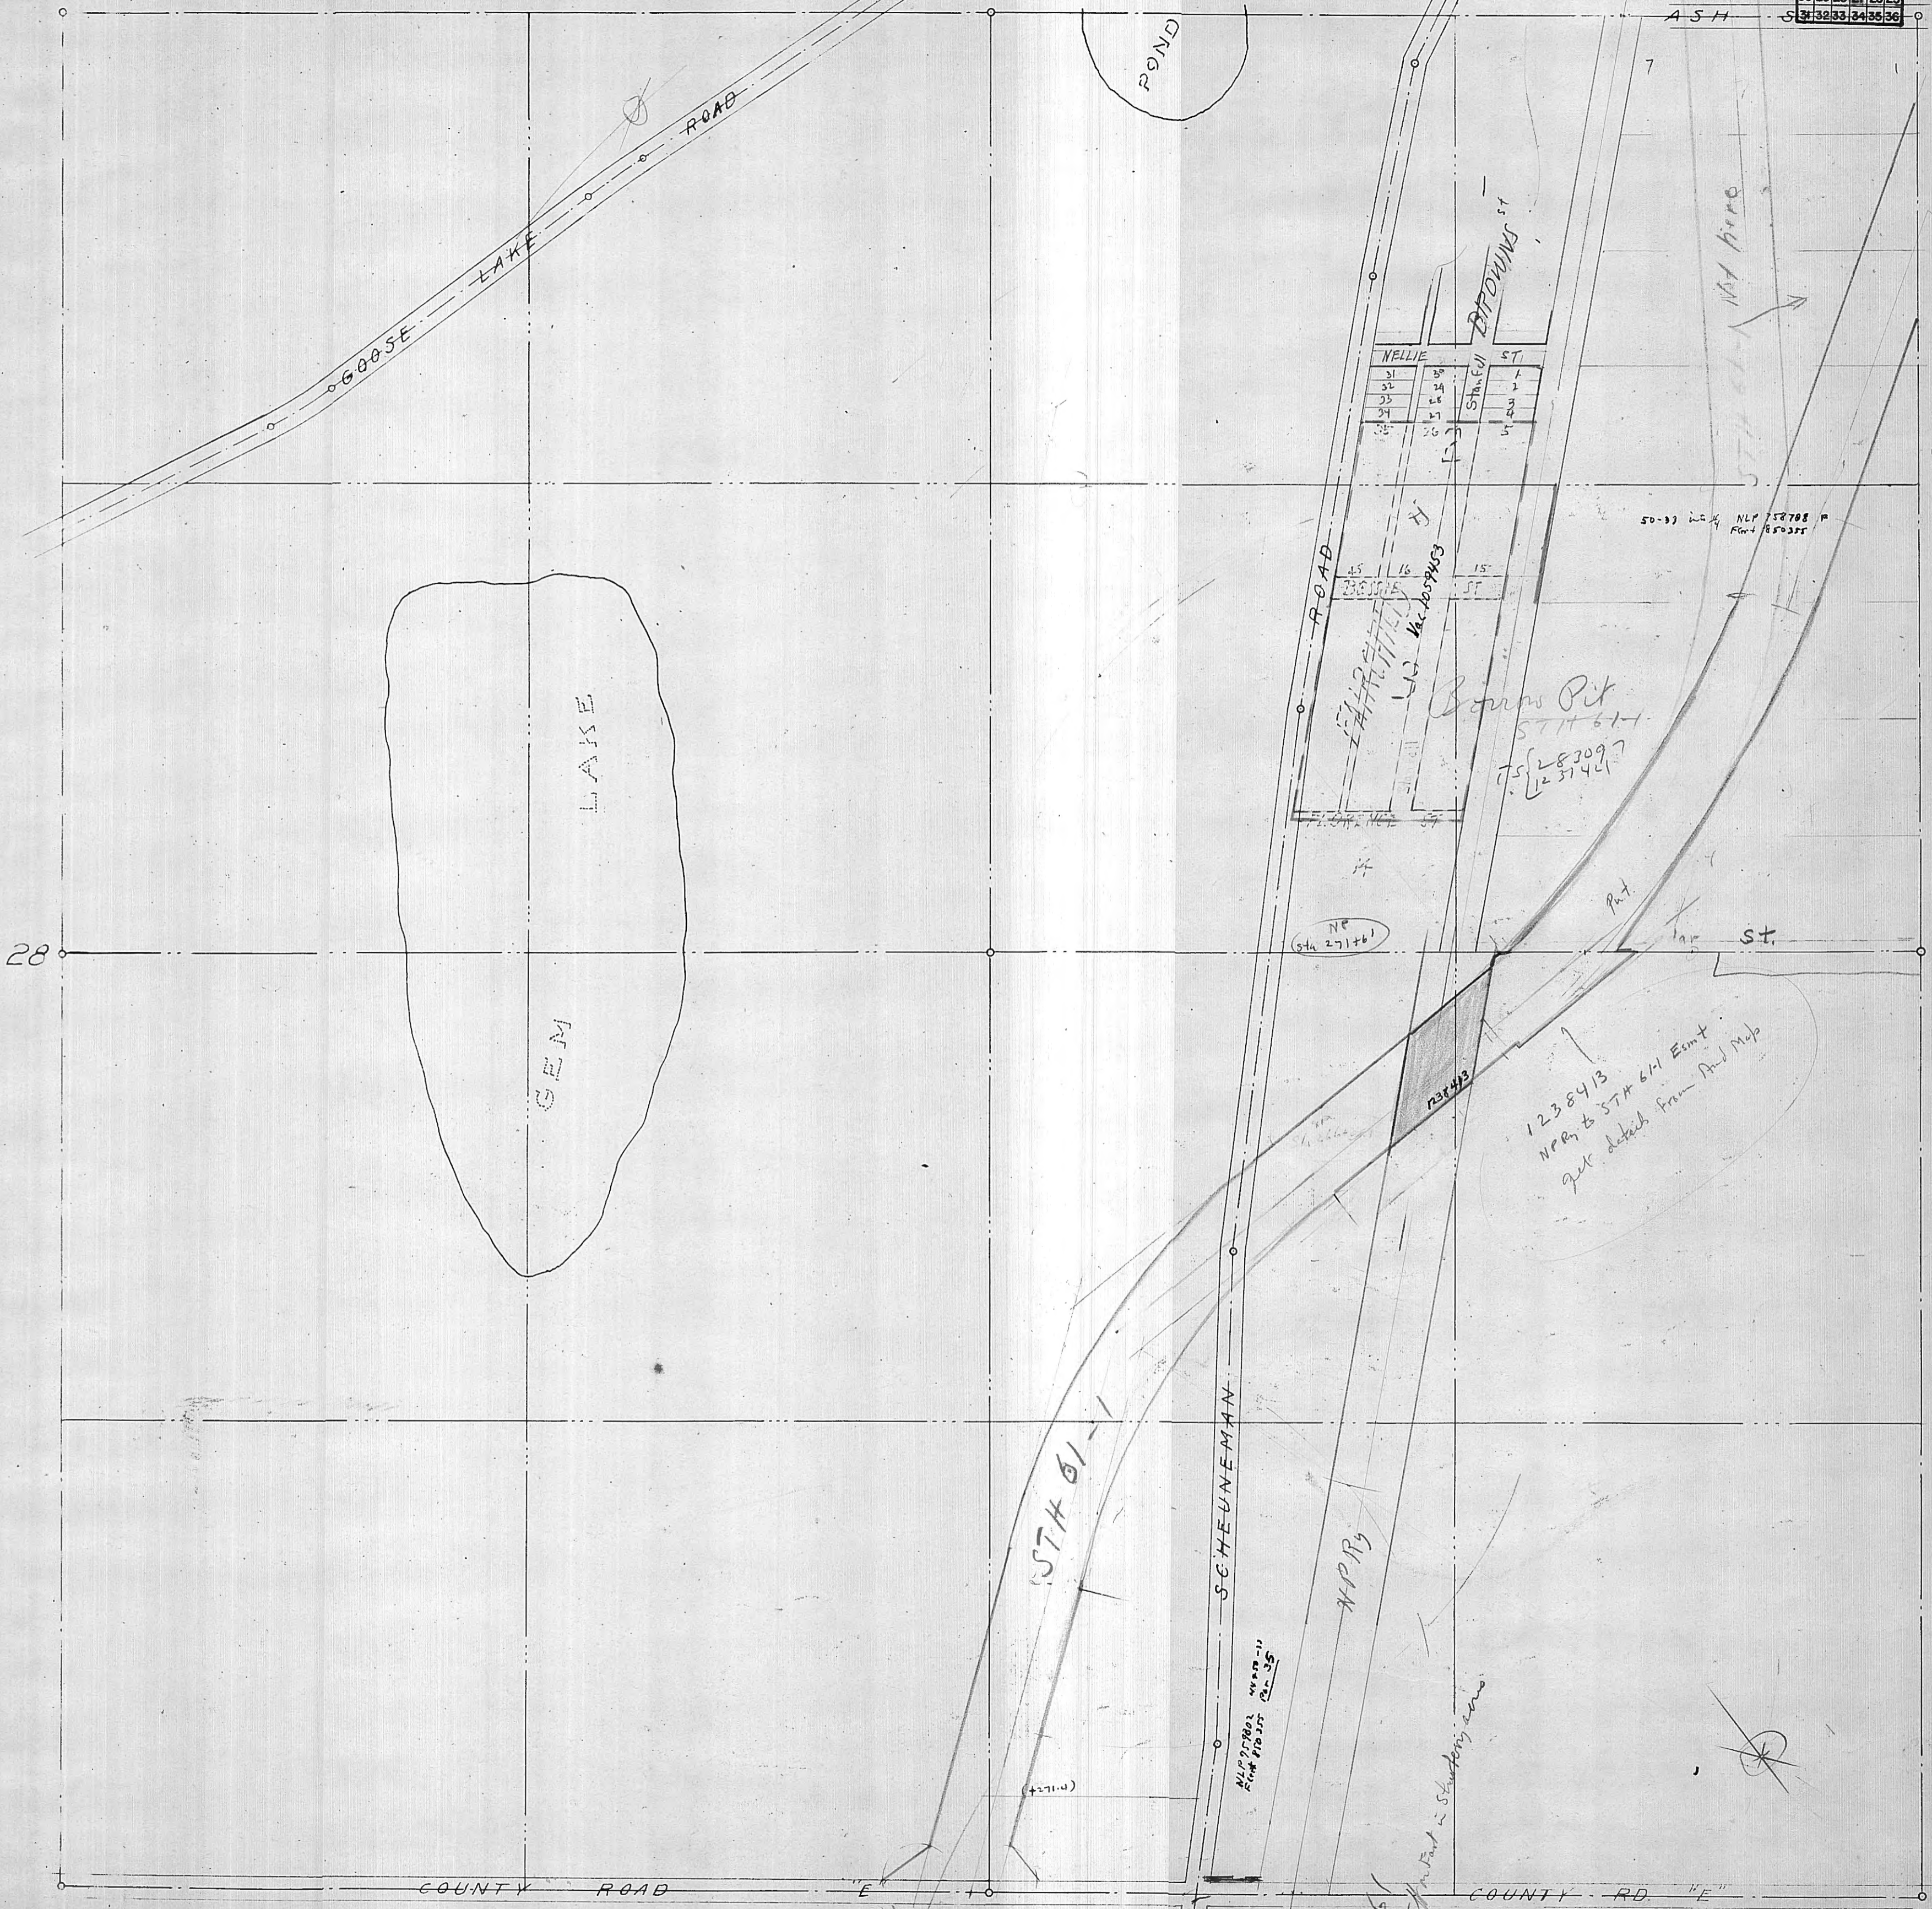

50-32 NLP 75208 P
Rm+ R50355

57461
1238413
NPR 13
get details from Pond Map


NP
Sta 27+61

NLP 27201
Rm+ R50355

57461
