


| | | | | | |
|----|----|----|----|----|----|
| 6 | 5 | 4 | 3 | 2 | 1 |
| 7 | 8 | 9 | 10 | 11 | 12 |
| 13 | 14 | 15 | 16 | 17 | 18 |
| 19 | 20 | 21 | 22 | 23 | 24 |
| 25 | 26 | 27 | 28 | 29 | 30 |
| 31 | 32 | 33 | 34 | 35 | 36 |

20

29-30-22

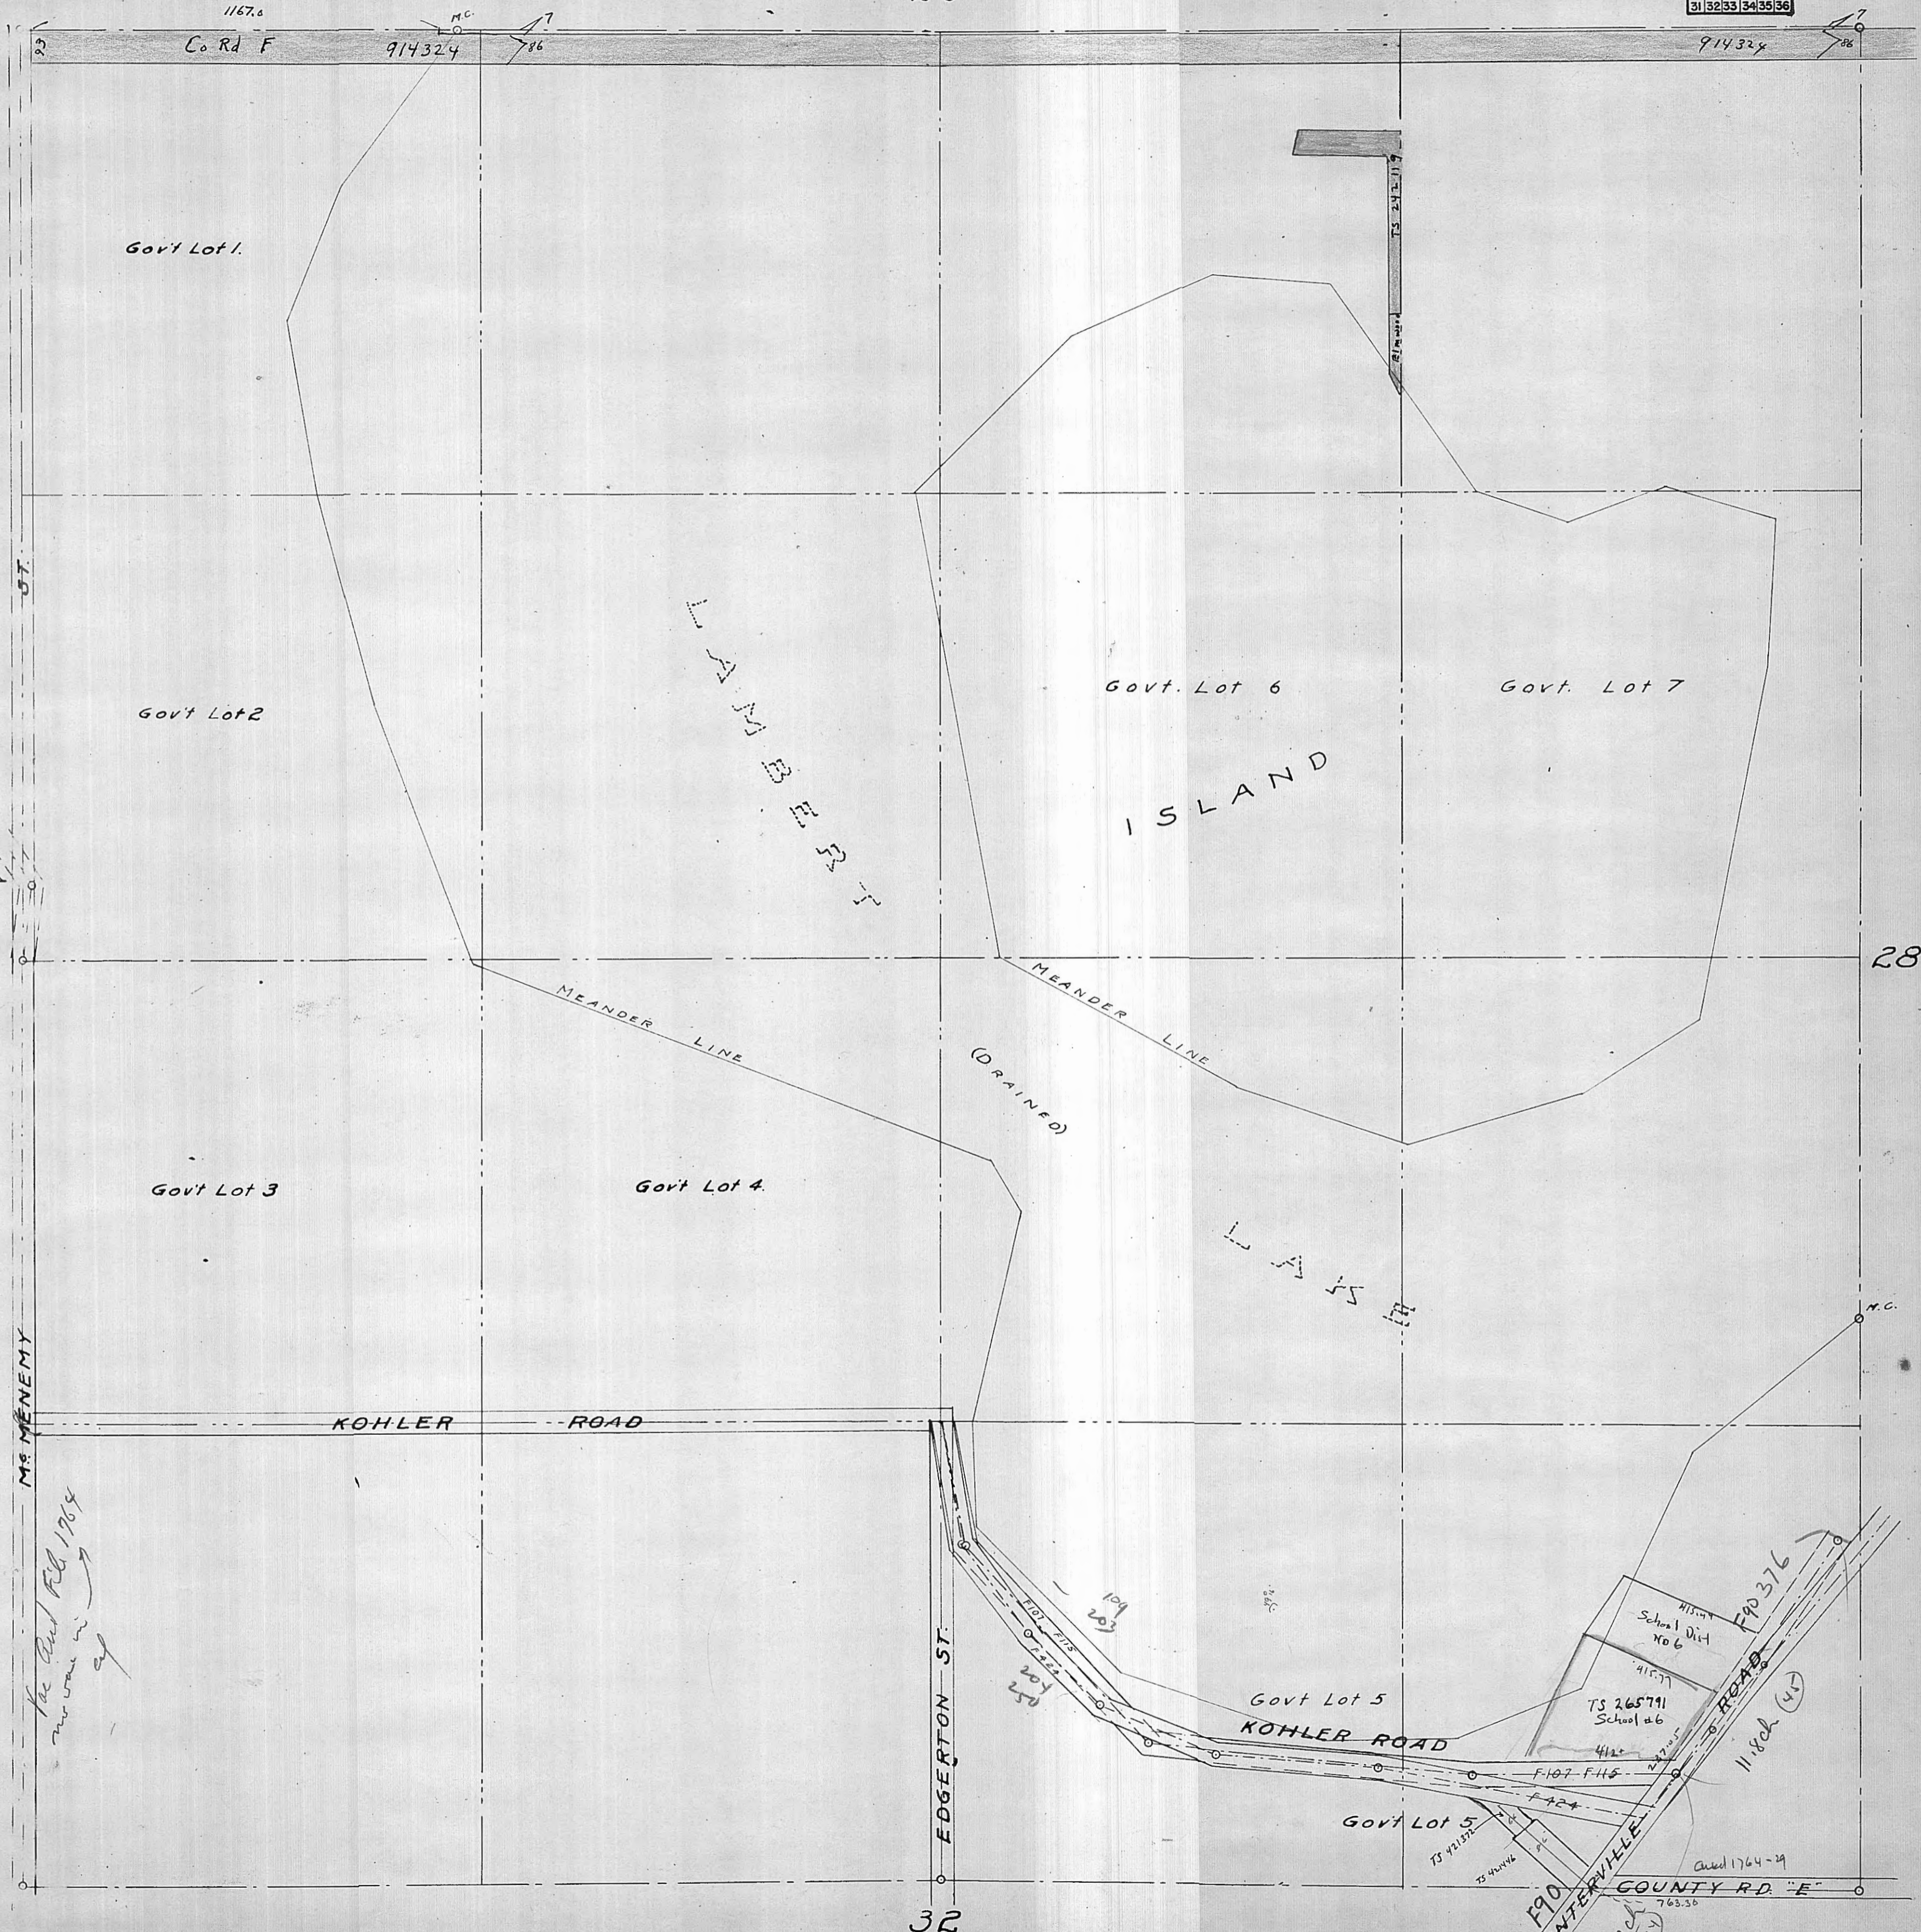

1167.6
Co Rd F
914324

914324

Govt Lot 1.

Govt Lot 2

Govt Lot 3

Govt Lot 4.

Govt. Lot 6

Govt. Lot 7

L A M B E R T

I S L A N D

MEANDER LINE

(DRAINED)

MEANDER LINE

L A S E

KOHLER ROAD

EDGERTON ST.

Govt Lot 5

KOHLER ROAD

Govt Lot 5

COUNTY RD. "E"

MS. MENEMY

See Ord. 1764
no more in
of

School Dist No 6

TS 265791 School #6

Ord 1764-24

W.P.A. O.P. No. 65-1-71-2668

3-21-22