


11-30-23

6	5	4	3	2	1
7	8	9	10	11	12
18	17	16	15	14	13
19	20	21	22	23	24
30	29	28	27	26	25
31	32	33	34	35	36

2

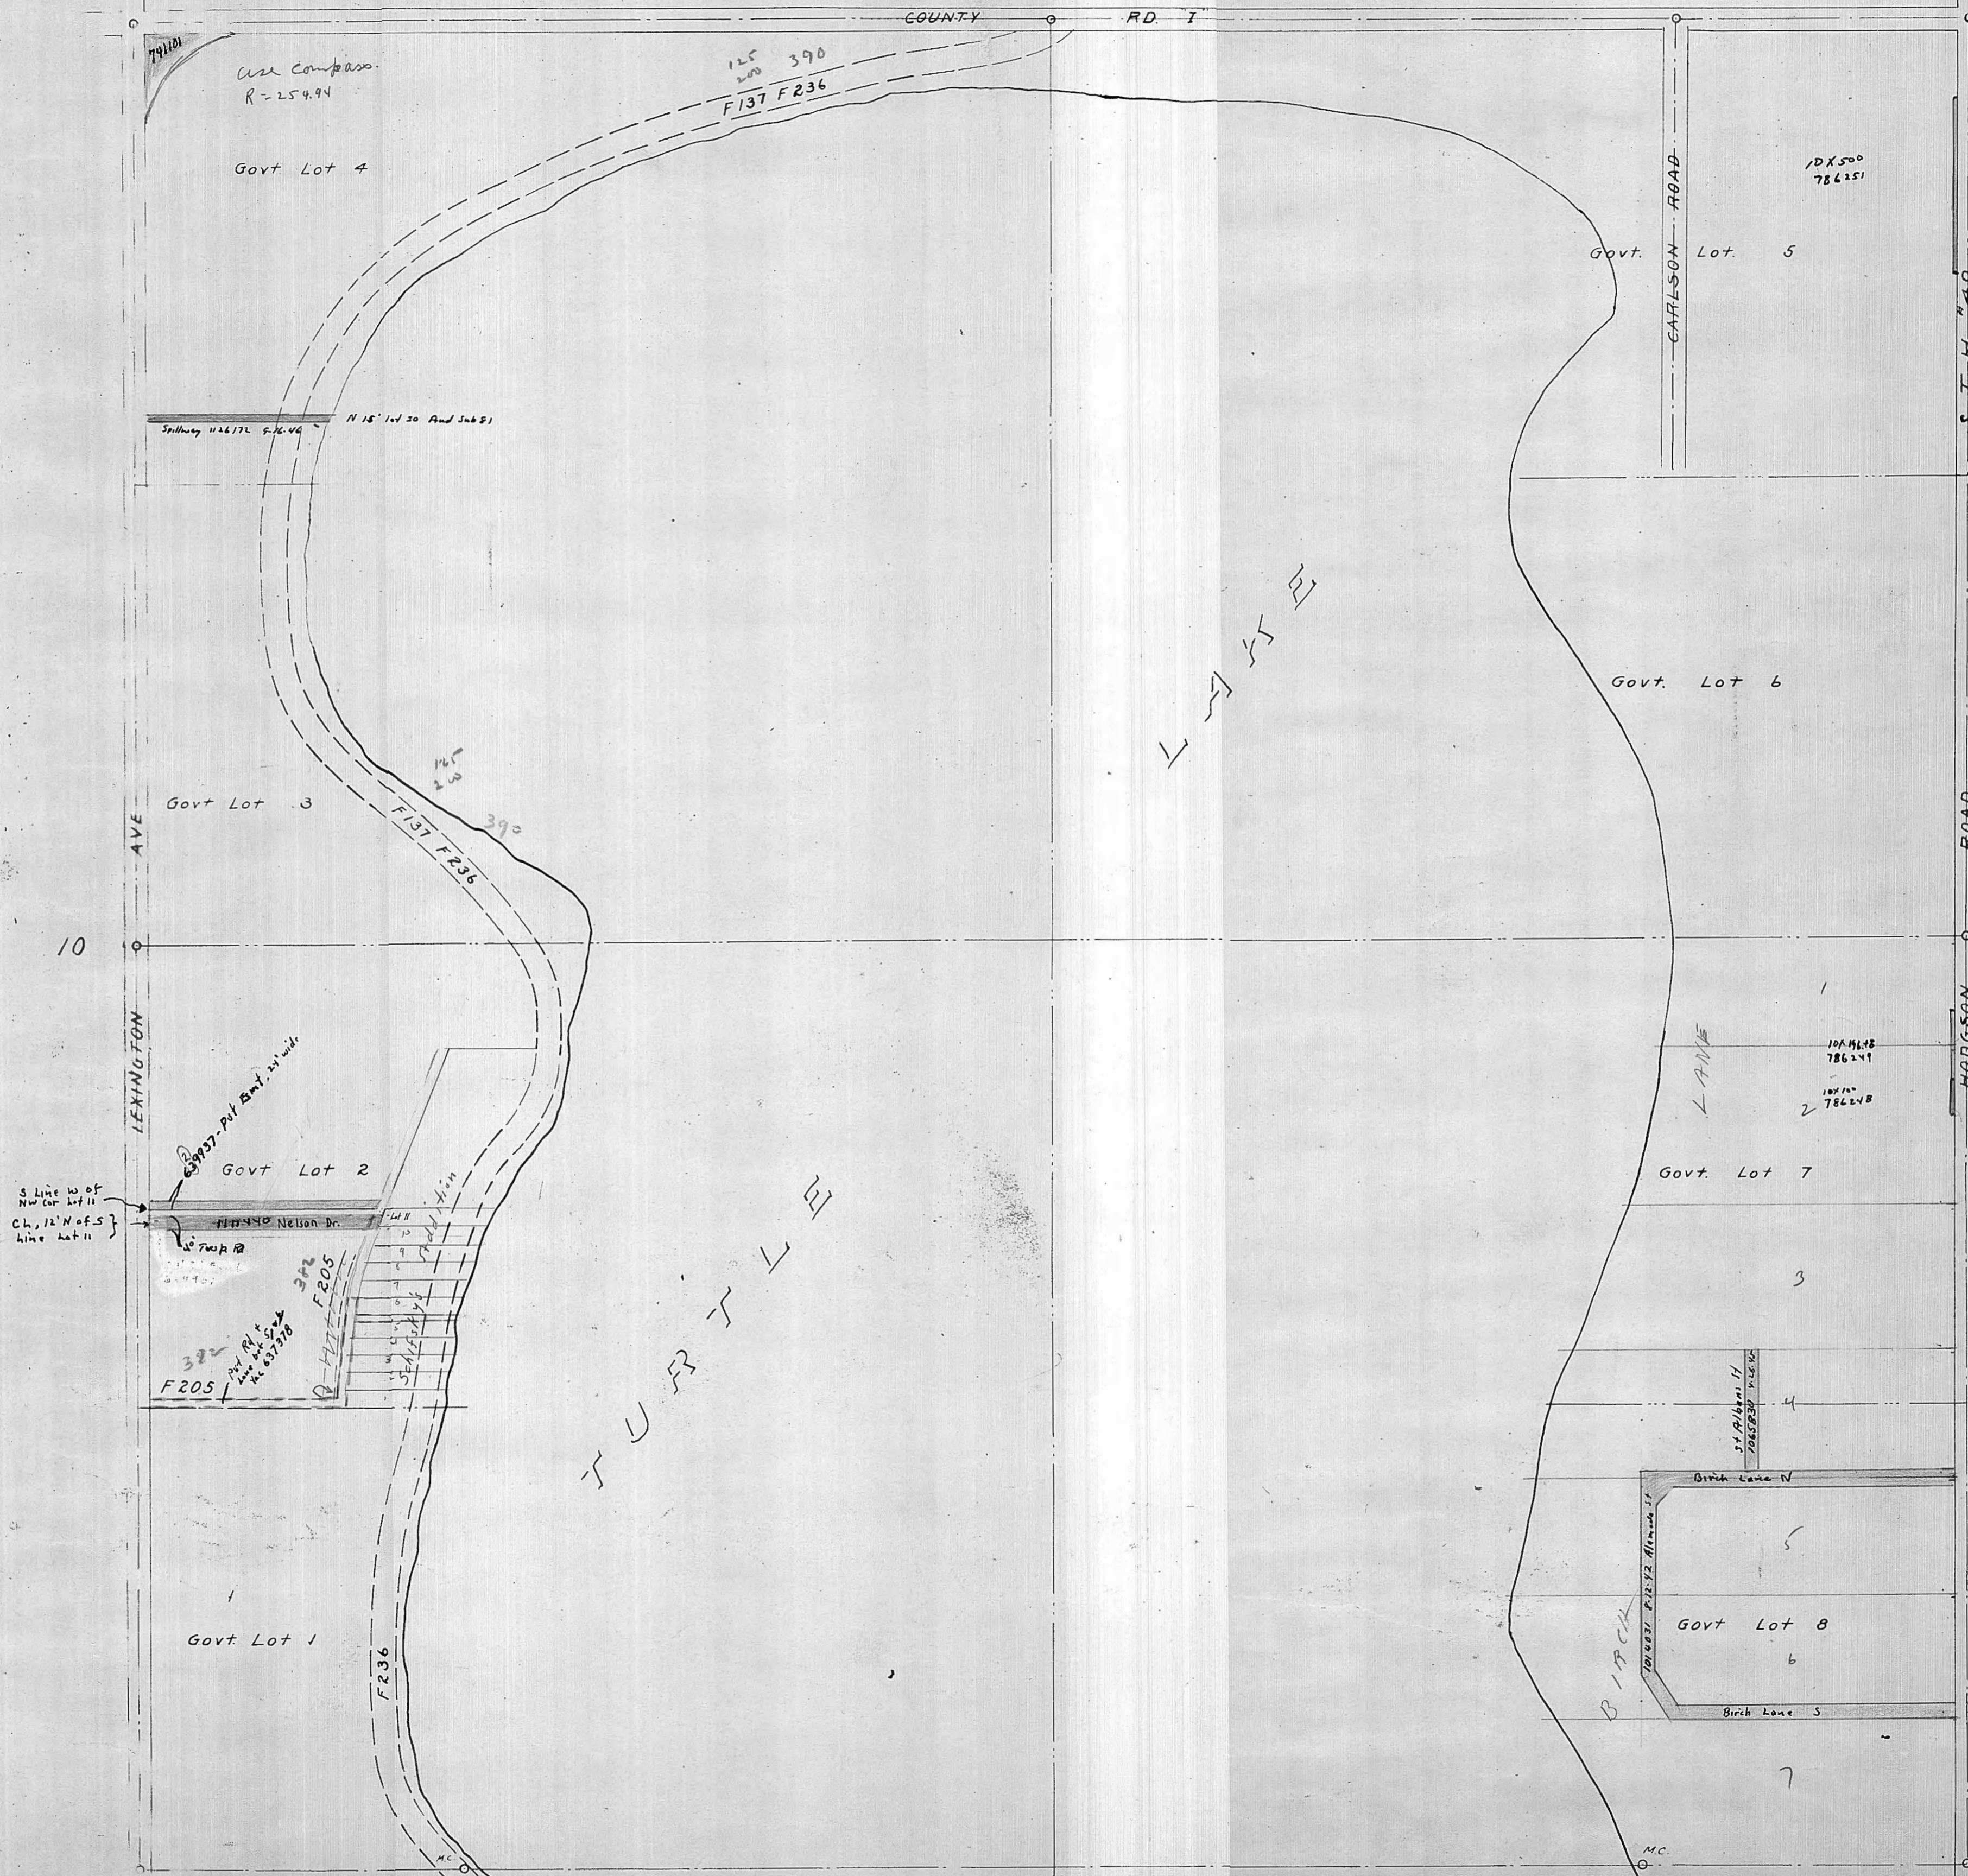

Use Compass.
R=254.94

125
200 390
F137 F236

Govt Lot 4

Spilling 126172 5-12-46 N 15' lot 30 And Sub S1

DX 500
786251

Govt. Lot 5

Govt. Lot 6

Govt Lot 3

F137 F236
390

10

12

LEXINGTON AVE

HODGSON ROAD

390-37 Pol Bmt. 2nd add.

Govt Lot 2

Nelson Dr.

S line W of
NW Cor lot II
CL, 12' N of S
line lot II

F205
322
302
F205

10741-38
786241
10741-38
786248

Govt. Lot 7

T U R T L E

Govt Lot 1

F236

St. Albans St
2065230 1/2 AC

Birch Lane IV

Govt Lot 8

Birch Lane S

1977 Birch Lane

14

W. P. A. O. P.
No. 65-1-71-2668