

6	5	4	3	2	1
7	8	9	10	11	12
13	14	15	16	17	18
19	20	21	22	23	24
25	26	27	28	29	30
31	32	33	34	35	36

16-30-23

9


380  
658

380  
658

Locate Cor  
77806

Locate Cor  
77803

Locate Cor  
77807

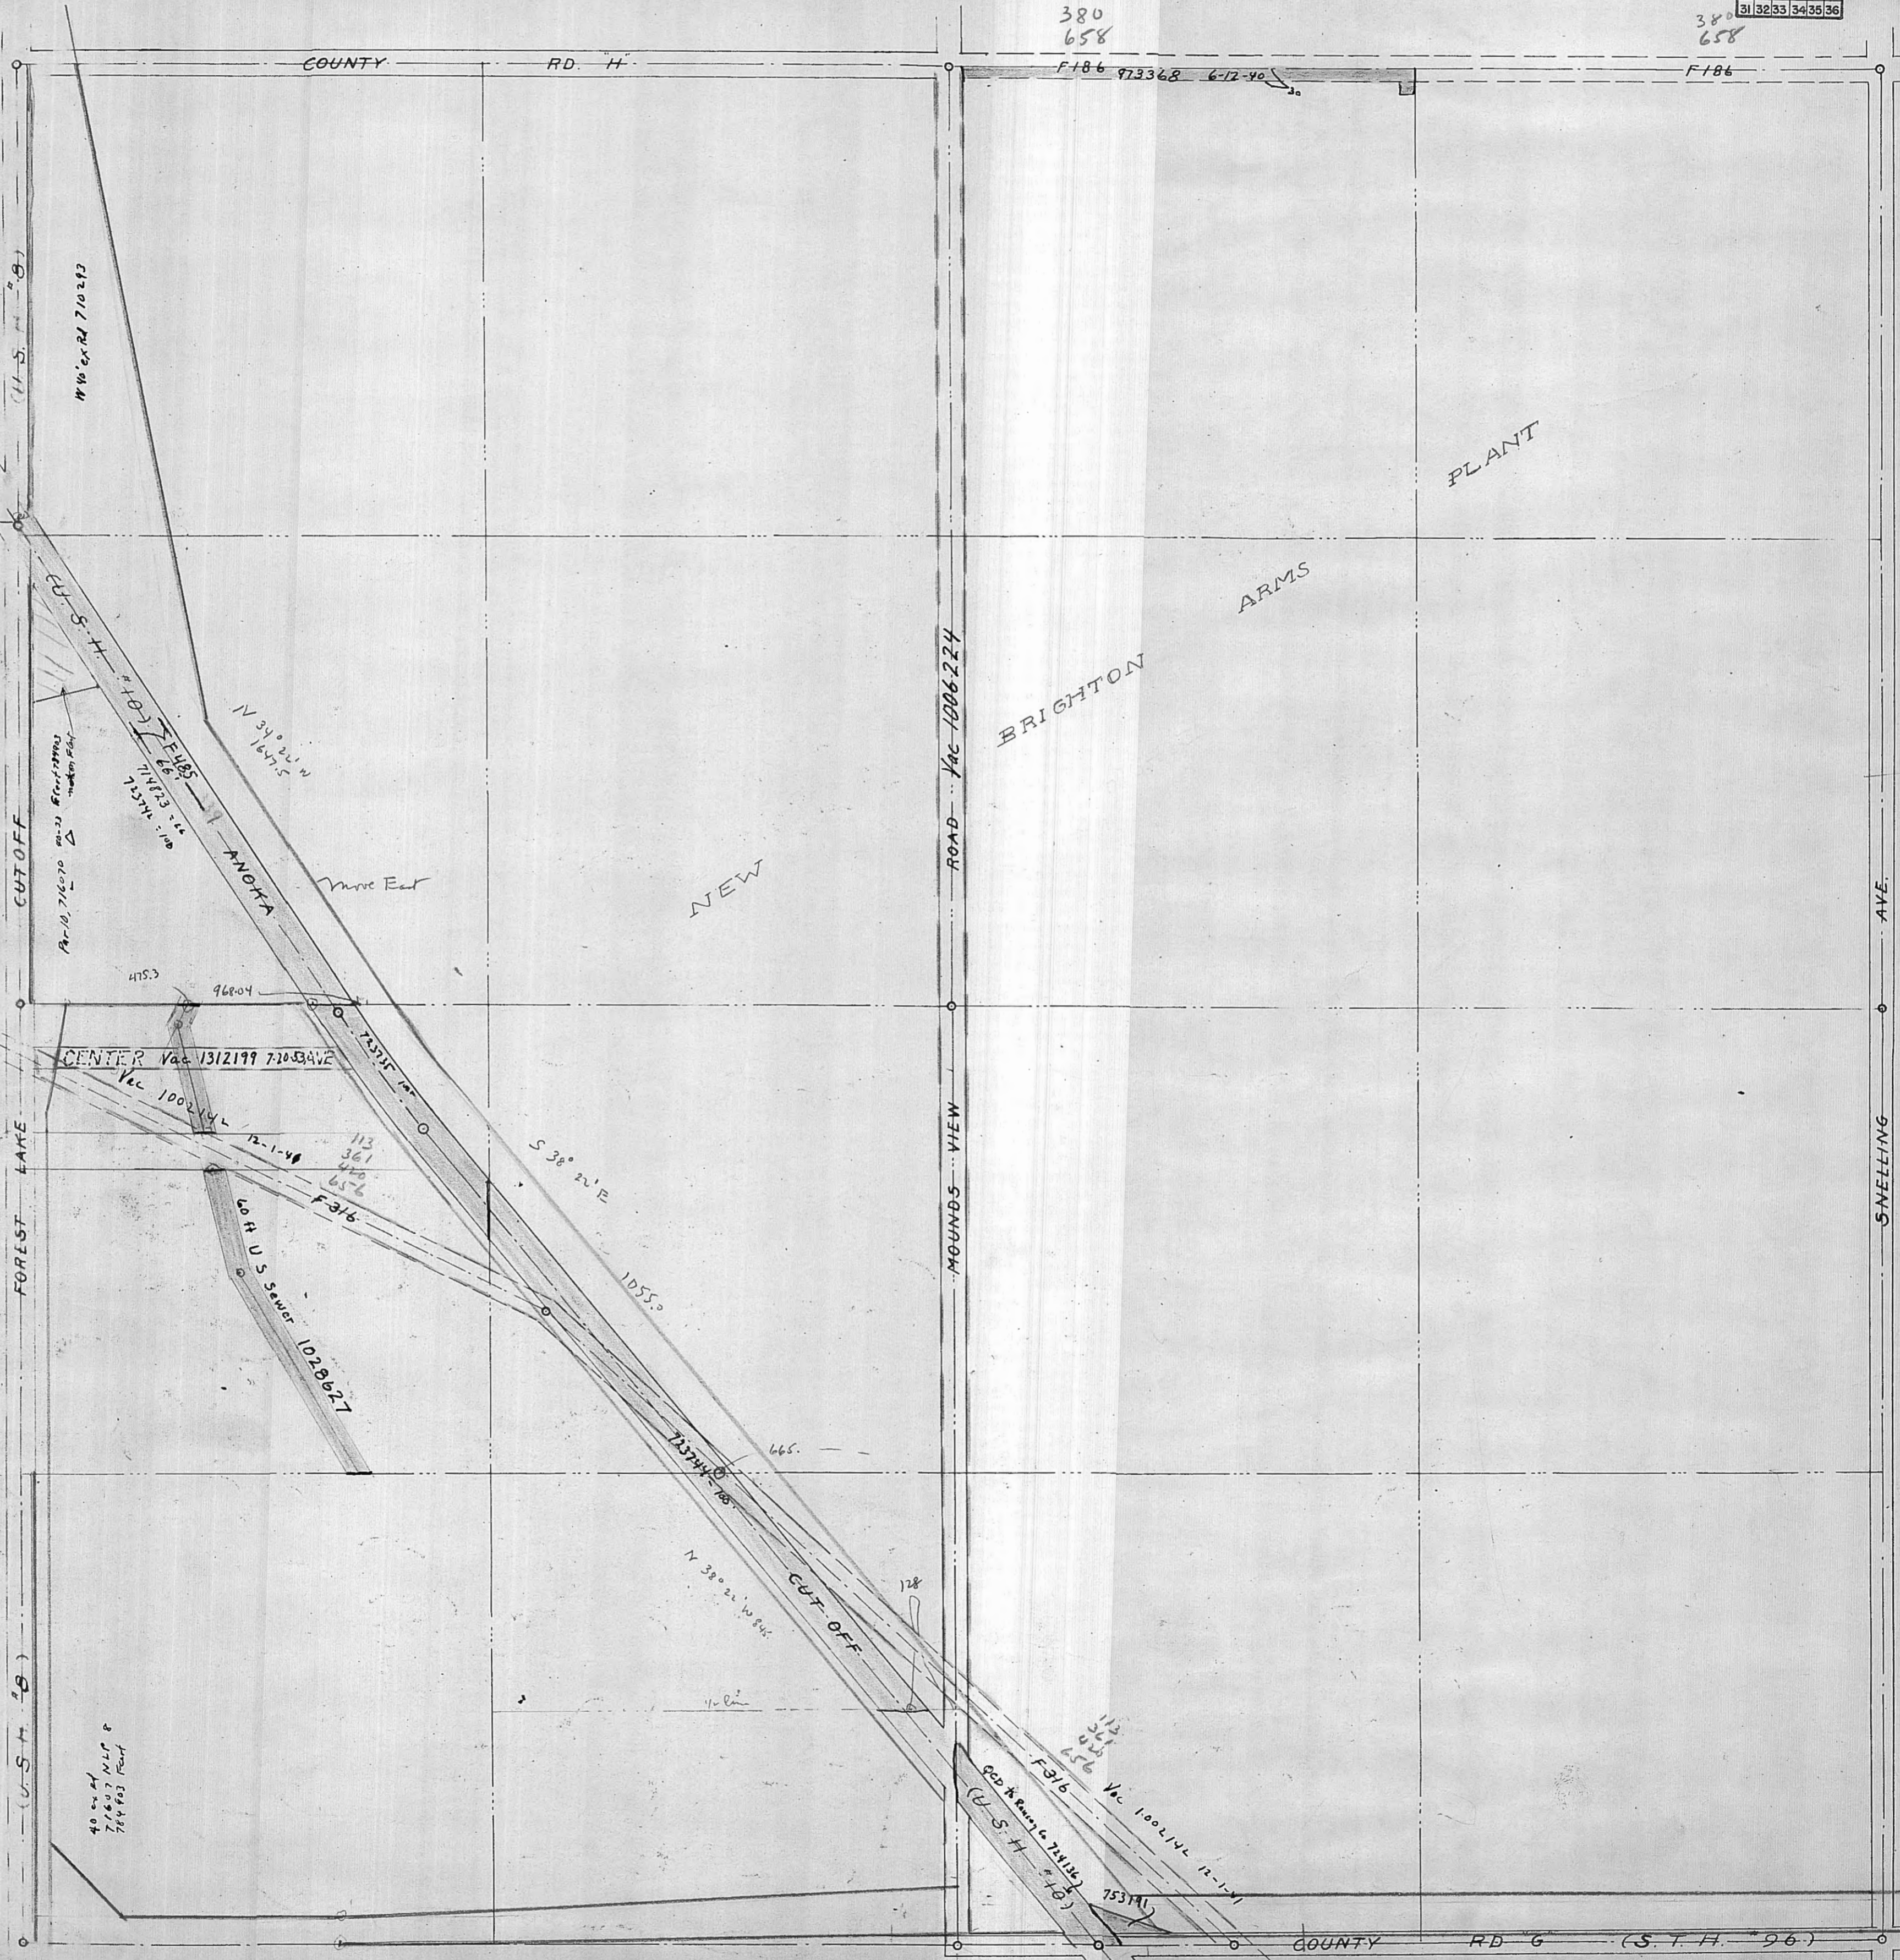

15

SNELLING AVE.