


6	5	4	3	2	1
7	8	9	10	11	12
13	14	15	16	17	18
19	20	21	22	23	24
25	26	27	28	29	30
31	32	33	34	35	36

66-17-30-23
 F 485
 714823

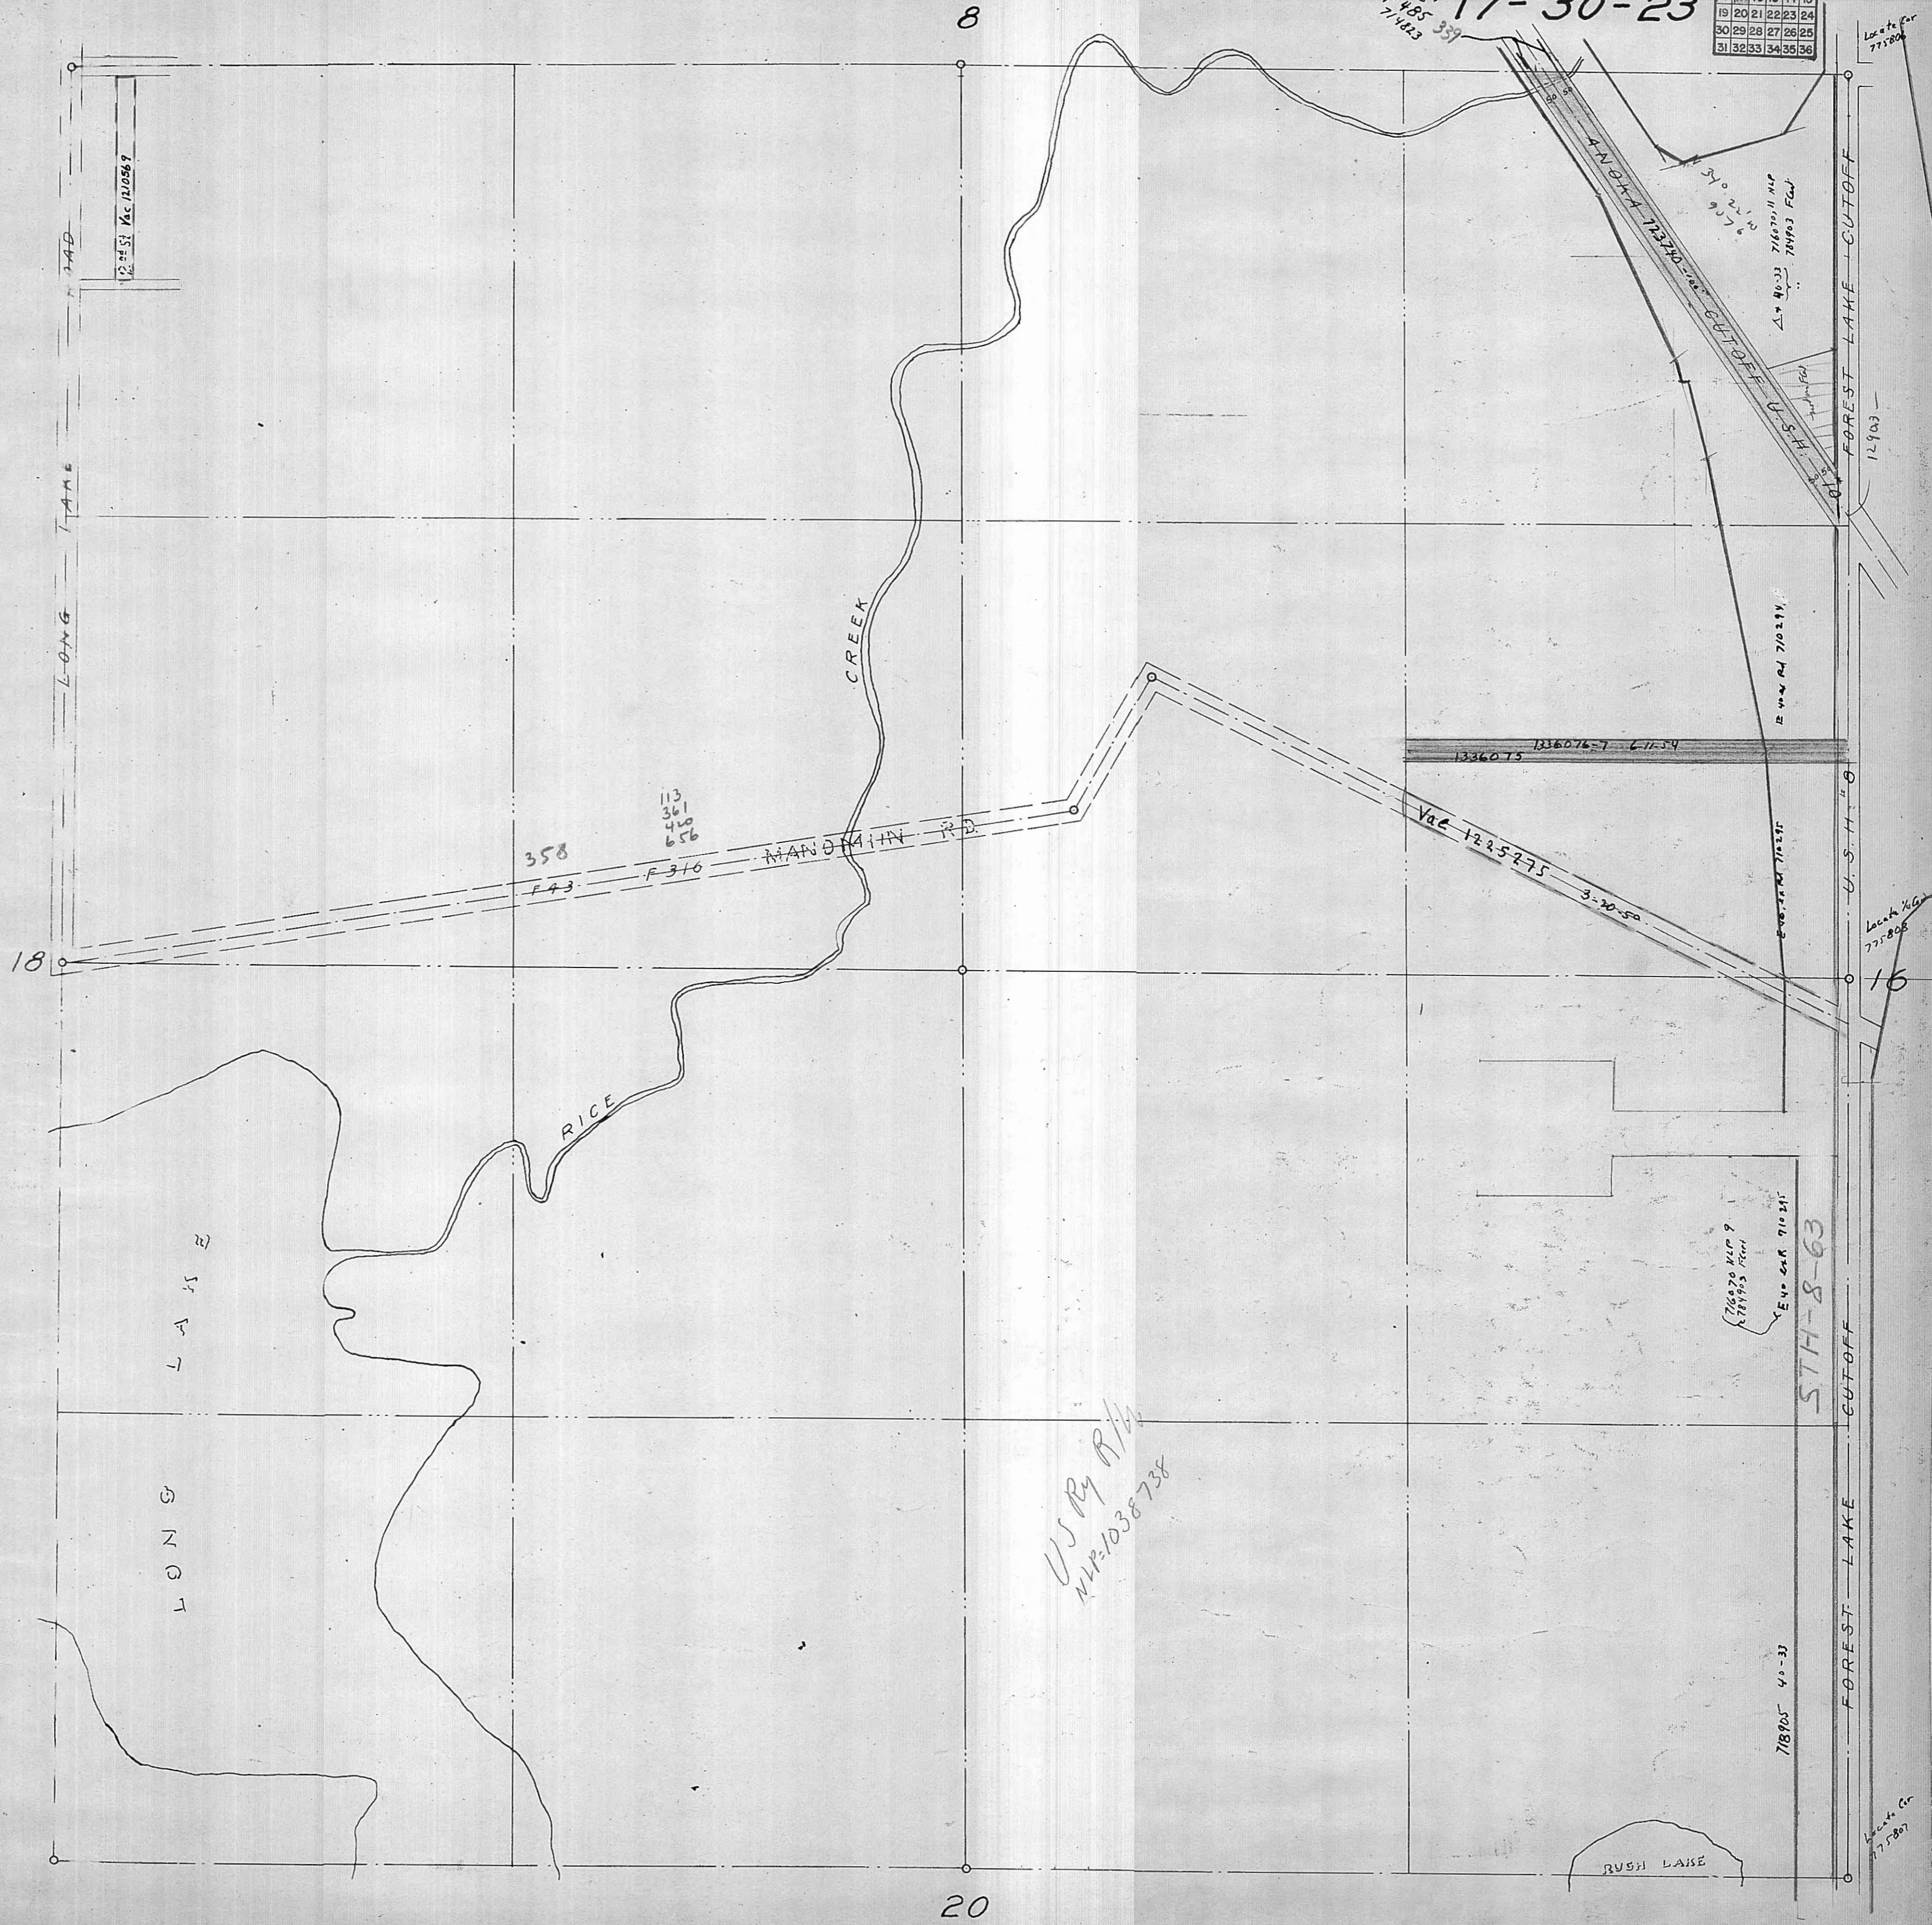

US By R/W
 NHP-1038738

RUSH LAISE