


24-30-23

6	5	4	3	2	1
7	8	9	10	11	12
31	32	33	34	35	36

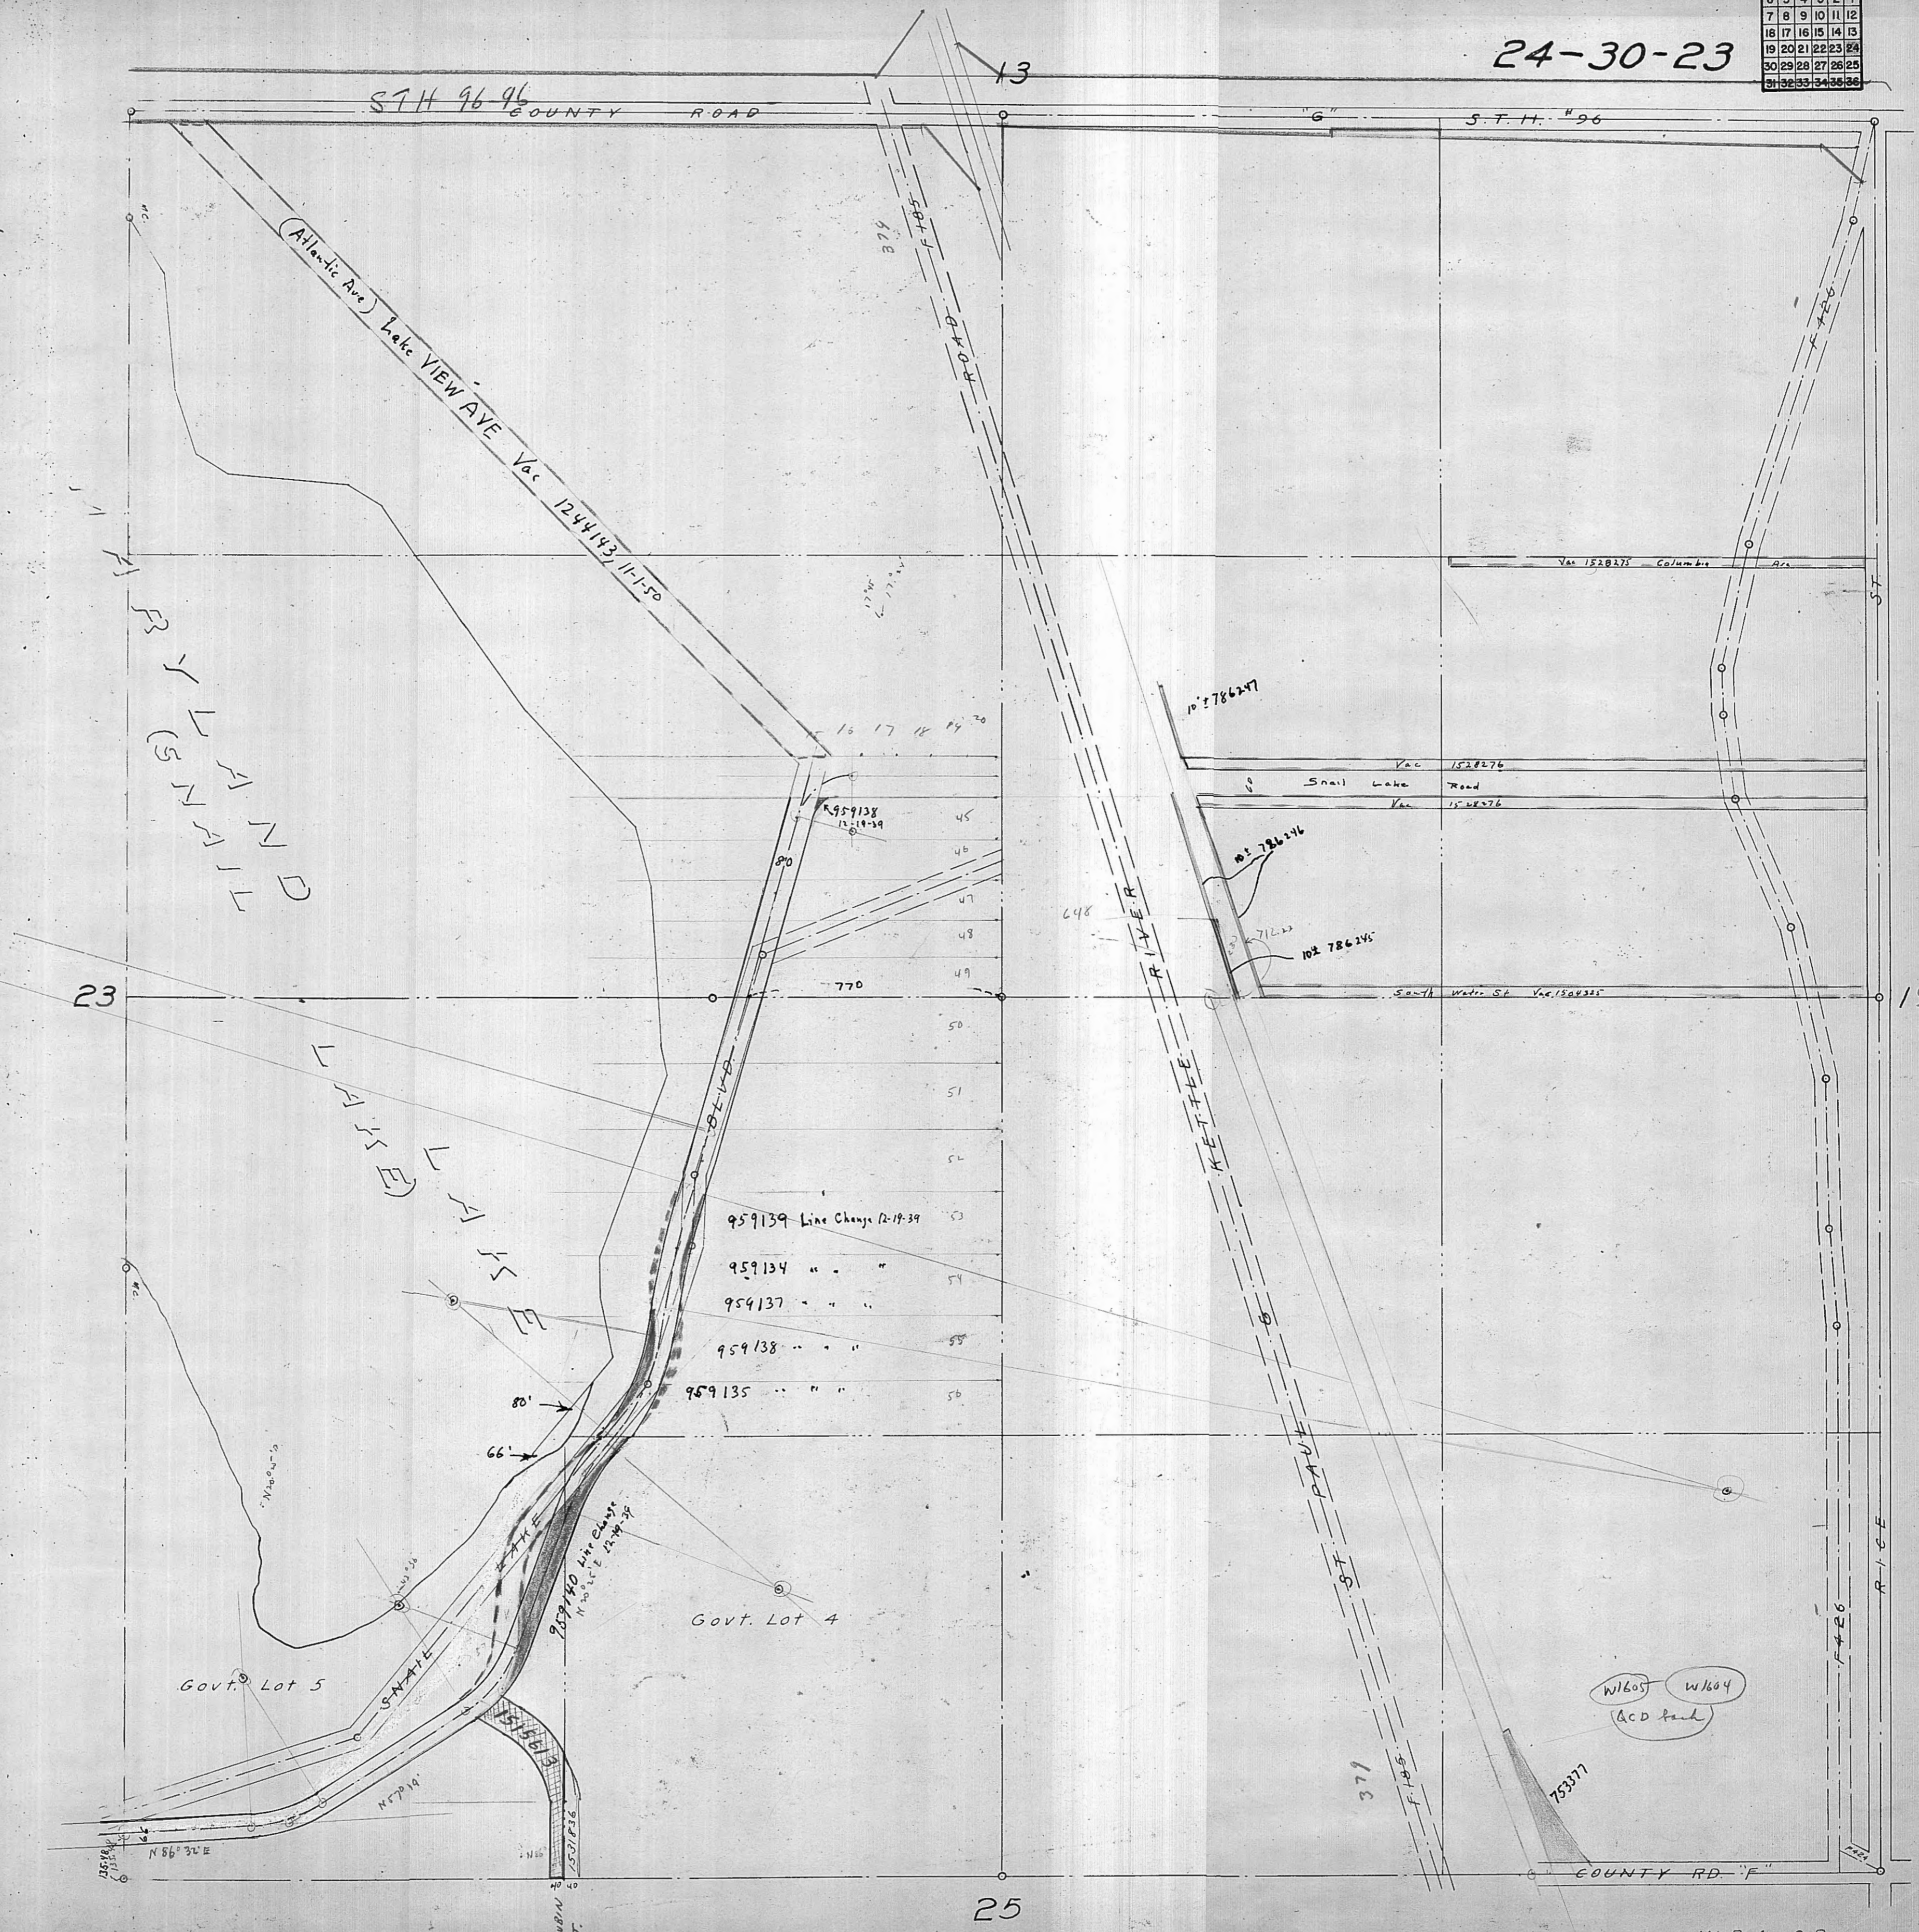


Govt. Lot 5

Govt. Lot 4

W1605 W1604
(ACD land)