


6	5	4	3	2	1
7	8	9	10	11	12
13	14	15	16	17	18
19	20	21	22	23	24
25	26	27	28	29	30
31	32	33	34	35	36

26-30-23

23

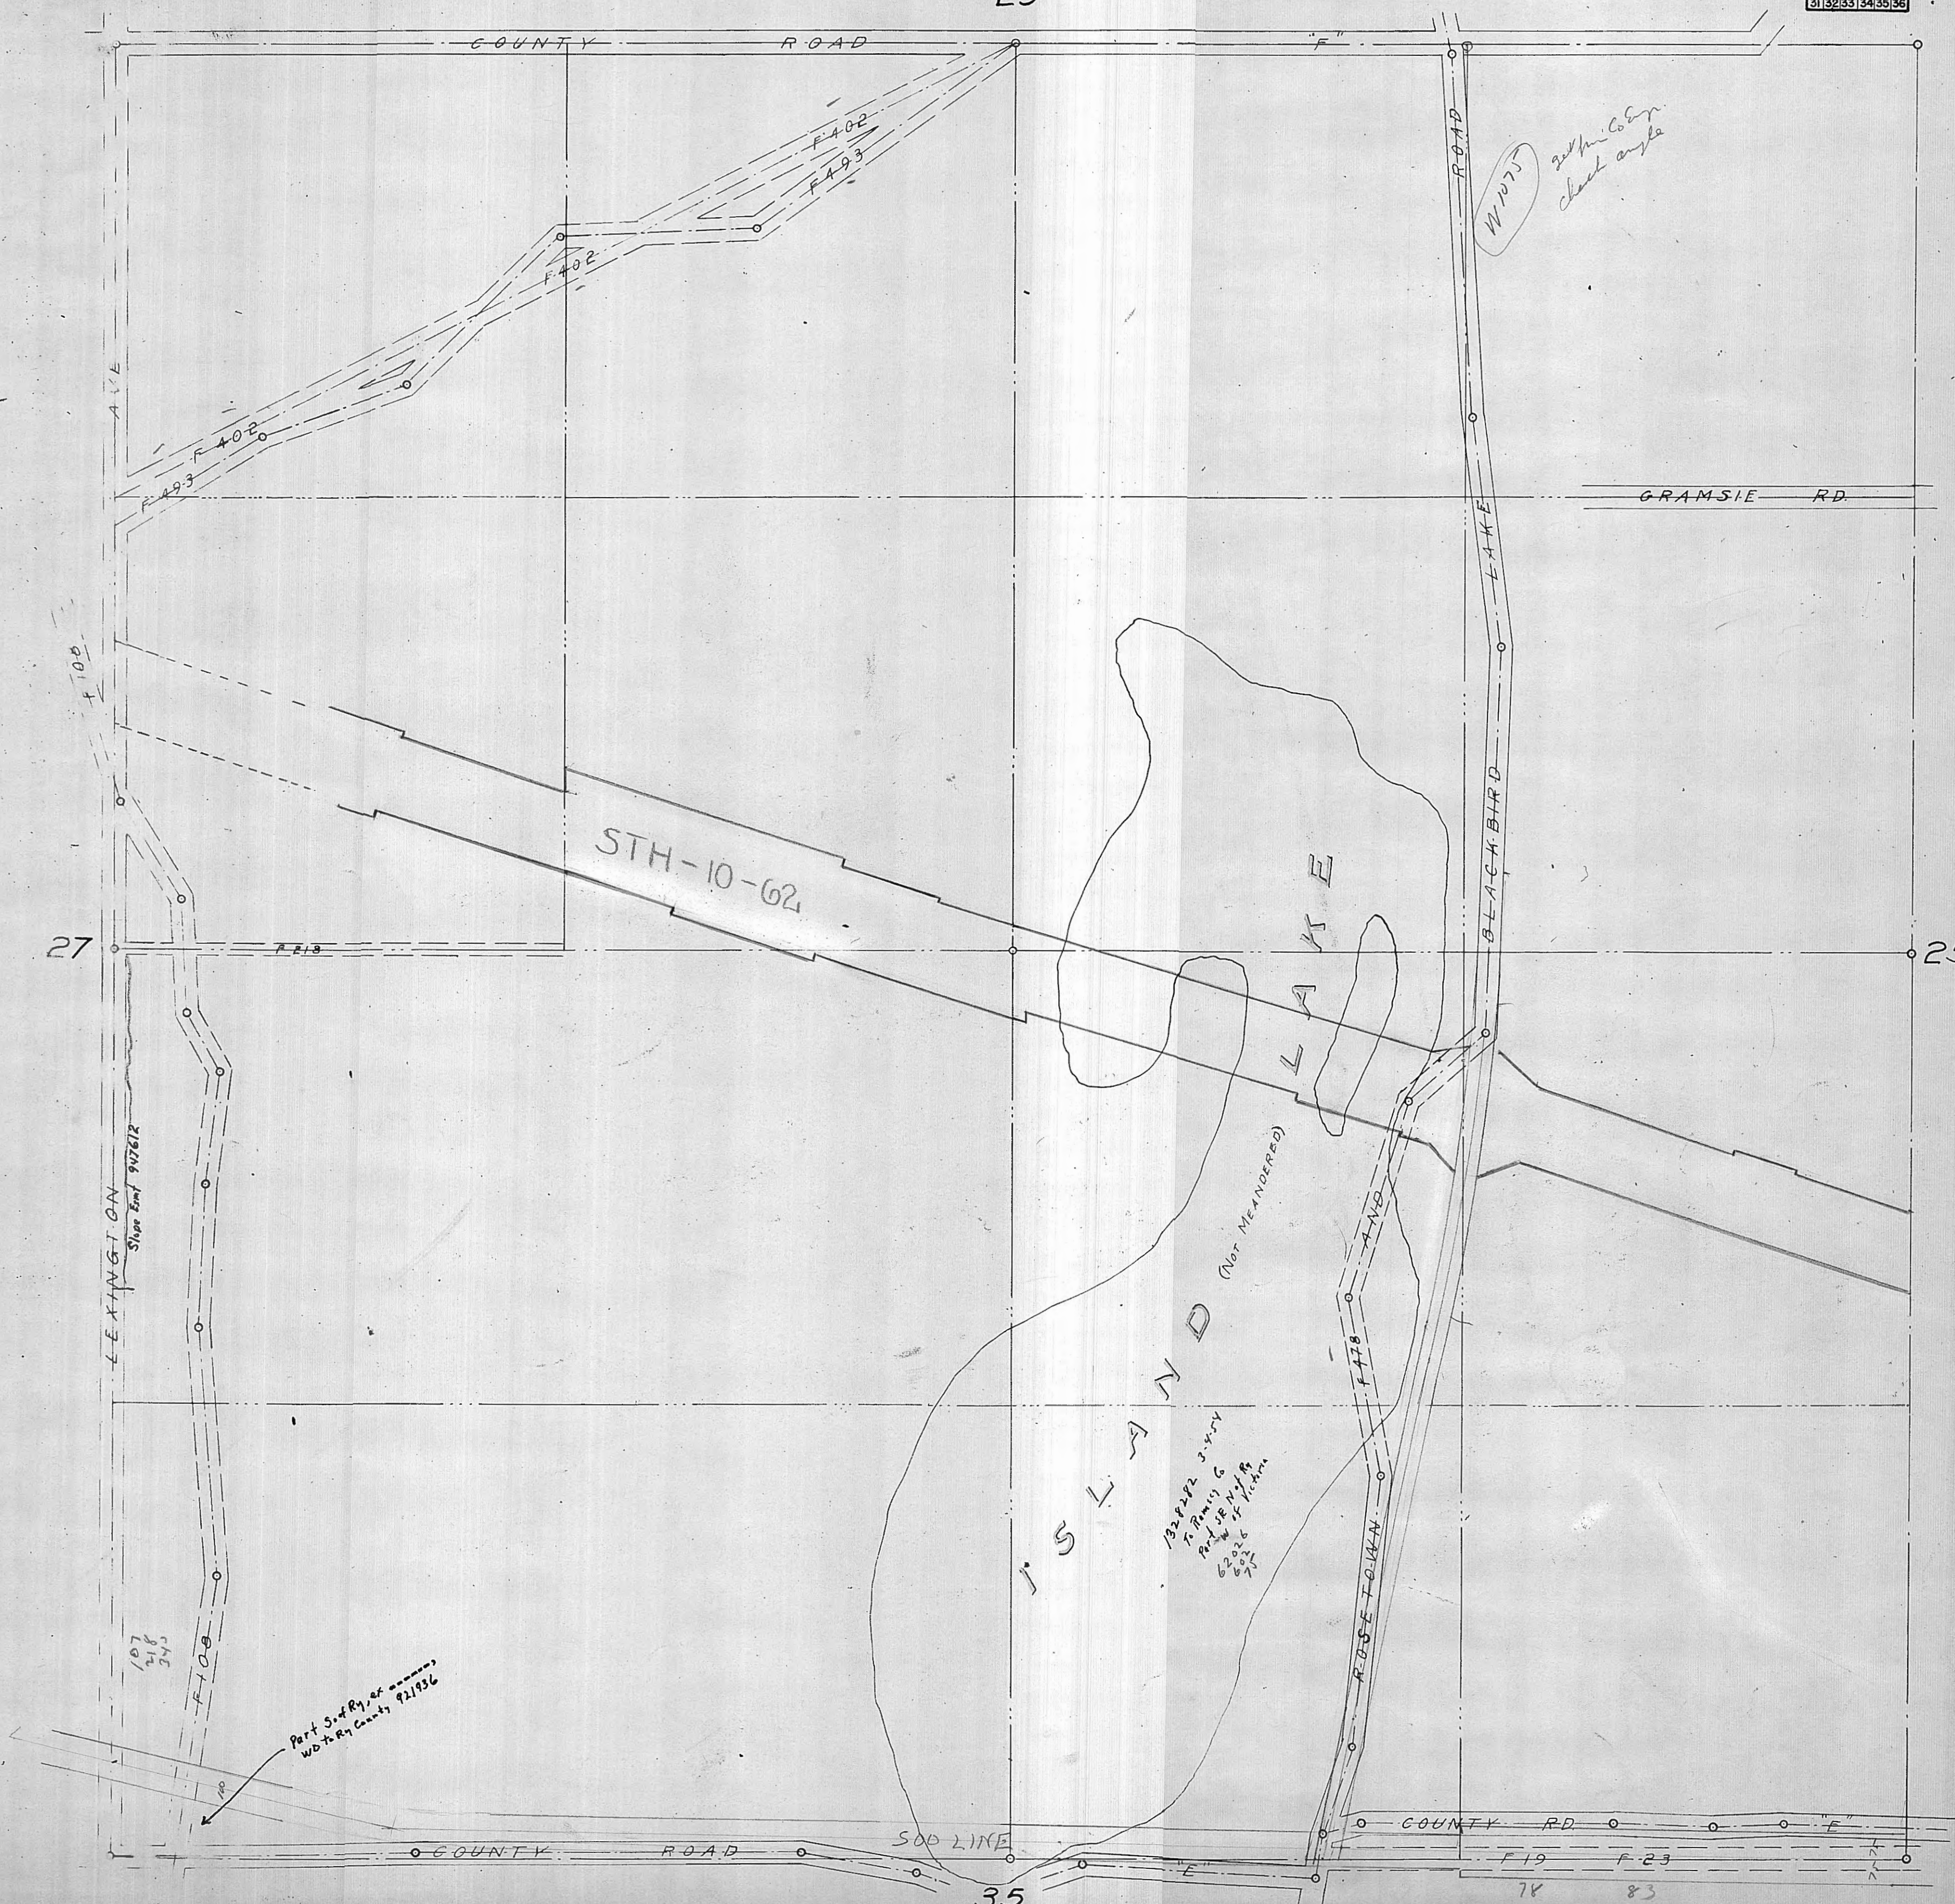

W1075
get the corner
check angle

STH-10-62

L A K E

I S L A N D
(NOT MEASURED)

132822 J-454
T. R. M. G.
P. J. M. G.
G. J. M. G.
G. J. M. G.
G. J. M. G.

107
718
343

Part Sec Ry. of ...
WD to Ry. County 921936

COUNTY RD

35

78 83