


6	5	4	3	2	1
7	8	9	10	11	12
13	14	15	16	17	18
19	20	21	22	23	24
25	26	27	28	29	30
31	32	33	34	35	36

29-30-23

Front - St

city plan  
file 20  
798050 - 1532666-7

city plan  
file 20  
798050

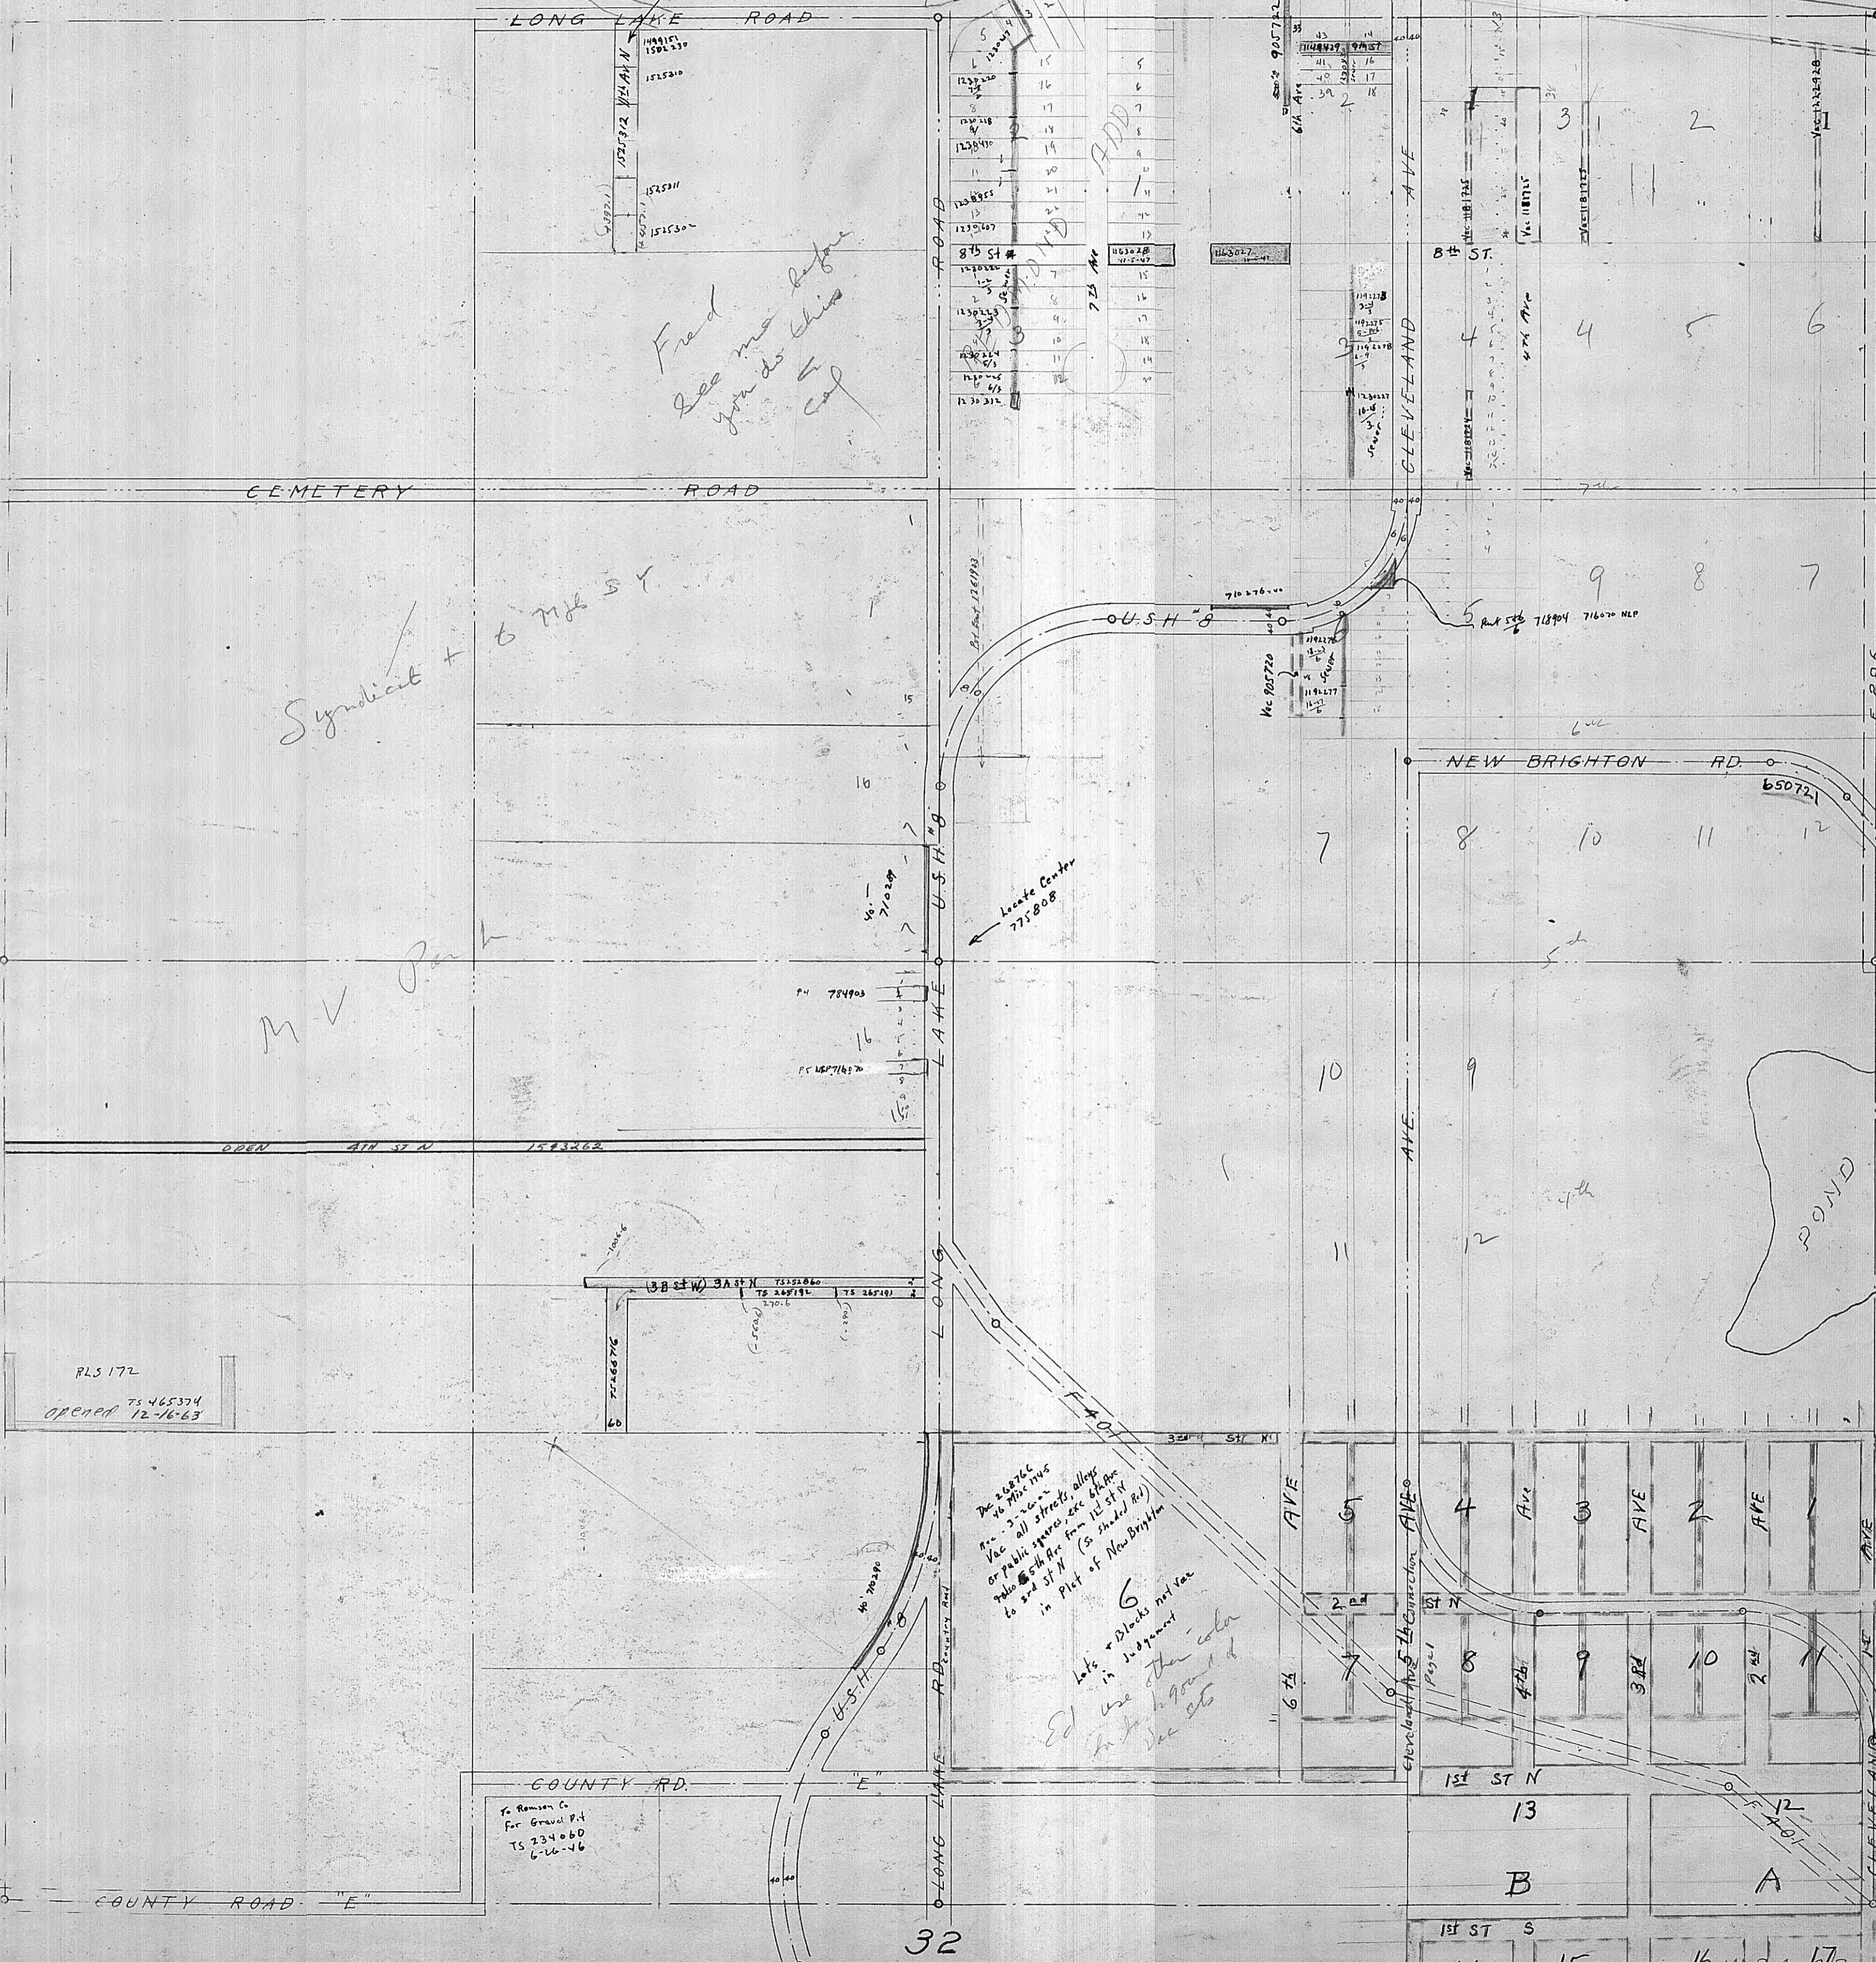

Ford  
see me before  
you do this  
cap

Syndicate +  
6th St

M.V. Park

The 26876C  
Ac. 5.26 Mic Plus  
Vac. all streets, allow  
of Public spaces are 5th Ave  
to 5th Ave from 12th St N  
in Plat of New Brighton

6  
lots + blocks not vac  
in judgment  
Ed use other color  
for background of  
vac lots

To Remon Co  
For Grand Plat  
TS 234060  
6-26-46

RLS 172  
TS 465374  
opened 12-16-63

16 W.P.A. 67P  
No. 65-1-71-2668

New Brighton  
9 TP 11

FE25 28

30

32

1st St S

14

15

16

17

18

19

20

21

22

23

24

25

26

27

28

29

30

31

32

33

34

35

36