


6	5	4	3	2	1
7	8	9	10	11	12
13	14	15	16	17	18
19	20	21	22	23	24
25	26	27	28	29	30
31	32	33	34	35	36

35  
38  
113

30-30-23

STH. 100-212

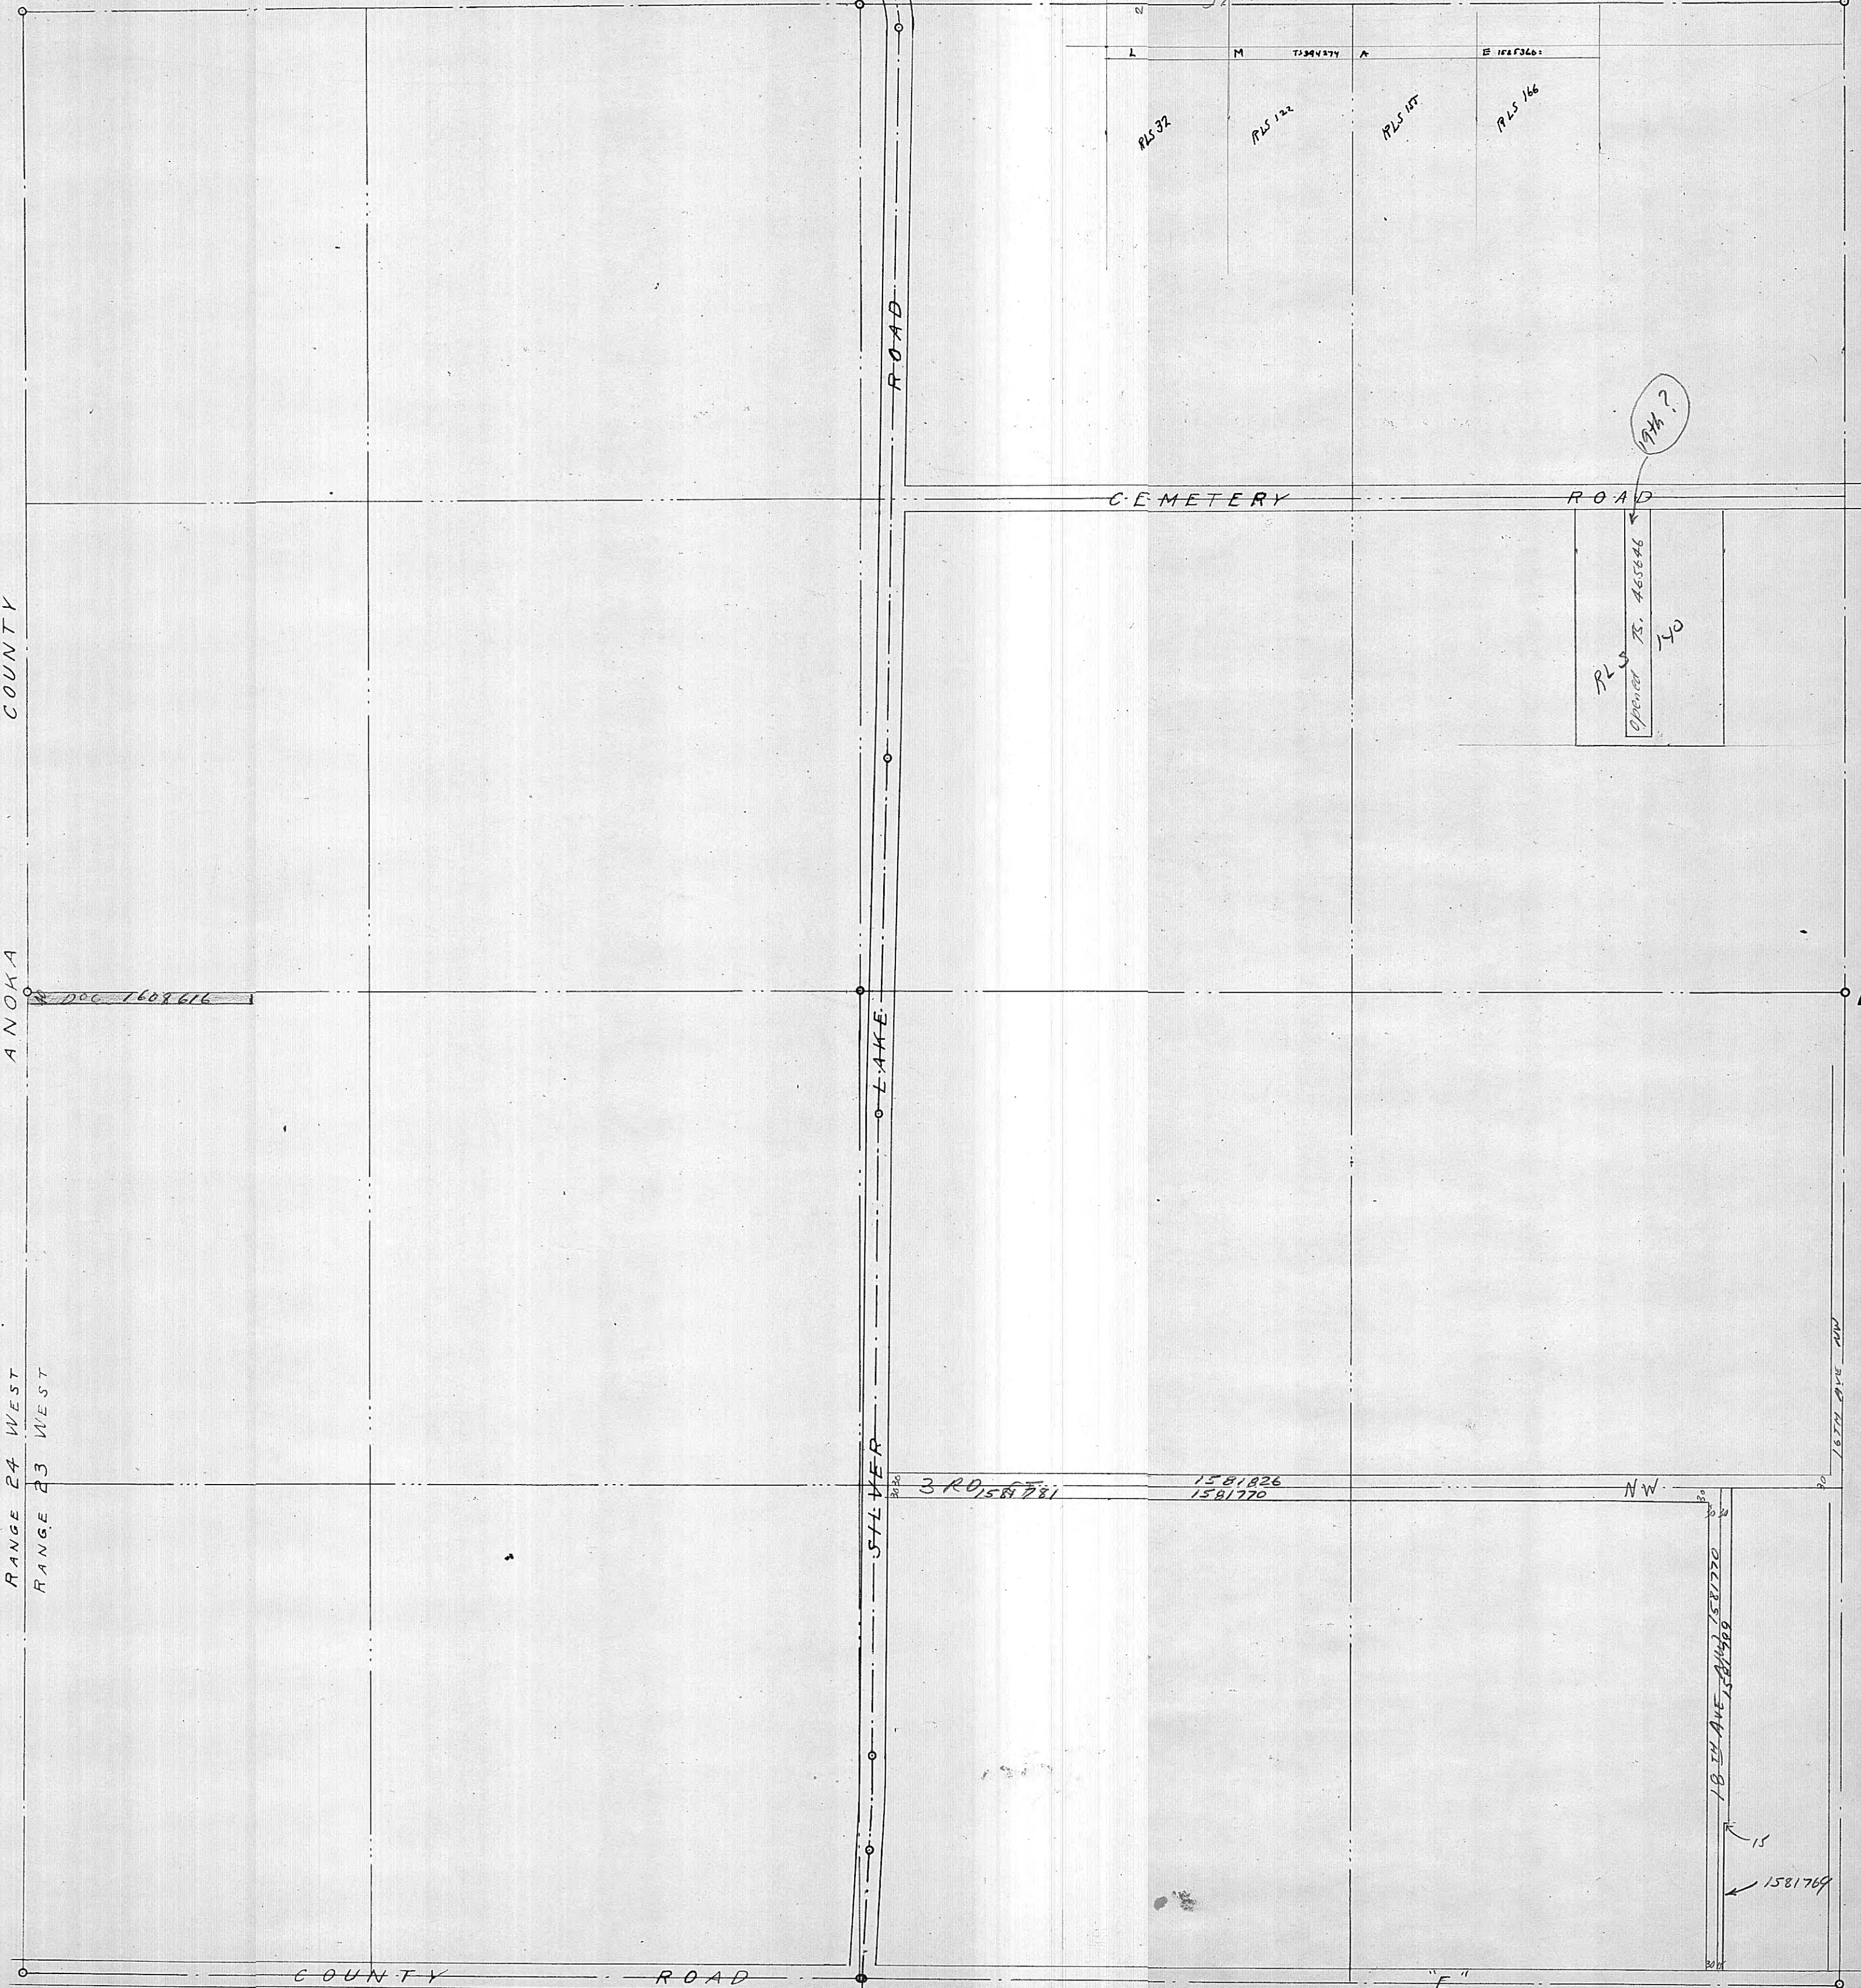

ANOKA COUNTY

RANGE 24 WEST  
RANGE 23 WEST

1688616

SILVER LAKE

CEMETERY ROAD

PLS 15  
Cemetery  
1581769

3rd St  
1581826  
1581770

18th Ave  
1581770

1581769

COUNTY ROAD

"E"

29