


6	5	4	3	2	1
7	8	9	10	11	12
13	14	15	16	17	18
19	20	21	22	23	24
25	26	27	28	29	30
31	32	33	34	35	36

31-30-23

30

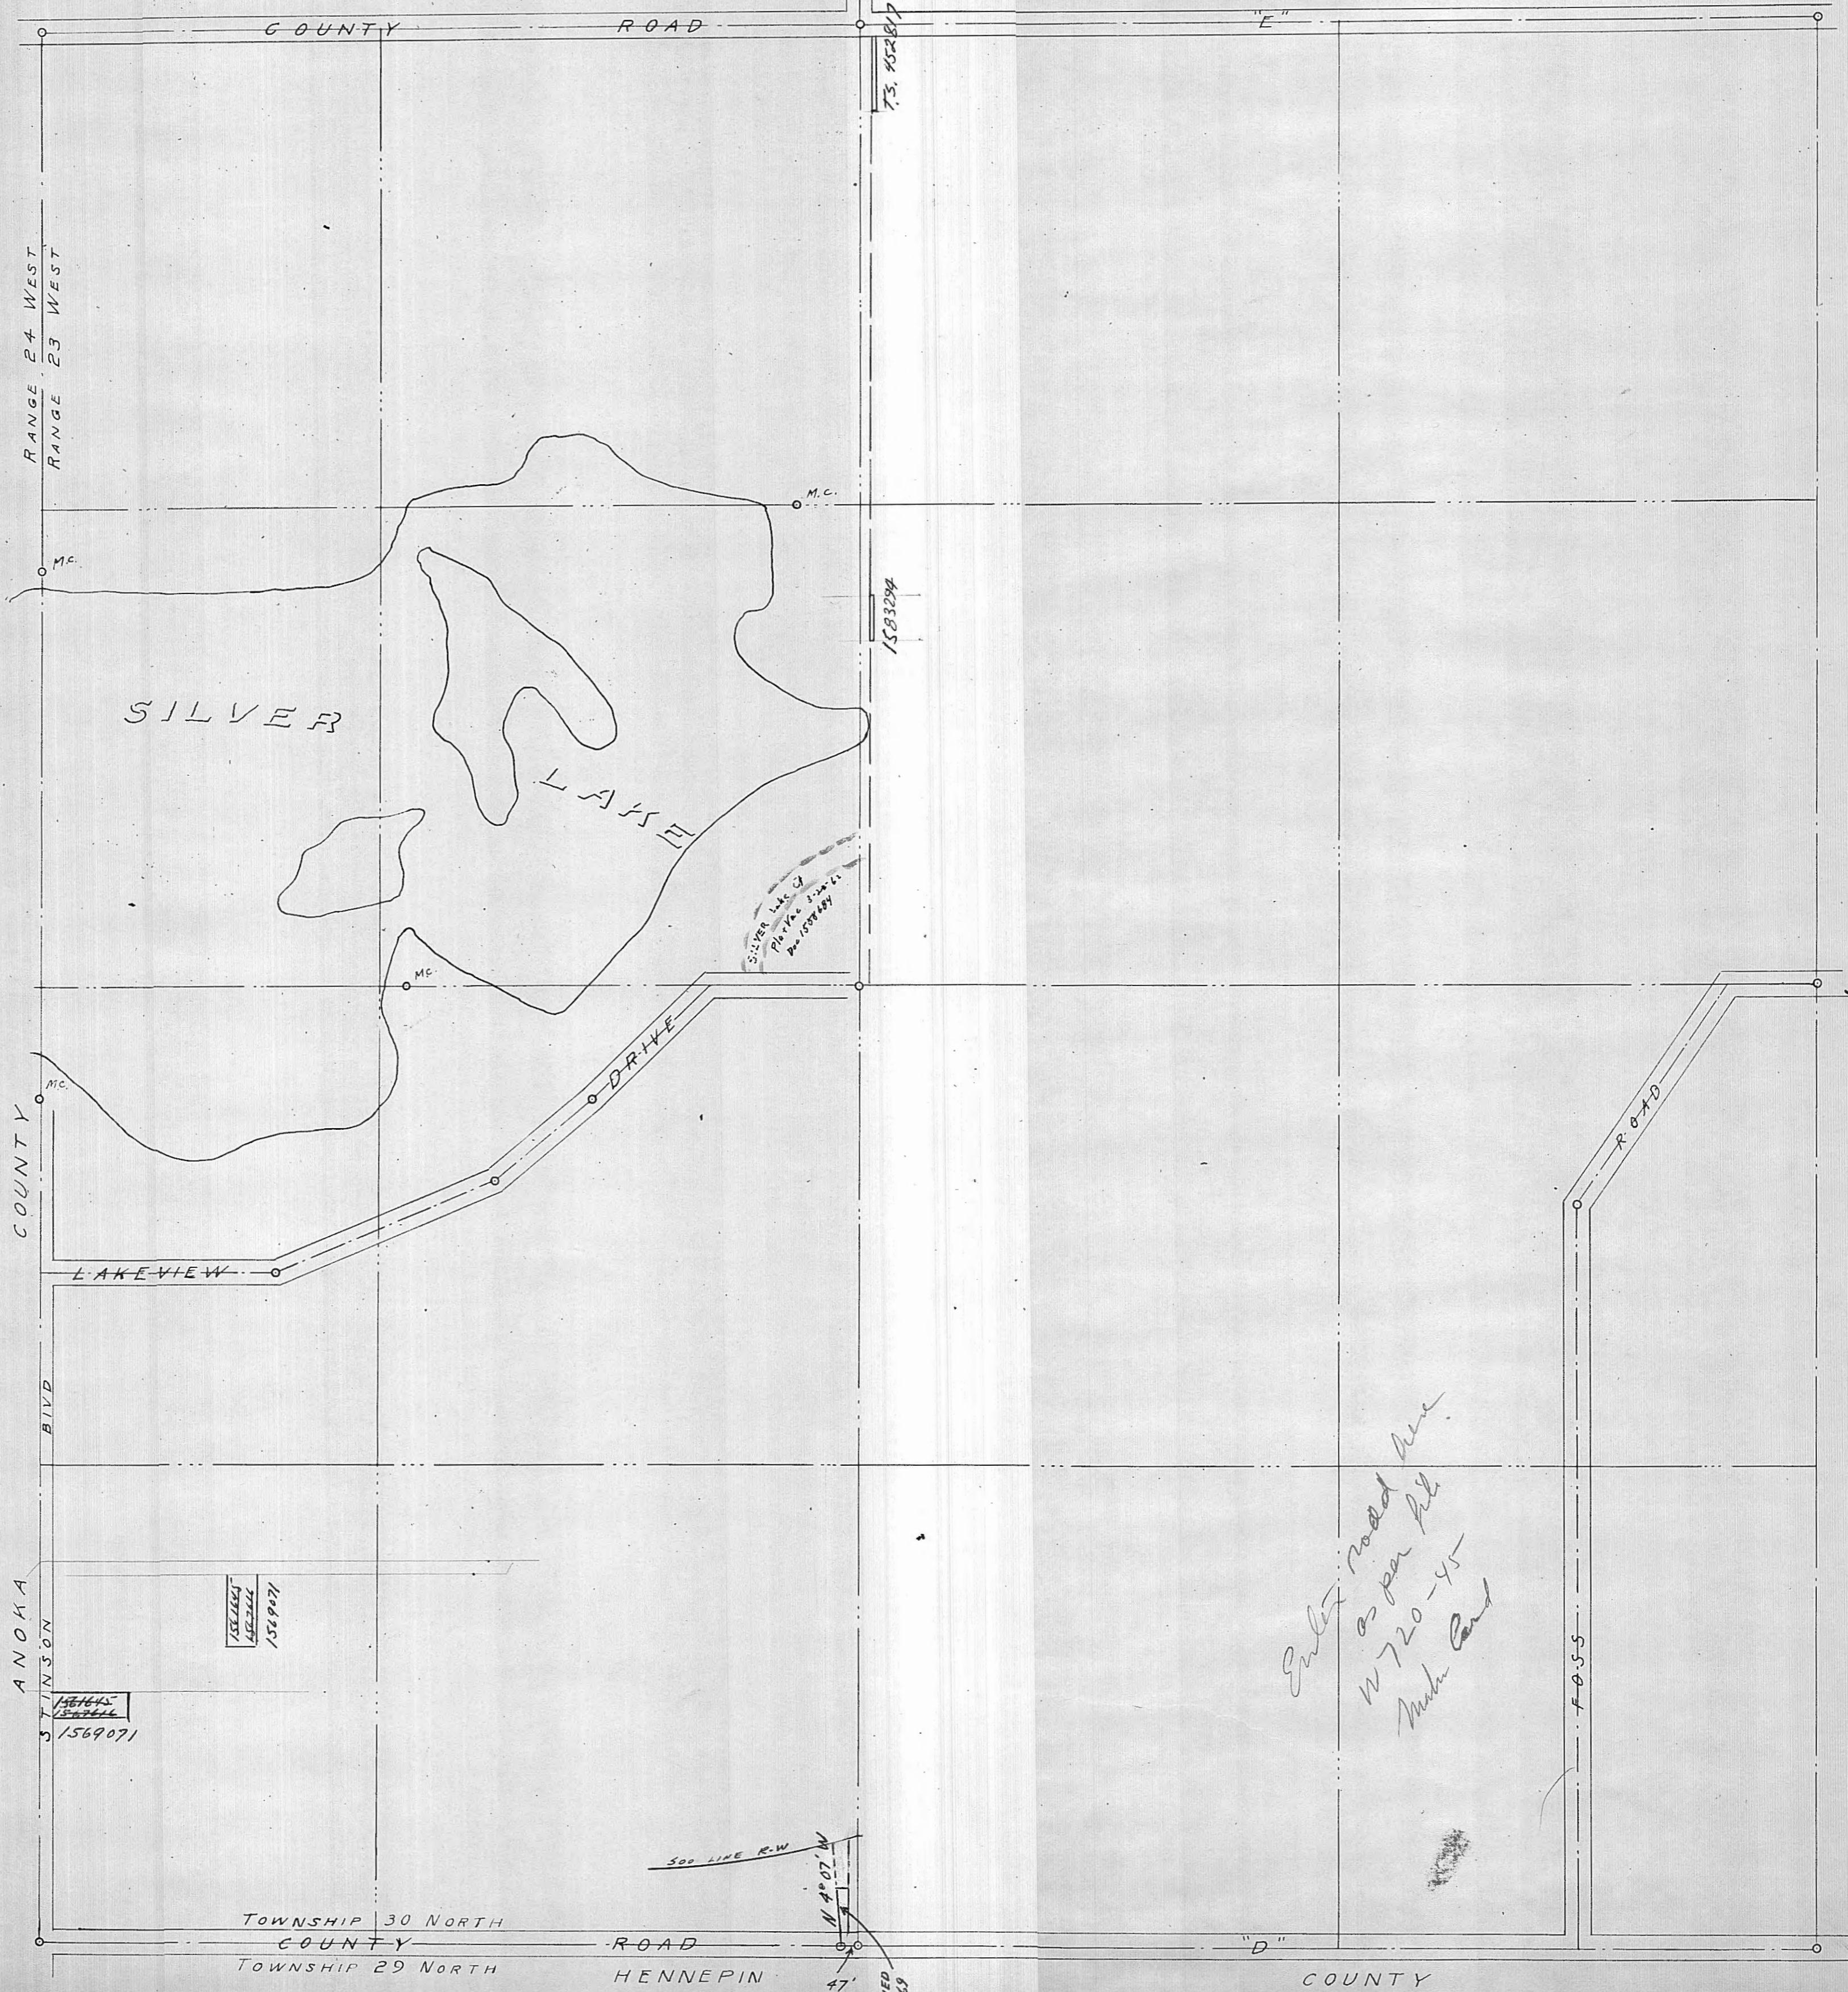

SILVER LAKE

RANGE 24 WEST
RANGE 23 WEST

COUNTY

ANOKA
WINSON

TOWNSHIP 30 NORTH
COUNTY
TOWNSHIP 29 NORTH

ROAD
HENNEPIN

COUNTY

32

*Entry road Ave
as per plat
W 720-45
Muhlenberg*