


6	5	4	3	2	1
7	8	9	10	11	12
13	14	15	16	17	18
19	20	21	22	23	24
25	26	27	28	29	30
31	32	33	34	35	36

33-30-23

28

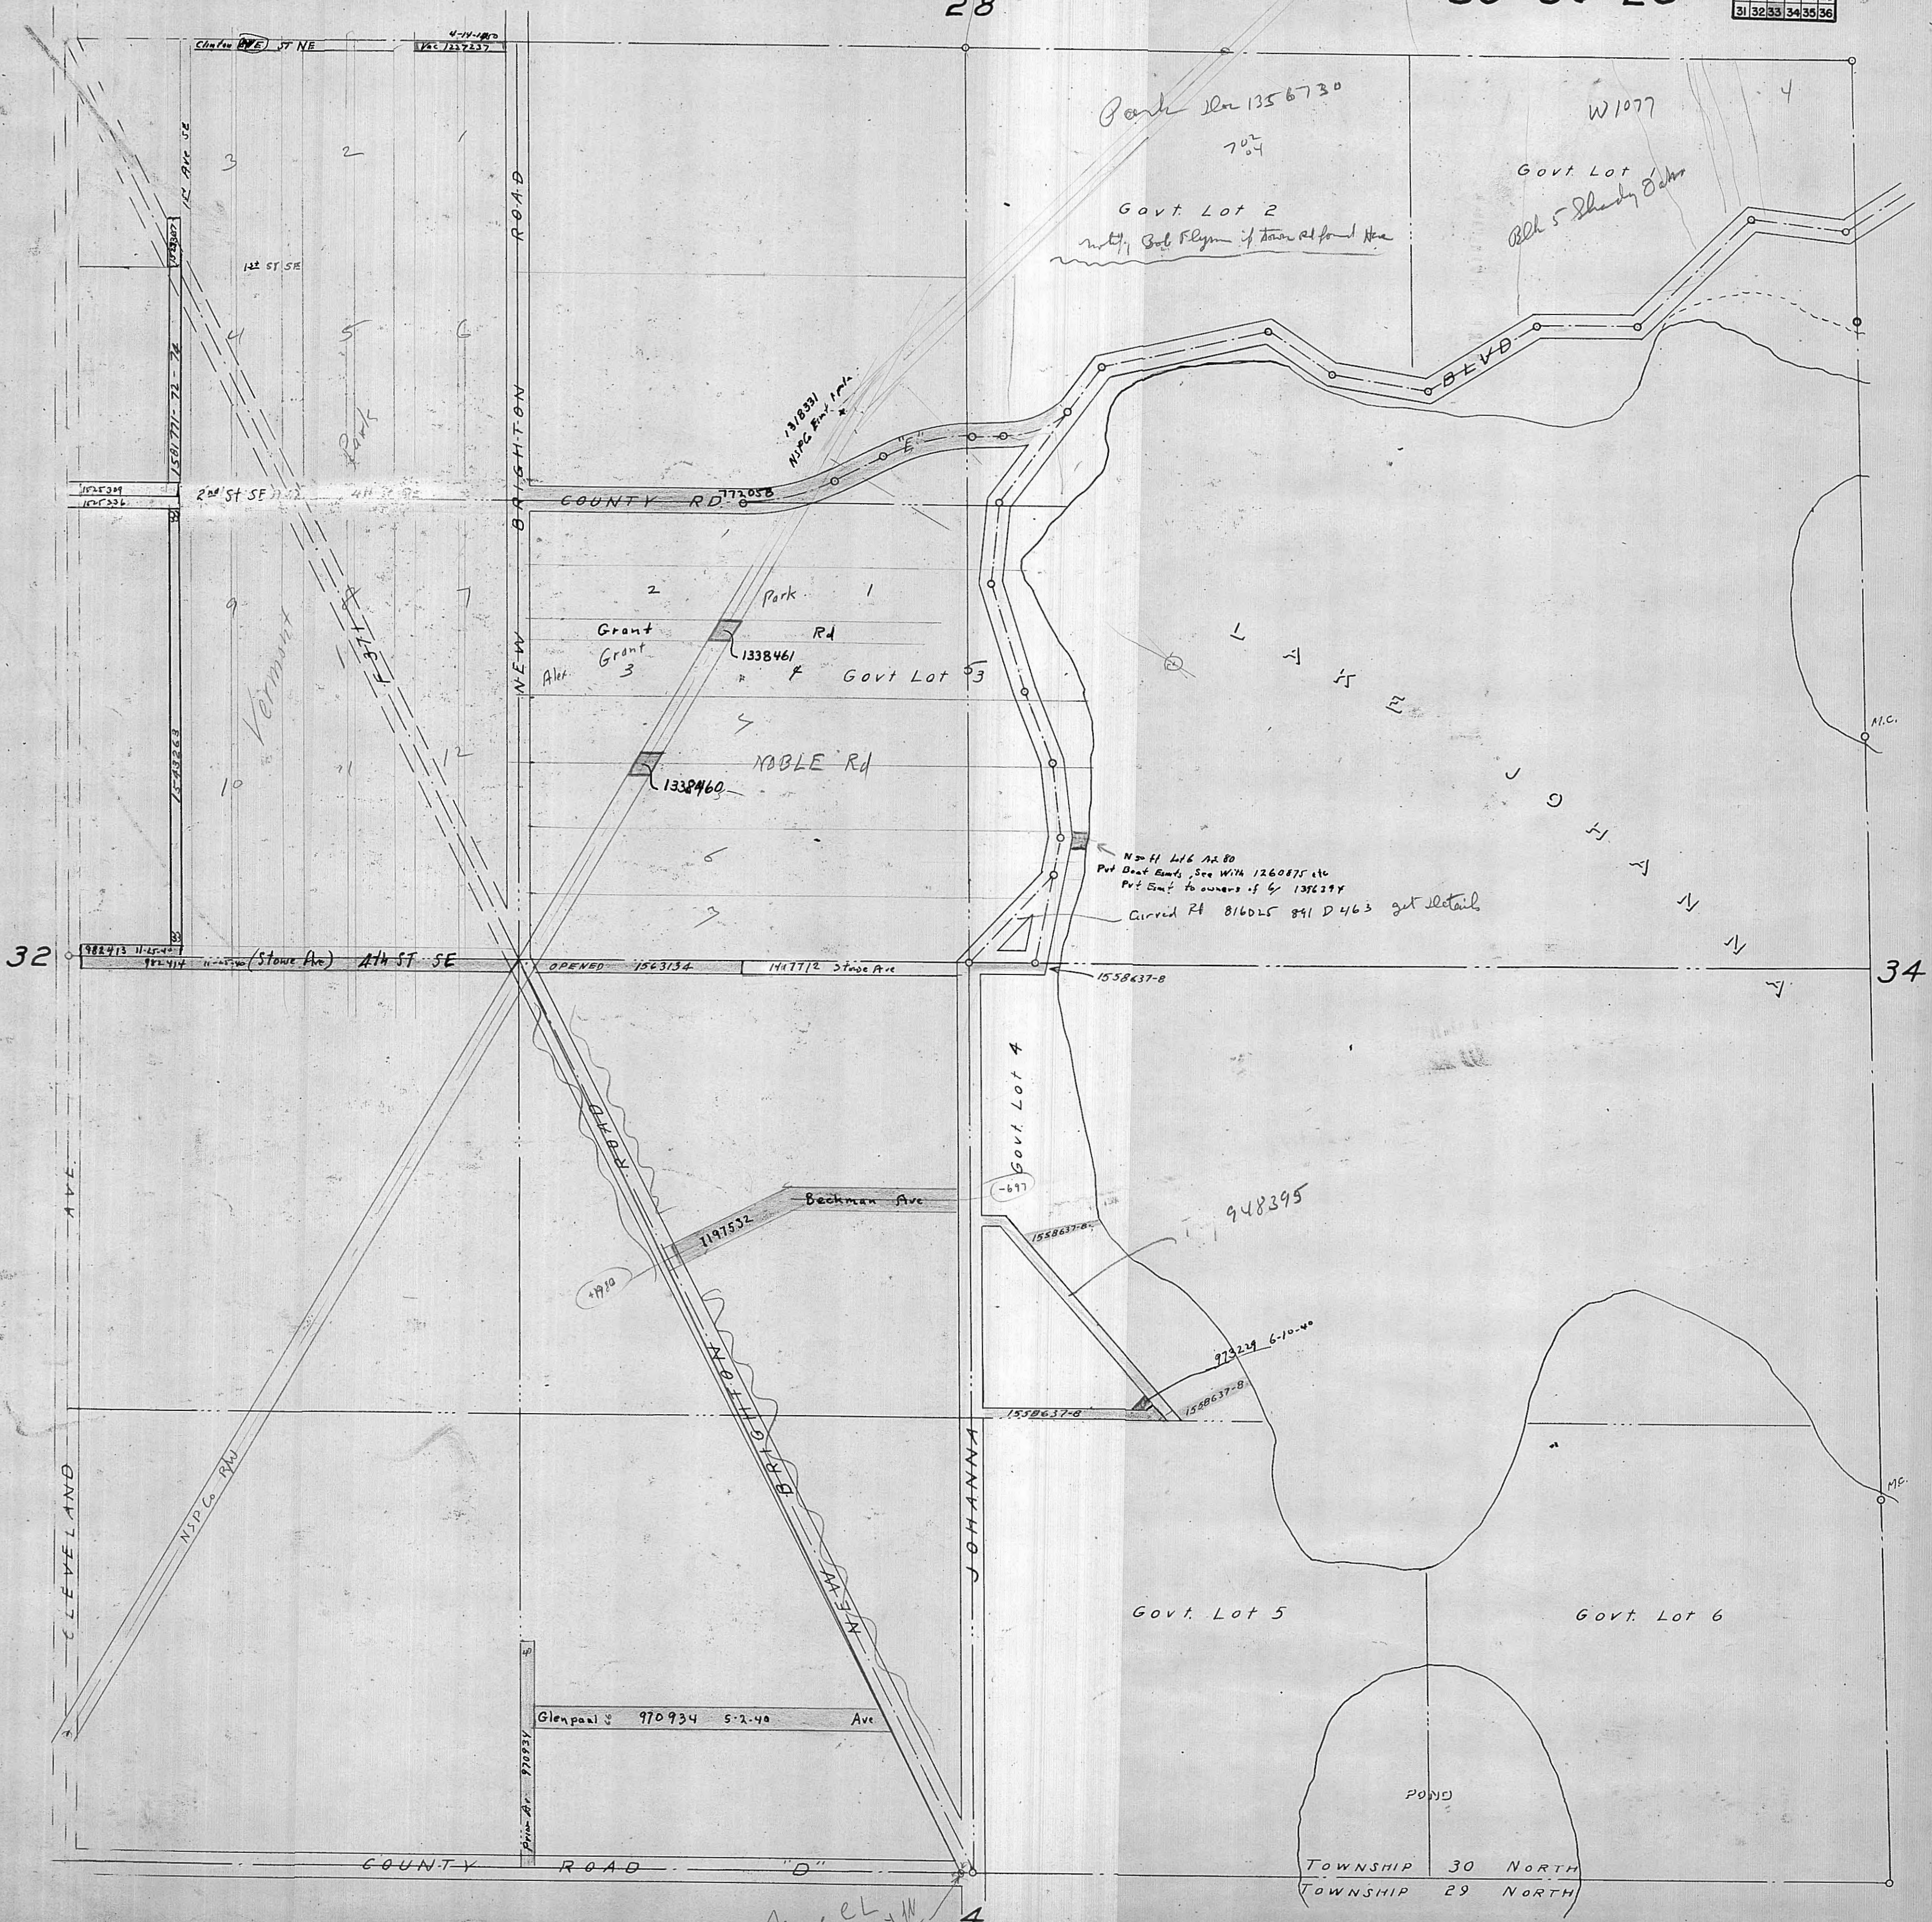

TOWNSHIP 30 NORTH
TOWNSHIP 29 NORTH

More CL
30-1-11
W.L.R.