

7	8	9	10	11	12
13	14	15	16	17	18
19	20	21	22	23	24
25	26	27	28	29	30
31	32	33	34	35	36

36-30-23


25

78

83

78 79 83

193

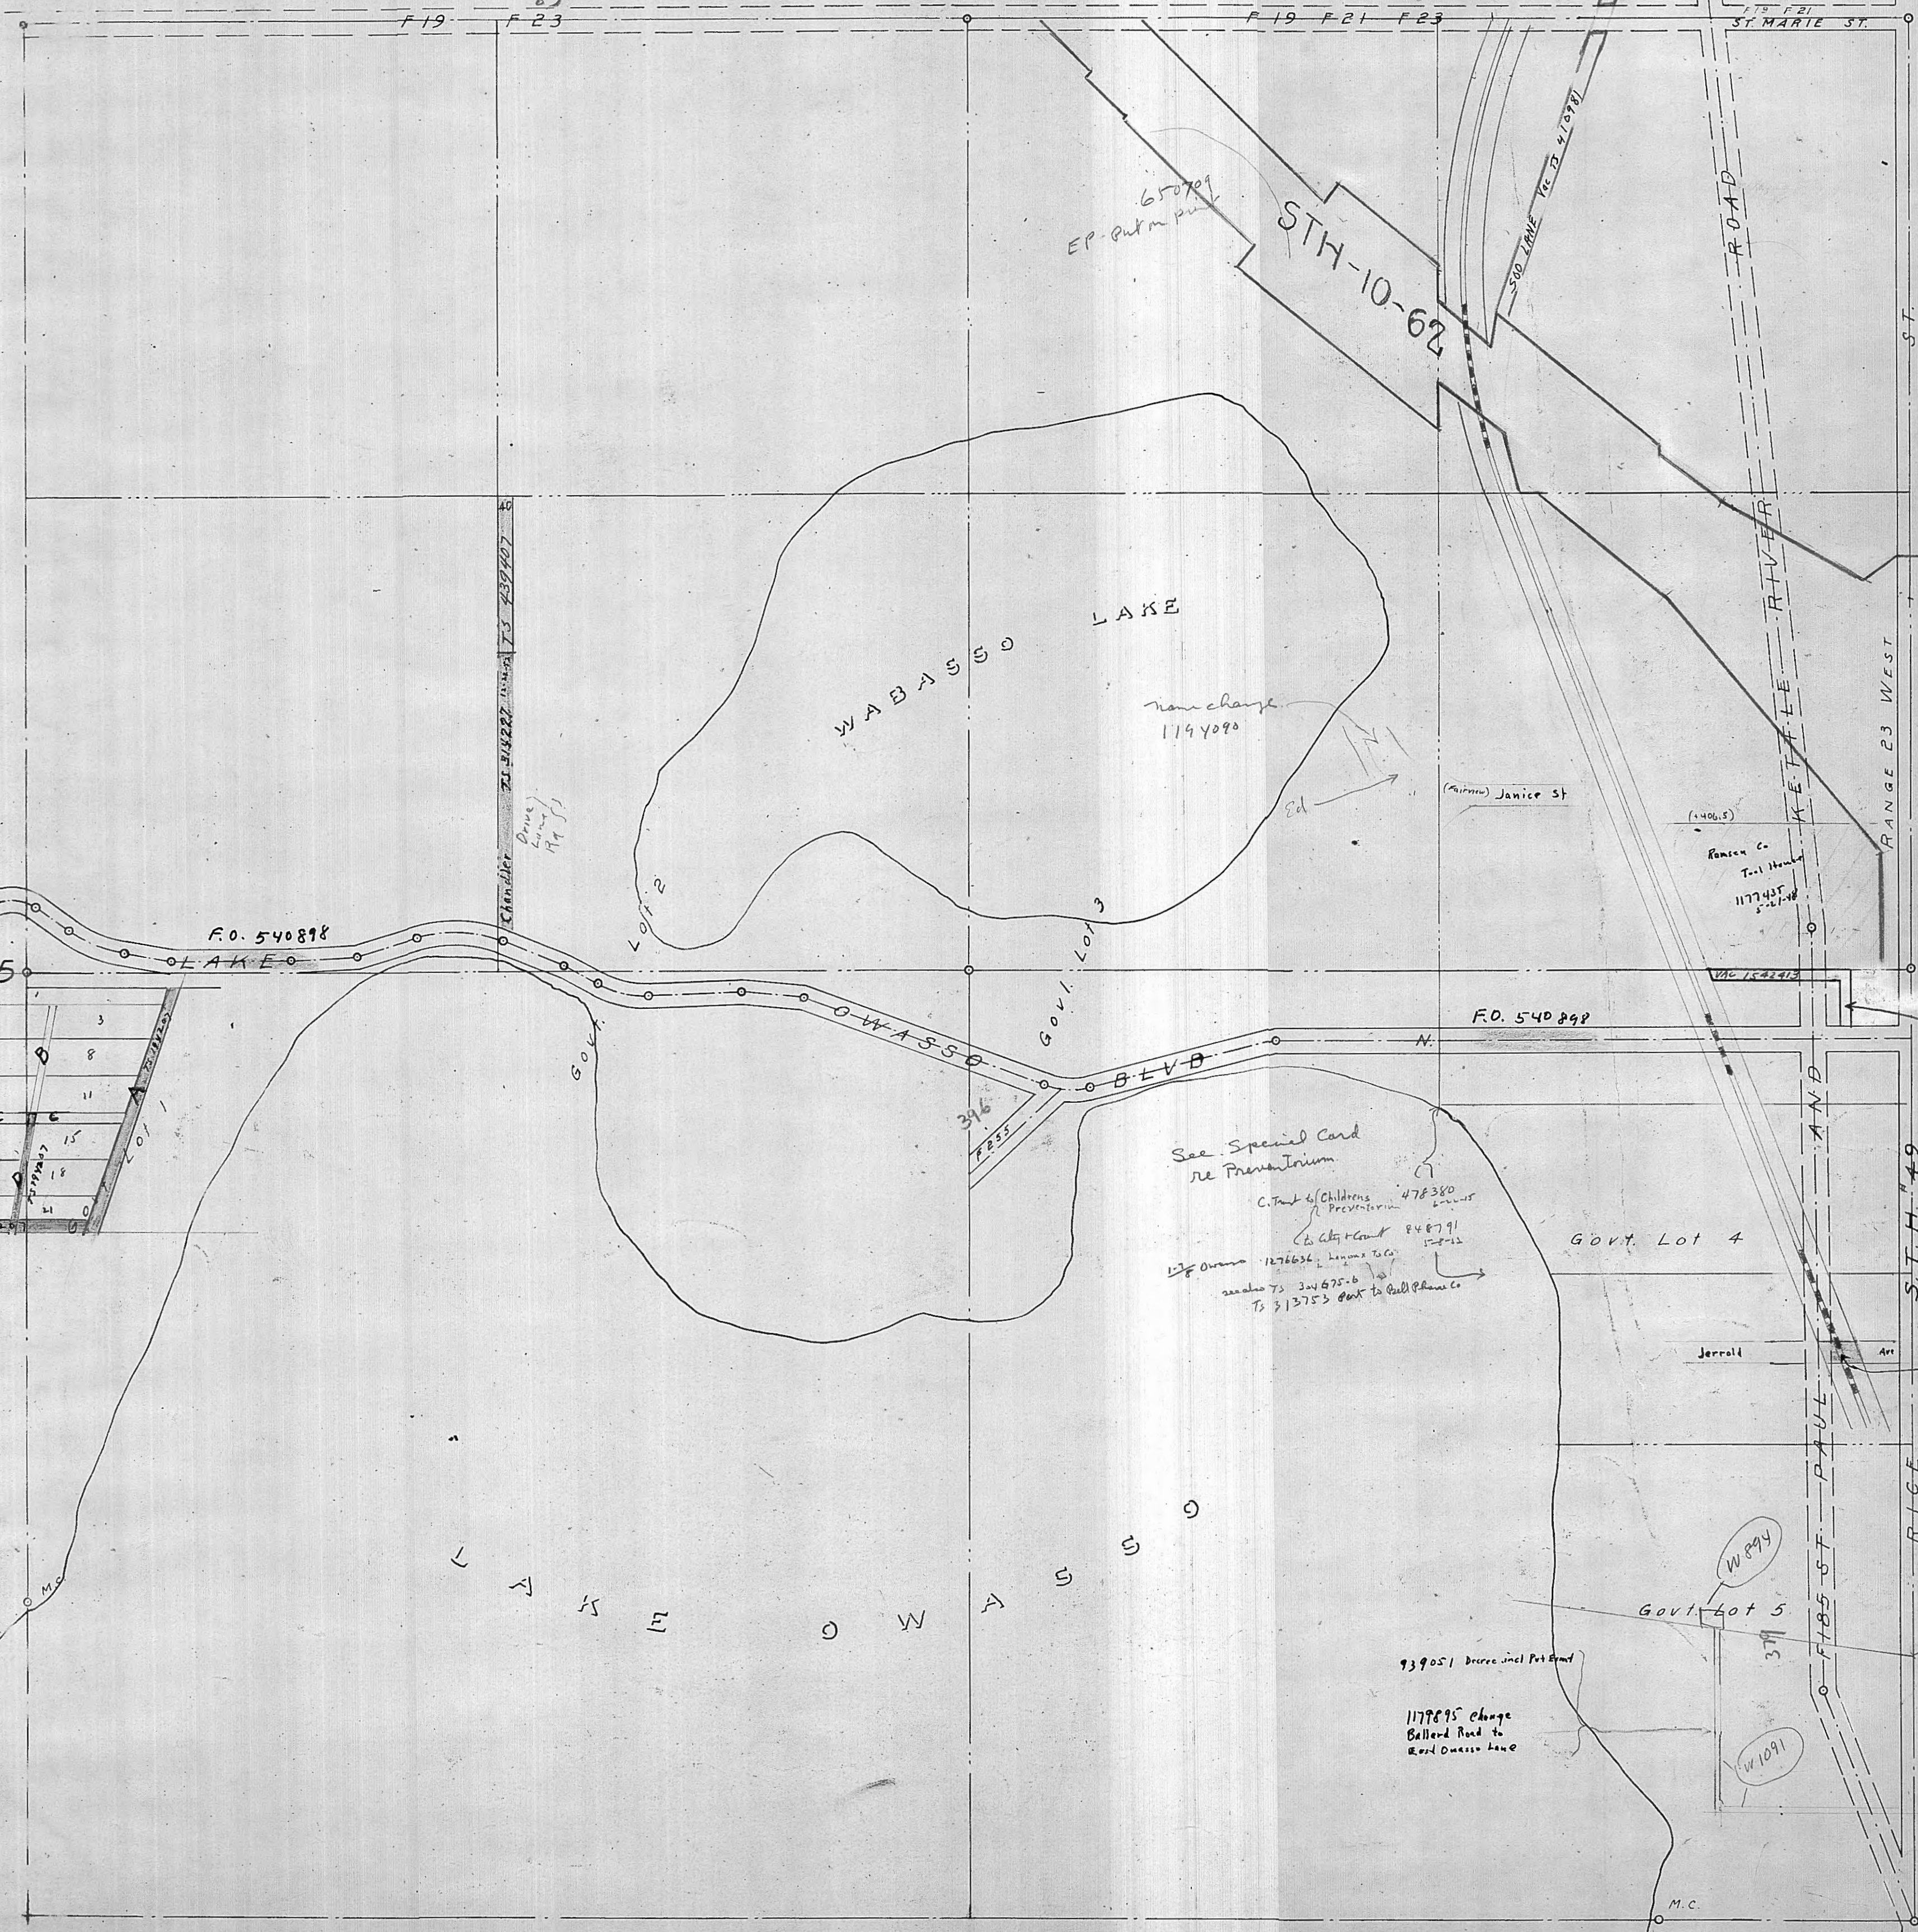

33 7P 6

Let. Over 1/4

See Special Card
re Preventorium
C. Trust of Childrens 478380
Preventorium
Ch. City & Govt 848791
1276636, Kansas to Govt
15-12
see also 73 24675-b
Ts 313753 part to Bull Phon Co

939051 Drive incl Pet Road
117895 change
Ballard Road to
East Duessie Lane

W894

W1091

1187181
1201200
51949