


6-30-23

6	5	4	3	2	1
7	8	9	10	11	12
13	14	15	16	17	18
19	20	21	22	23	24
25	26	27	28	29	30
31	32	33	34	35	36

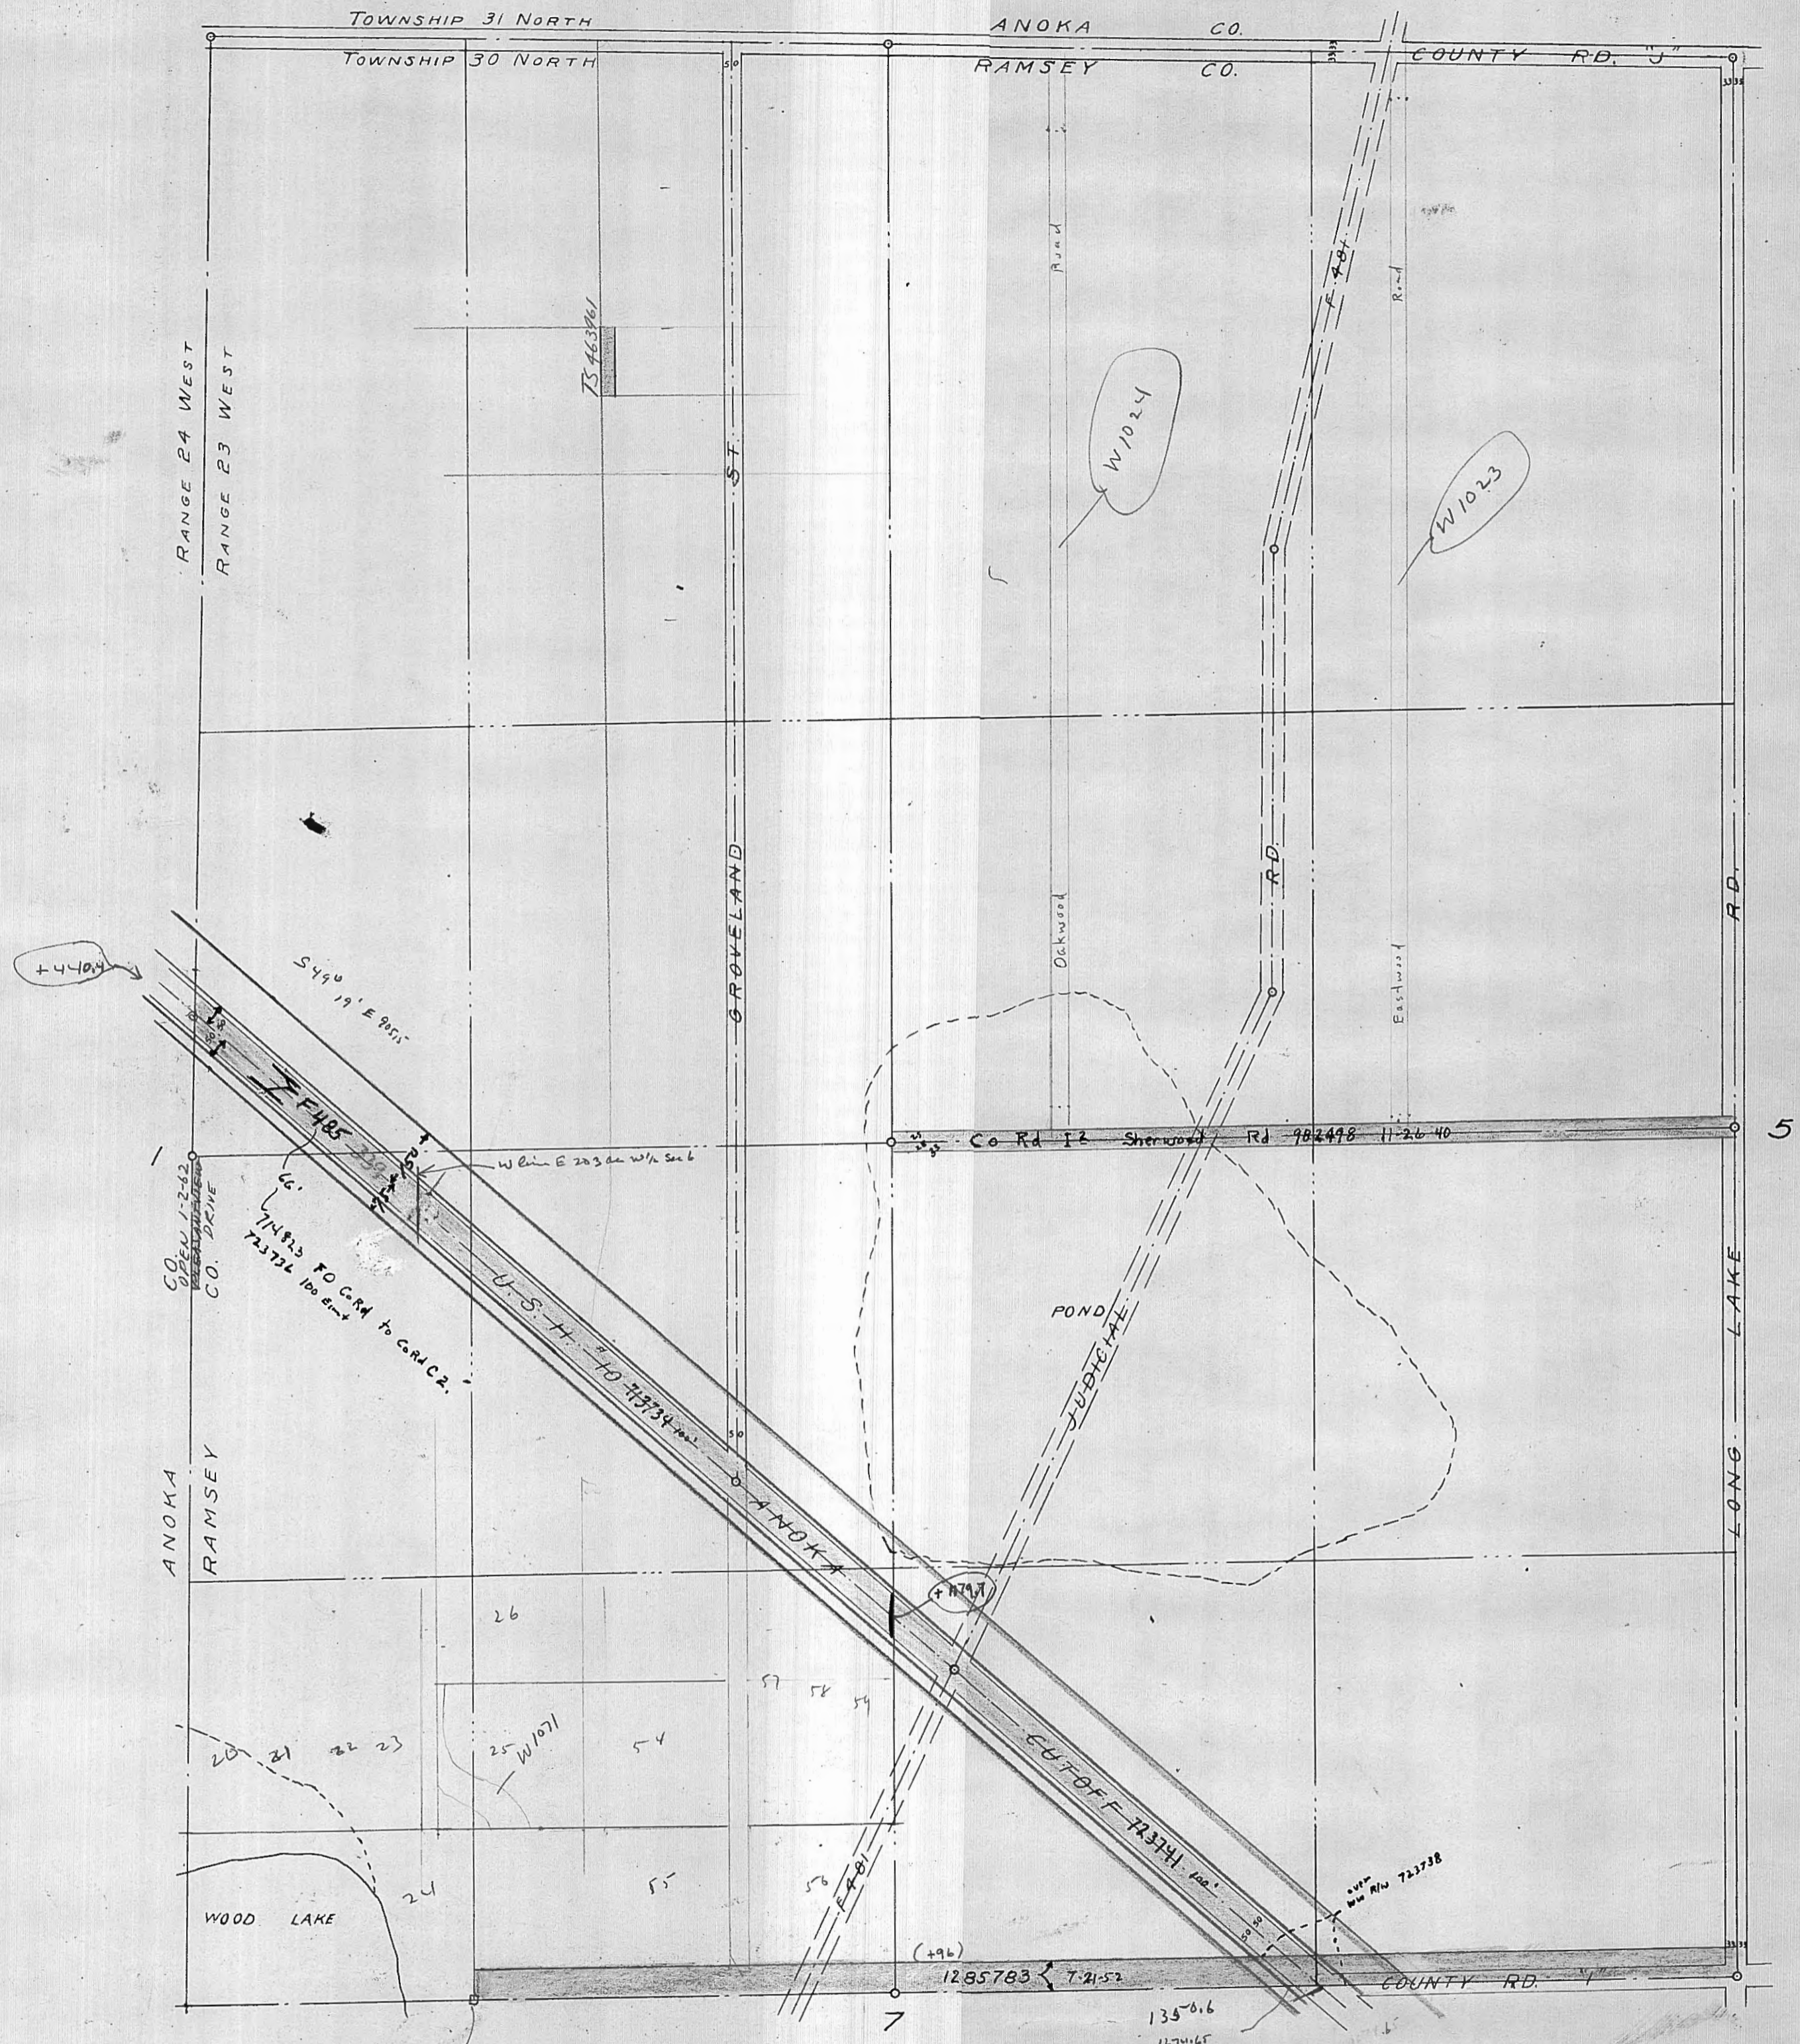

+908.2 → E to SE cor Sec 6 State Deed To City 596 feet 1285.783 7-21-52  
 SCALE: 1 IN. = 400 FT.  
 0 50 100 200 300 400 500 750 1000