


9-30-23

6	5	4	3	2	1
7	8	9	10	11	12
13	14	15	16	17	18
19	20	21	22	23	24
25	26	27	28	29	30
31	32	33	34	35	36

Locate Cor  
77-805

Locate 1/4 Cor  
77-804

Locate Cor  
77-806

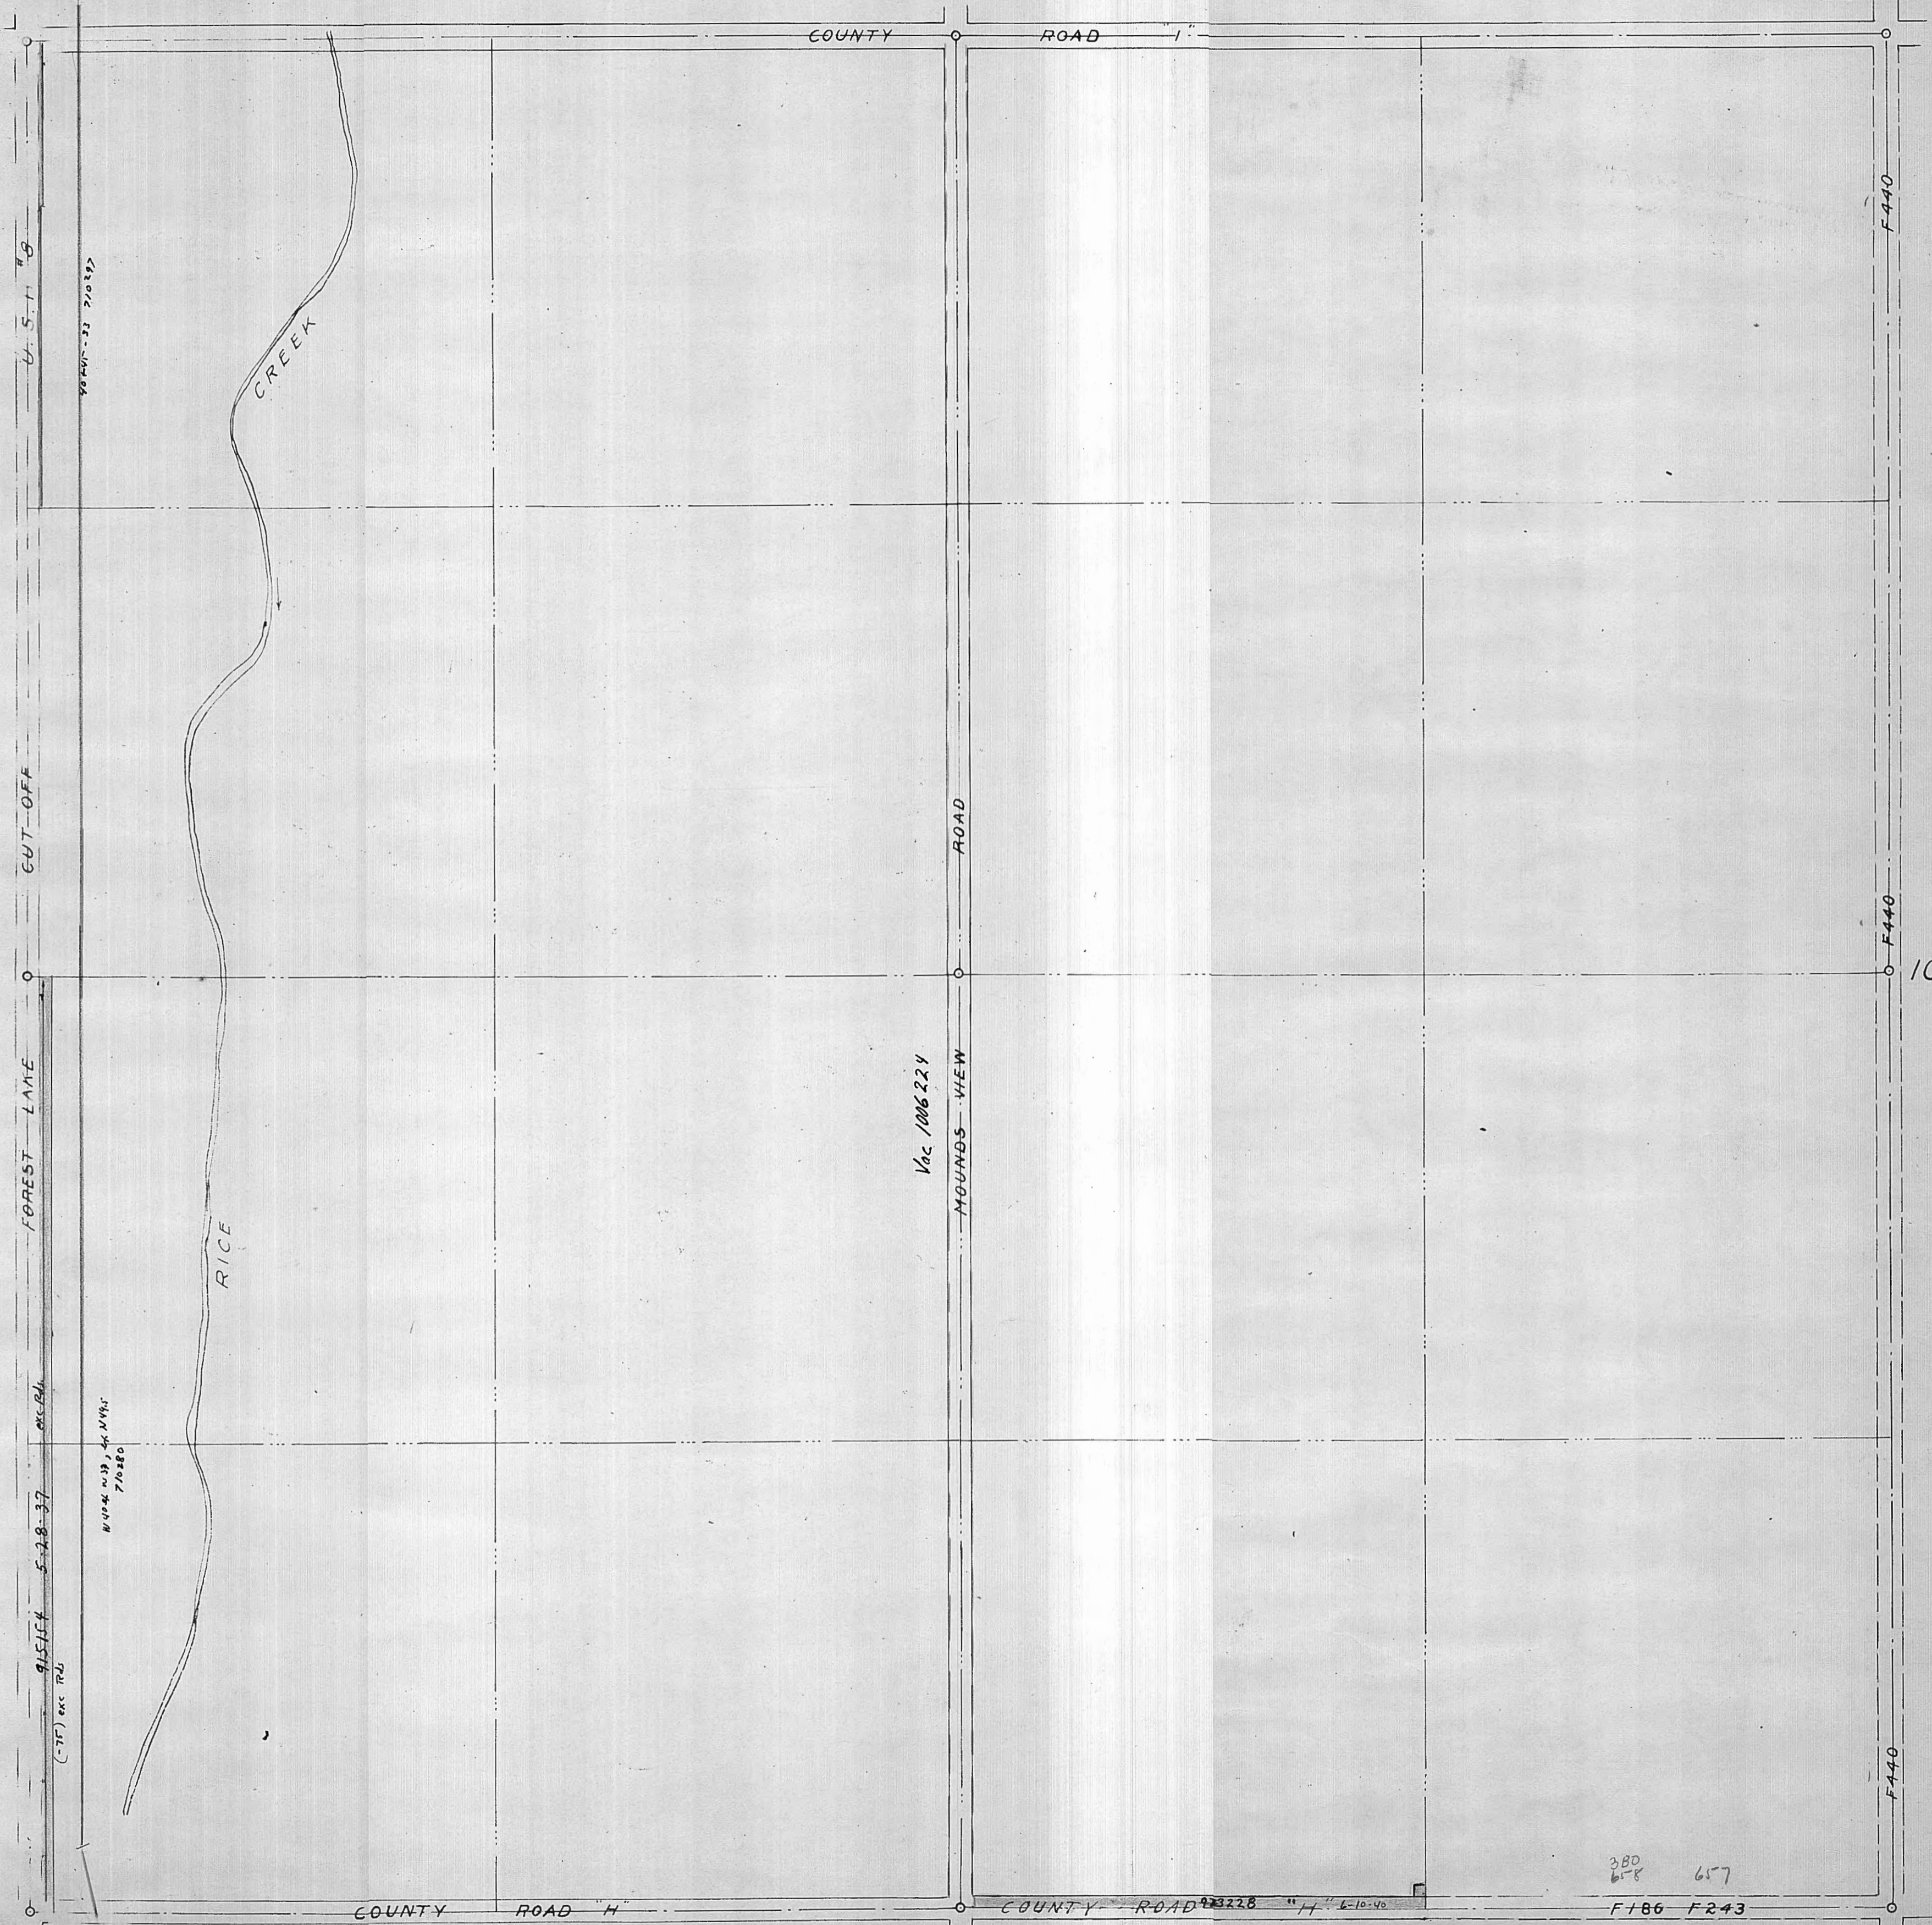

F440

F440

F440

380  
658 657

F186 F243