


Office of the Surveyor
County of Ramsey
 and said notes are filed in this Office by virtue of this
 highest order of said A.S. 1850, at 1st District Precinct A
 the duty was that in Book 1st of Bonds & Deeds,
Henry Hengle,
Register of Deeds.

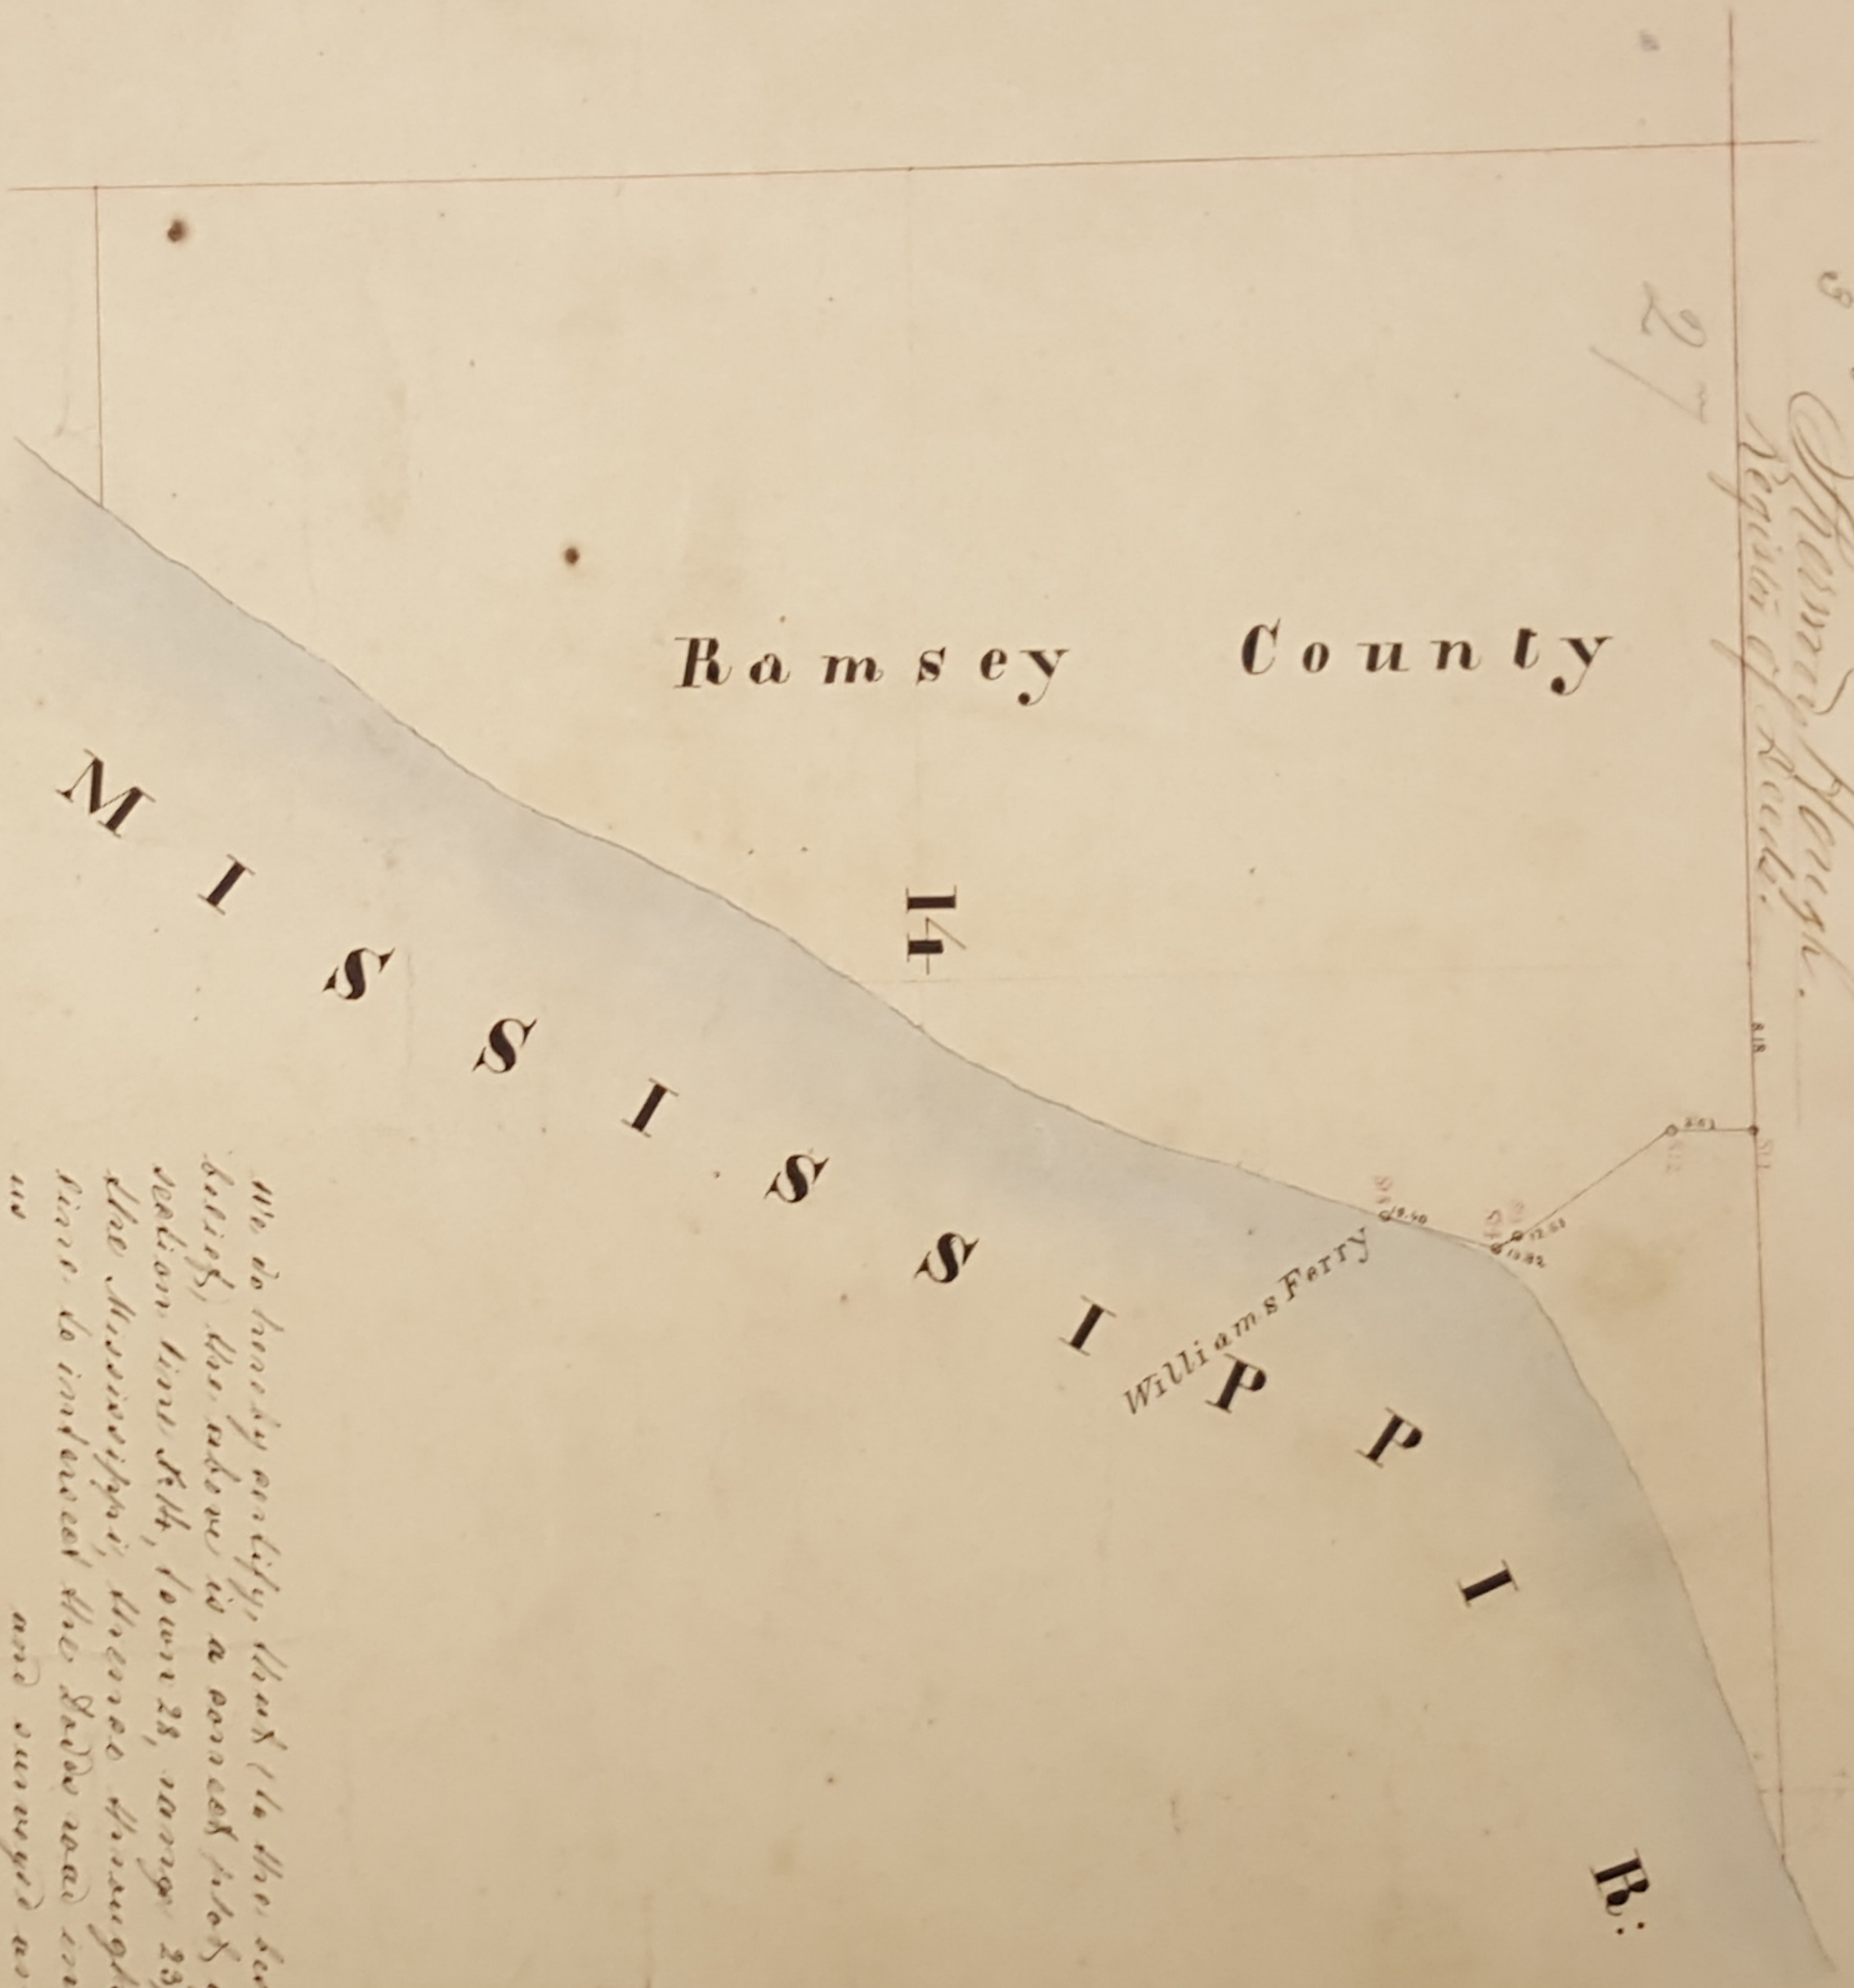

<i>Deeds - Bonds</i>		<i>Distances</i>	
<i>Books</i>	<i>No.</i>		<i>00</i>
362	34350	12, 63	
363	82	13, 82	
364	17456	19, 40	
365	00		

We do hereby certify that the fact of our knowledge and
 belief, that above is a correct list of the State Road from
 section 14th, town 28, range 23, to Williams Ferry on
 the Mississippi; thence through section 23, on a direct
 line to intersect the said road in section 35, as marked by
 and surveyed and located in April 1858

21 Paul's Appy 1858

Wm. Hengle
John Rose
William Stein



