MAP OF HIGHWOOD ROAD

SCALE: 1 IN. = 400 FT.

I certify that this map correctly shows the survey of the "Highwood Road" more particularly described as follows viz: commencing at the Quarter Section corner between Sections 13 & 14 Town 28 Range 22 and thence East along the Quarter Section line to the Quarter Section corner between Section 13 Town 28 Range 22 and Section 18 Town 28 Range 21, thence East along the Quarter Section line to the Quarter Section corner between Sections 17 & 18 Town 28 Range 21, as surveyed by me.

Dated St. Paul Minn. July 11th 1890

H. E. Clark
Dep. Co. Surveyor
Ramsey Co. Minn.

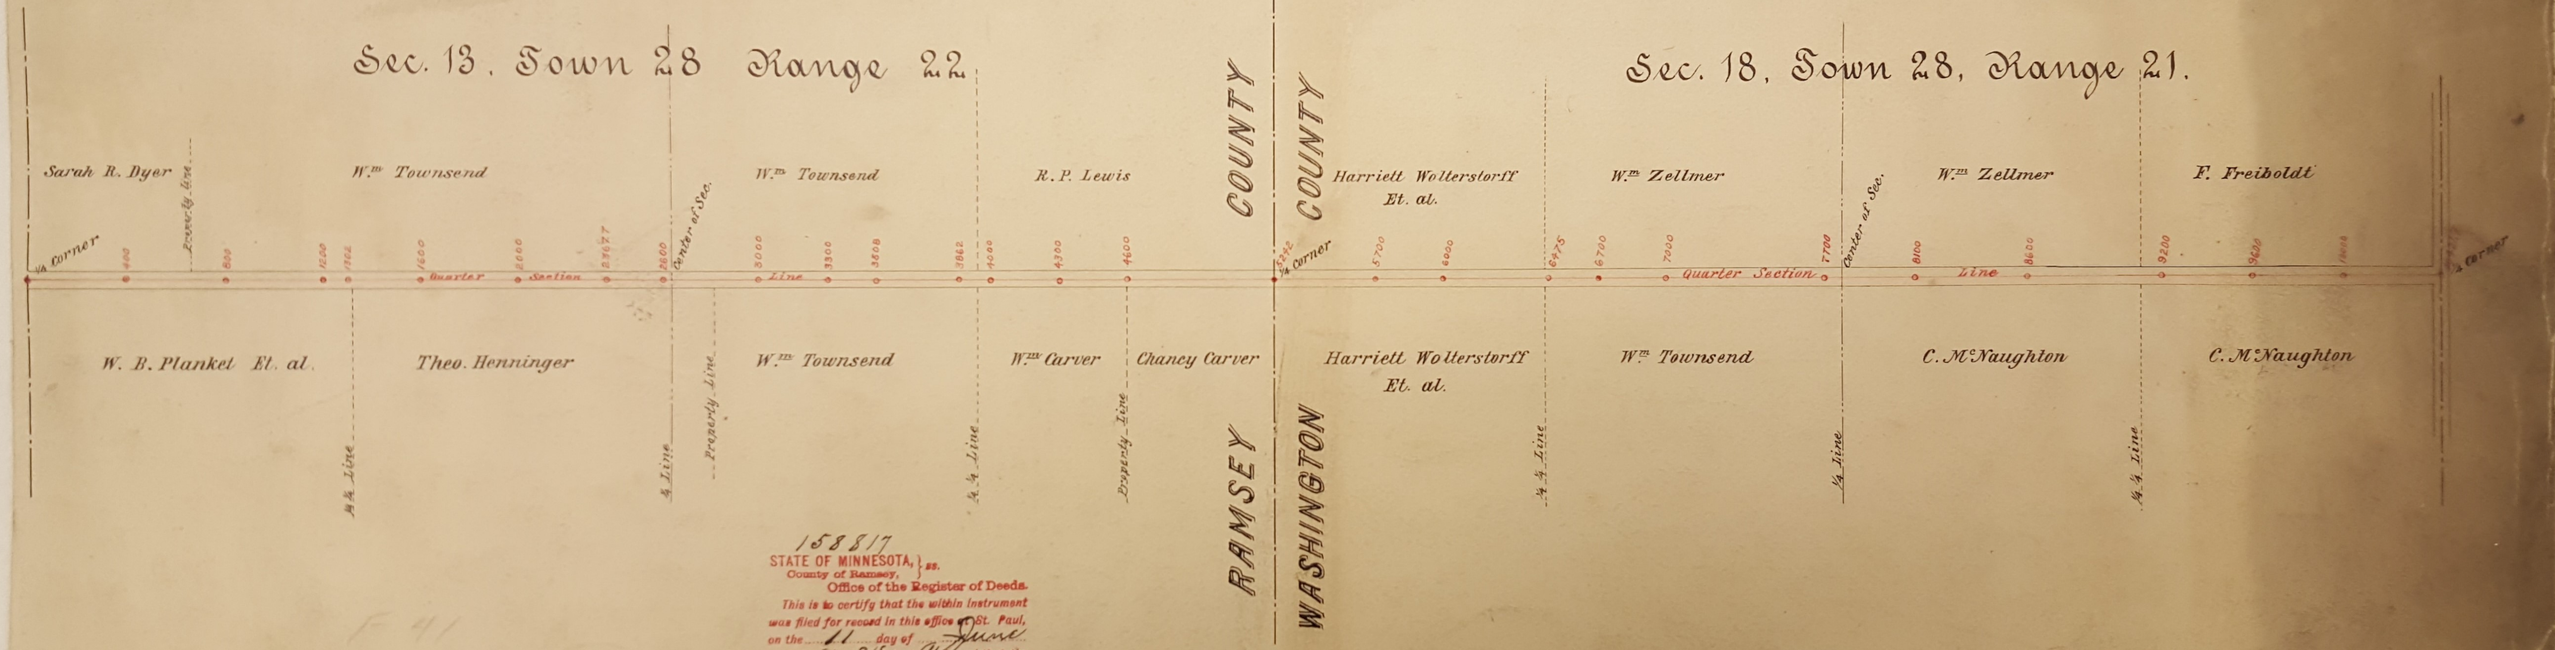

158817
STATE OF MINNESOTA, } ss.
County of Ramsey,
Office of the Register of Deeds.
This is to certify that the within instrument was filed for record in this office of St. Paul, on the 11 day of June A. D. 1892 at 8 o'clock A.M. and that the same was duly recorded in Book 2 of Mortgages Page 41
Register of Deeds.
By Deputy.