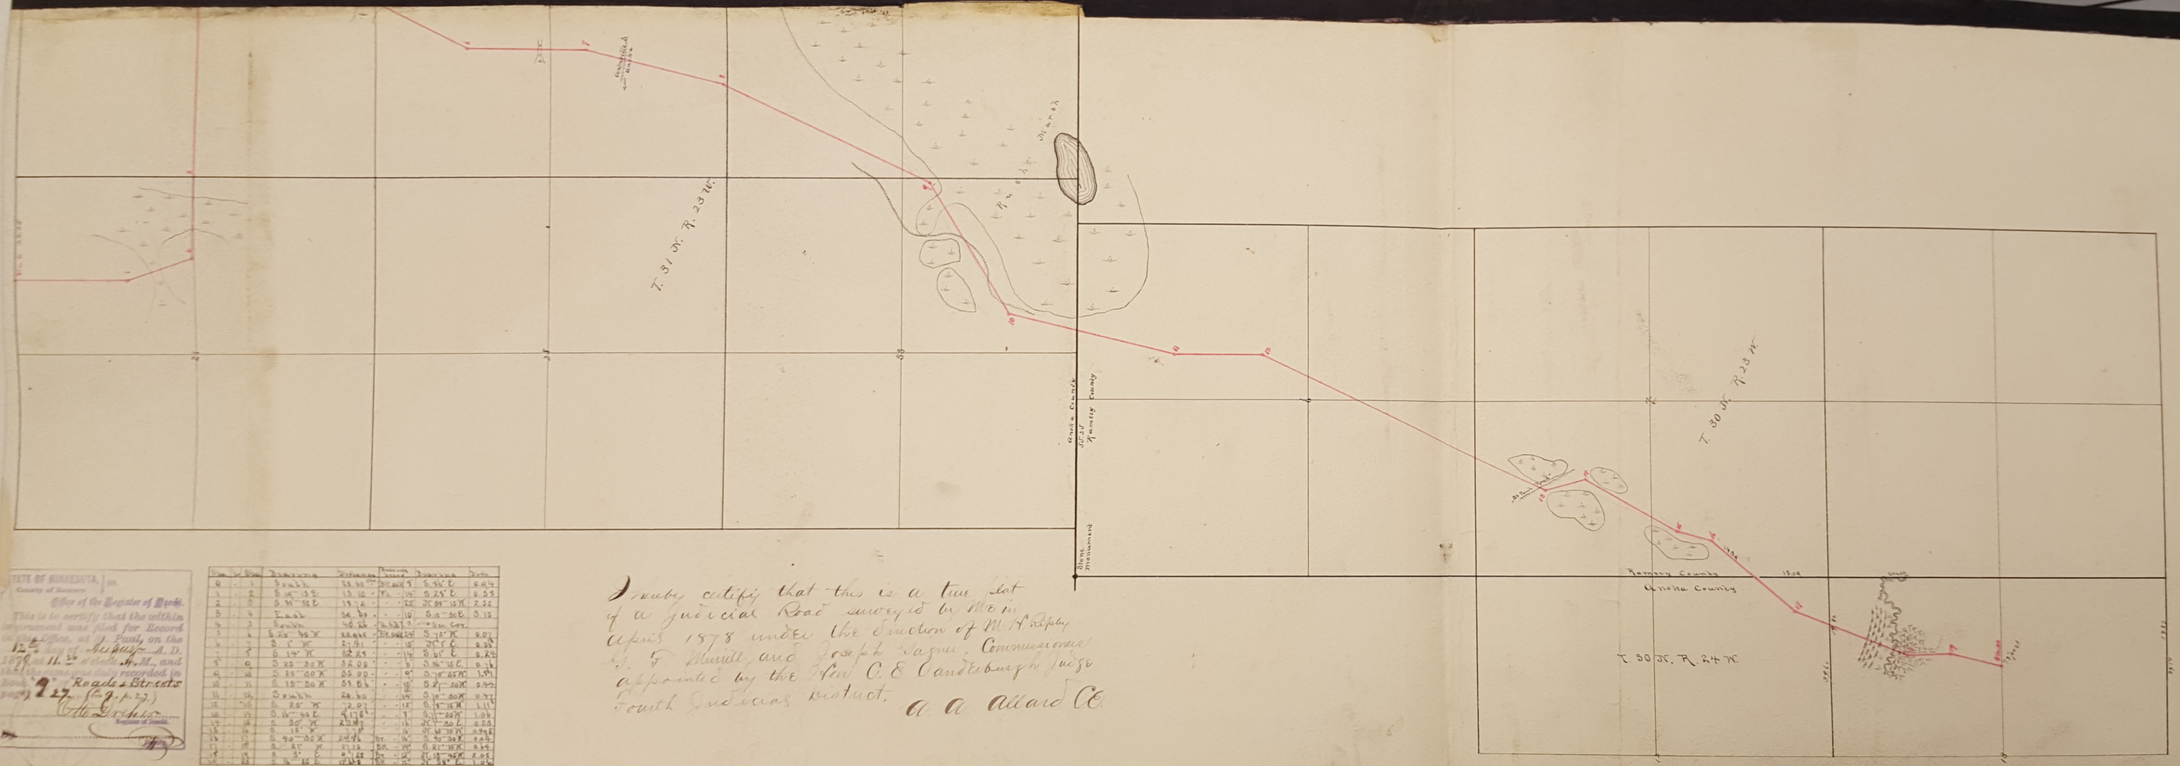

Mapped

JUDICIAL ROAD

Located through
parts of
ANOKA & RAMSEY
COUNTIES
Minnesota

Scale 1 in to an inch.

A. A. Allard C.E.
Anoka.

STATE OF MINNESOTA, County of Ramsey } ss.

Office of the Register of Deeds.

This is to certify that the within instrument was filed for Record in this Office, at St. Paul, on the 12th day of August A.D. 1878, at 11 o'clock A.M., and is recorded in Book of Roads & Streets page 227.

Geo. Gorman
Register of Deeds.

Line	No.	Bearing	Distance	Remarks	Bearing	Distance
0		S 0 0 E	33.00		S 0 0 E	0.04
1	2	S 16° 15 E	13.10		S 23° 5 E	2.53
2	3	S 34° 30 E	19.4		S 28° 15 E	2.52
3	4	E 0 0	34.00		S 0° 20 E	0.12
4	5	E 0 0	34.00		S 0° 20 E	0.12
5	6	S 25° 34 W	28.00		S 15° W	0.07
6	7	S 1° W	22.00		S 21° E	0.23
7	8	S 13° W	32.25		S 31° E	0.25
8	9	S 25° 20 W	32.00		S 38° 15 E	0.36
9	10	S 33° 00 W	38.00		S 46° 45 W	0.39
10	11	S 13° 30 W	33.00		S 2° 30 W	0.07
11	12	S 0 0 E	28.00		S 0° 30 W	0.07
12	13	S 25° W	32.00		S 1° 15 W	1.11
13	14	S 16° 30 E	41.00		S 1° 30 W	1.00
14	15	S 30° W	23.00		S 2° 30 E	0.22
15	16	S 18° W	17.00		S 11° 30 W	0.34
16	17	S 70° 30 W	20.00	Sta.	S 32° 30 W	0.28
17	18	S 41° W	21.15	Sta.	S 41° 30 W	0.35
18	19	S 5° E	21.00	Sta.	S 13° 30 W	0.01
19	20	S 15° 30 E	17.00	Sta.	S 5° 30 W	0.01

I hereby certify that this is a true plat of a Judicial Road surveyed by me in April 1878 under the direction of M. N. Ripley & J. Merrill, and Joseph Wagner, Commissioners appointed by the Hon. C. E. Vanderburgh, Judge Fourth Judicial District.

A. A. Allard C.E.