2.

AFTON ROAD

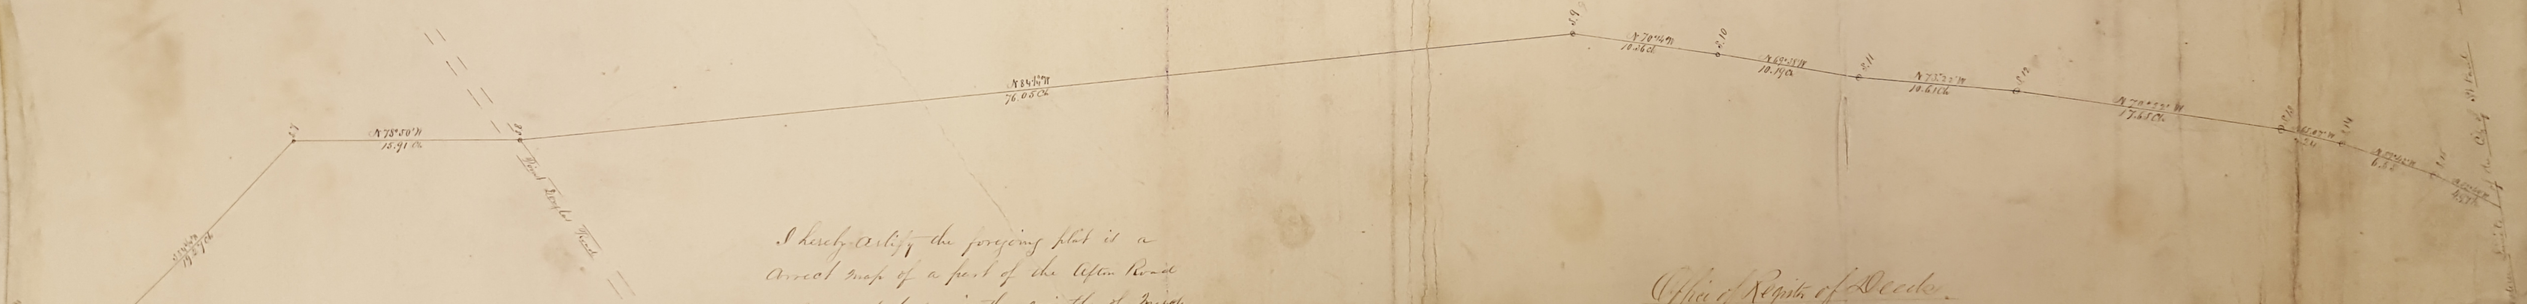

I hereby certify the foregoing plat is a correct map of a part of the Afton Road as surveyed by me in the month of March AD 1860

D. L. Cutler

St Paul Minn March 19th 1860

Office of Register of Deeds
Ramsey County Minn.

I hereby certify that the annexed Plat and Field Notes was filed in this Office for record this Eighteenth day of April A.D. 1860, at 1½ o'clock P.M. and was duly recorded in Book B of Roads & Streets

Sherman Hough
Register of Deeds