

OFFICE OF COUNTY ENGINEER
RAMSEY CO. MINN.

Road Map Survey

Co. Rd. "E" - S.T.H. 100

From *White Bear Ave* to *E. Co. Line*

Road Acc't. No. *S.T.H. 100*

Date Filed *2-16-27*

File *10*

Co. Rd. "E" (S.T.H. 100)

From

White Bear Ave To

East Co. Line

Sta. Point A-Lt A-Rt.

N 89° 57' E

191+33.5 P.I. 0°23'

S 89° 40' E

164+96.2 P.I. 0°23'

S 89° 17' E

138+60.2 P.I. 0°20'

2-16-27

FAIR-WARM

5

P.P. 0

39.15'

SEC. MONT.

STONE



Sign Post

34.80'

P.P. 0

95.10'

SEC. MONT. $\frac{26}{35} | \frac{25}{36}$



25.85' O.T.P. STONE

30-22

8" B.E. TREE

48.92'

SEC. MONT. 50.4 26-30-22



IRON PIN

42.91'

P.P.

4

Sta.

Pt.

Alt.

Art.

Calcu.
Bear.

Magn.
Bear.

217+66.40

N 89° 59' E

2-18-27

COLD-WINDY

6


SEC. MONT. E. Co Line



© G. R. Post

NAIL

© G. R. Post

 

Co. Rd. "E" (S.T.H. 100)

From

White Bear Ave

To

East Co. Line

143

142

141

140

139

+60.9 E White Bear Ave

138

137

143+0

2-16-27 (28)

+21 T.P. 29'

+52 P.P. 27'
+49 X Rd Sq. 12



CULTIVATED

CULTIVATED

+86 T.P. 28'

+53 T.P. 28'

+38 END SCHOOL

+12 24" B.F. 38'
+96 24" B.F. 38'

SCHOOL

+13 T.P. SCHOOL 28'

+96 P.P. 27'

+98 G.P. 27'
+97 14" B.F. 35'

WHITE BEAR AVE.

+62 4x3 BLINKER 17'

+26 P.P. 28'

+38 RD. SIGN 33'
+27 P.P. 31'
+27 T.P. 27'
+23 END HEDGE 32'

MEADOW

NURSERY

HEDGE 32'

50+00

49+00

48+00

47+00

46+00

45+00

44+00

15116

2-16-27

(29)

+52 P.P. 28'

CULTIVATED

φ

○

+98 T.P. 28'

+70 T.P. 28'

○

CULTIVATED

○

+33 T.P. 29'

+02 P.P. 27'

CULTIVATED

φ

○

+03 T.P. 29'

+61 Xins Sp. 16'

□

○

+62 T.P. 28'

57+00

56+00

+48 E.F.E. To Lt.

55+00

54+00

53+00

52+00 E.F.E. To Rt.

51+00

158+00

2-16-27

(30)

PAST.

+37 E.C. 29
END YARD

PASTURE

x x

x
y
x

+74 T.P. 28'

+98 P.P. 28'
+88 8" B.E. 27
+66 12" B.E. 27'
+48 E.F.E.

YARD

CULTIVATED

+133 T.P. 28'

YARD

+49 BEG. YARD

CULT.

+10 T.P. 28'

+97 P.P. 28'

CULTIVATED

φ

φ

CULT

+81 T.P. 28'

+68 END YARD

YARD

YARD
+100 E.F.E.

+80 BEG. YARD

CUL

+39 T.P. 28'

CULTIVATED

φ

64+00

63+00

+16 $\frac{1}{2}$ F.F. To Rt.

62+00

61+00

60+00

59+00

58+00

+96 X.F. 30'

165+20

2-16-27

(31)

F.L. 29'

PASTURE

F.L. 29'
+90 P.P. 27

F.L. 29'

F.L. 29'

F.L. 29'

+41 P.P. 28'

F.L. 29'

x

x

x

x

x

x

x

x

x

x

x

x

x

x

o

o

o

o

o

o

o

o

o

o

o

o

o

o

o

o

o

+28 END ROW T. 37'

+64 TREES 36'
+64 T.P. 25'

CULT.

+32 END YARD
+27 T.P. 26'
+16 Q.F.E.

YARD

+58 BEG. ROW T. 34'
+54 N.S.F. 29'

+88 T.P. 28'

CULT.

+49 T.P. 28'

+12 T.P. 28'

CULTIVATED

YARD

CULTIVATED

PASTURE

top of F.E. To Lt.

71+00

70+00

69+00

68+00

67+00

66+00

65+00

172+00

2-17-27

(32)

END YARD

+71 B.E.F. 28'

+25 12" PINE 35'

③

+08 F.F.E.

2-17-27
COLD & WINDY{ A.W. LINDAHL
A.L. PERSONS
W.G. ALEXANDER
E.T. SINCLAIR

YARD

YARD

+37 T.P. 25'

END +74 F.C. 29'

+40 P.P. 28'

F.L. 28

ORCHARD

+09 T.P. 25'

ORCHARD

+13 F.C. 27'

+87 F.L. 22'

CULTIVATED

+75 T.P. 25'

F.L. 22'

PASTURE

+41 T.P. 25'

F.L. 23

+87 P.P. 28'

+05 T.P. 25'

78+00

77+00

76+00

75+00

+88 ϕ F.E. TO Rt.

74+00

73+00

72+00

179+0

2-17-27

(33)

+10 F.C. 33'

+87 Beg. G.R. 15'

F.L. 34'


+42 P.P. 28'

F.L. 34

+77 F.C. 34'

CULT.

+89 P.P. 28'

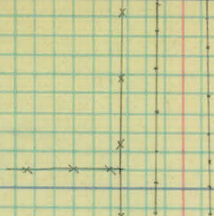

BRUSH

+10 F.C. No FENCE
33 OUT

+87 Beg. G.R. 15'

CULTIVATED

+70 12" OAK 33'

+34 12" OAK 35'

CULTIVATED

+73 END F. 30'

+35 8" OAK 36'

+13 24" OAK 27'
F.L. 30'

+88 F.E.

+05 13" OAK 34'
F.L. 29

F.L. 28'

F.L. 30'

+25 ϕ F.E. To Lt.

85+00

84+00

83+00

82+00

81+00

80+00

79+00

186+0

2-17-27

(34)

+75 F.C. 31' END YARD

+58 P.P. 28'

+25 P.F.E.

YARD

+70 12" DIA 31'

YARD

+20 F.C. 35' (PLEAS) Q Q Q Q

CULT.

F.L. 34'

+70 P.P. 28'

CULTIVATED

CULT.

F.L. 33'

CULTIVATED

F.L. 34'

F.L. 33'

+94 P.P. 28'

+25 G.R. 14.6' END

+36 G.R. 15.6' END

G.R. 13.9 F.L. 32'

G.R. 14.2

92+00

+33.50 $\frac{1}{2}$ BELLAIRE AVE

91+00

90+00

89+00

+65 $\frac{1}{2}$ F.E. TO Pt.

88+00

87+00

86+00

+60 P.P. 28'

BELLAIRE AVE.

+11 R.P. Sq. 28'

+13 P.P. 28'

CULTIVATED

CULTIVATED

CULT.

+65 F.F.E.

CULT.

+26 F.C. 31

F.L. 31

PAS

PASTURE

+31 X R.P. Sq. 12'

F.L. 31

99+00

98+00

97+00

96+00

95+00

94+00

+75

2 F.E. To Rt.

93+00

2001-00

2-18-27 (36)

FAIR & COLD
(A.W. LINDAHL
A.L. PERSONS
W.G. ALEXANDER
E.T. SINCLAIR)

CULTIVATED

+94 P.P. 28

φ

+55 END G.R. 15.1
+47 G.R. 14.2

+55 END G.R. 15.1
+47 14.3

CULTIVATED

+76 END WOODS
+76 END 37'

G.R. 14.2

G.R. 14.1

+34 R.D. 5g, 14'

φ

WOODED

G.R. 14'

FL. 38' G.R. 14'

+66 G.R. 13.8
+59 G.R. 14.5 36g
+44 P.P. 28

φ

+67 G.P. 14.8
+59 G.R. 15.1 36g

Woods

+86 F.C. 37' 36g Woods
+77 G.E.F.

CULTIVATED

CULT.

6+00

5+00

+50 E.F.E. To Rt.

4+00

3+00

2+00

1+00

200+00

207+0

+90 END WOODS

2-18-27

(37)

+11 G.R. 14.4
+04 B.E.G.R. 15'

+88 P.P. 28

BRUSH & WOODS

+40 WOODS

+50 F.F. 2

+51 P.P. 28'

+20 B.E.G. BRUSH 33'

CULTIVATED

CULTIVATED

CULT

CULT

+46 P.P. 29'

13+00

12+00

11+00

+48 ϕ F.E. TO R+.

10+00

9+00

8+00

7+00

214+00

2-18-27

(38)

+64 G.R. 14'
+62 END SG. 13'
+57 BEG. G.R. 14.9

+45 P.P. 28'

CULTIVATED

CULTIVATED

+00 END BRUSH 33

BRUSH

+04 CAR. BARN 36'
+90 CAR. BARN 36'
(12' WIDE)

+48 G.R.E.

+90 BEG. BRUSH 34

+65 END G.R. 15'
+59 P.P. 28
+58 G.R. 14.5

+62 END G.R. 15
+55 G.R. 14.0

G.R. 14.6

CULT.

CULTIVATED

G.R. 13.7

CULT.

CULTIVATED

G.R. 14.5
+95 END BRUSH 33

G.R. 13.8

+46 G.R. 13.8
+39 BEG. G.R. 14.5

G.R. 15'

20+00

19+00

18+00

+66.40 ~~E~~ EAST COUNTY LINE ROAD

17+00

16+00

15+00

14+00

+50 G.R. 35.8
 +46 G.R. 29.2'
 +44 Rd Sg. 31'
 +44 / Rm Rd Sg. 38'
 +41 G.R. 23.7
 +34 " 19.1
 +27 " 16.4
 +19 " 13.2
 +10 " 14.13
 G.R. 14.3'

+71 G.R. 14.5
 +64 Beg. G.R. 15.3

+72 P.P. 28'

CULTIVATED

E. Co. LINE RD.

(3'x4' Conc. Base)
 +68.4 BINDER 18'
 +50 G.R. 33.8'
 +44 " 27.4
 +39 " 21.3
 +32 " 17.3
 +25 G.R. 13.4
 G.R. 13.5'

G.R. 13.7'

CULTIVATED

G.R. 13.8'

G.R. 13.8'

