

OFFICE OF COUNTY ENGINEER
RAMSEY CO. MINN.

Road Map Survey

EAST COUNTY LINE ROAD

S.T.H. 100

From Highwood Rd. To County Rd. "E"

Road Acc't. No. S.T.H. 100

Date Filed.....

File.....

Road Acc't. No.

Date Filed. 5-14-26

File 10

of Ramsey Co. Engineer
ST. PAUL, MINN.

5-14-26

East County line rd.

North of lake Ave.

Alignment

Sta. 0+00 - 20+00

North of W. B. Lake

Station Ang. ht. Ang. Rt

20+00 P.O.T. End Survey

13+78.7 Mont. 0° 11'

6+29.6 P.I. 0° 24'

4+36.0 P.I. 1° 17'

0+00 P.O.T. No. Edge Hellwood Pav

24-15-26

Iron. Pin. $\frac{1}{4}$ - $\frac{1}{4}$ Cor.

6" Poplar. 36.77
(Grade 10-29-32)
63.40
T.P. 24.81
E $\frac{1}{4}$ Cor. Sec. 12

30.15 0 T.P.

54.14 0 2" stump

T.P. 44.17


62.15'

M. 80

Pavement
To. Hillwood

43.8 0
0+00 Edge. Pav.

Rd. Sign

 

East. Co. Line.

North of Lake Ave.

Sta 0+00 - 20+00

19' 14'

23' 16'

21' 15'


+ 08. P.P. 20 540

+39 Cable Xing

25 457
 100 Bush
 5 457
 1000
 1000

440

 $+84-14^{\circ}25'$

+64-14" @ 25

456 P.P. 23' R4

+27-18" @ 50.5"

 $2 \neq 0$

+46-15" @ 21'
+42-15" @ 28'

Plotted Property.

Undeveloped band.
Scattered Timber

+ 25 P.P. 27.5

408-14' 53' 23" 2400

+59-15" @ 23'
+51-20" @ 20.5'

 $+74 - 10^{\circ} \text{E} @ 25$

+93-5" @ 15 +95-5" @ 26
+90-14" @ 29'

Edge. Rd

100 Road

1400

+175 P.P. 31
+61-12" Gd 22
+55-16" Gd 17
+59 End. Gd. R. 16
+43 Gd. R. 16
+25 Gd. R. 21

Gd. Rai / 33.5 D + 0.1

14

8

15

10

16

14

13700

443 End Berry Patch

Formyl, Cult.
+ 9 hond

+67 P.P. 18.5

$$+36 - 8'' \approx 26''$$

415-6" @ 21'

200 M. 8. 15. 0

12400

 $+92\frac{1}{2}$

Walk 4' Wide - 18" R/L
± 50' - 12" SD 19'

#70 T.P. 14

464-12" (32)

709-12 5021

 $+47-20 \oplus 17.5$

445-10" x 22.5 G.M.R

Berry Patch.

129 * RCL

436 P.P. 15.5
1000 22.56

10" X 22" } V.P.

 11 ± 0.0

Cultural

+30 T.P. 17'

10" X 24 C.M.P

407 E Road

10.400

Farm 4 and

9700

±55% drive

107 P.P. 17.5

8400

+60% drive

Cultivated
land

7400

+58-16" @ 20

452-6" 822

731 P.P. 24

454 R.P. 18.5

6400

9.0 Dirt Road End.

9.0 Dirt Road. No. Gravel

1.2 9.0 End Gravel Surface

Cultivated

+35 P.P. 18'
+34 T.P. 10'

170. Berry Patch 18.5

Berry Patch 18'

+53 P.P. 18'
+53 T.P. 11'

+92 - 30" ED 21'

Cult. hand

+36 - P.P. 18.5'
+31 T.P. 12.5'

B. Patch 18

353 E. Drive

+66 - 20" ED 36'

+75 M.B. 14' P.
+72 - 20" ED 26'

Cult hand


B. Patch 17

+96 P.P. 18'
+88 E. Drive
+76 T.P. 14'

+40 Bag, Berry Patch 16'

+14 - 20" ED 20.5

Cult hand

 

S. T. H. 100

East. Co. line. Rd. ~~#4~~

Sta - 0+00 - 636+09 - 503+34.2

Alignment.

From High Wood Rd. To Co. Rd. "E"

Austin.

Wilshusen

Skoglund

Tankoski

Fritz

Alexander

} Party

Station

Ang. ht.

Ang. Rl.

52+73.25 Mont.

43+62.6 P.O.T.

26+31.4 Mont.

15+80.75 P.O.T.

0+00 Mont.

Highwood Road.

N 10° 13' E.

N 10° 00' E.

G.P. 52.57
 60.51 G.P.
 (Grade 10-22-32) E. 1/4 Cor. Sec. 12

12" Oak
 75.40
 18" Oak
 57.41
 24.83 - 010° S.E.
 32.28
 4" B.E.
 (Grade 10-22-32) S. E. Cor. Sec. 12

32.75
 T.P. 31.75 G.P. #132
 31.85 G.P.
 33.95
 (Grade 10-22-32) E. 1/4 Cor. Sec. 13
 Iron Rd. Sq.

Station

Ang. ht. Ang. Rt

131+89.3 ^{PI} Mont.

0°24'

105+49.4 ^{PI} Mont.

0°23'

79+14.5 ^{PI} Mont.

0°09'

69+27.5 P.I.

0°23'

52+73.25 ^{PI} Mont.

0°07'

N 1°07'E




N 0°43'E

N 1°06'E

N 0°57'E

N 1°20'E

N 1°13'E

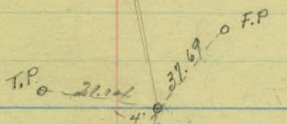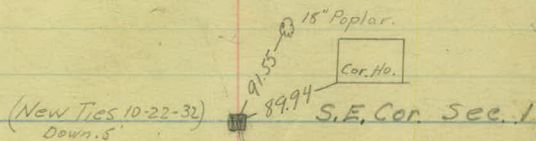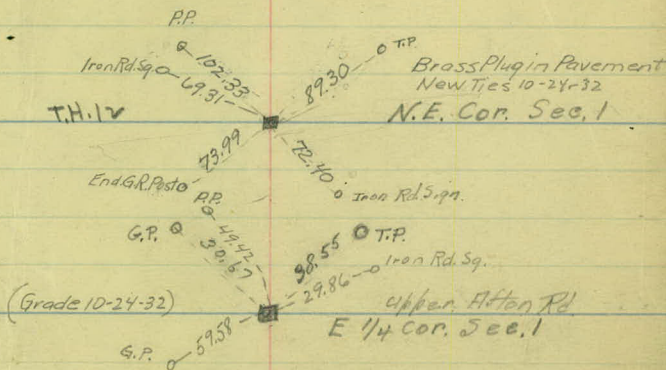

Read

179.58

E 1/4 Cor. Sec. 12

Station

⁴
Ang. ht. Ang. Rt

139+17.47 P.T.

N 5°34'E

137+86.2 P.I.

10°32

136+54.14 P.C.

135+51.7 P.T.

N 4°58'W

134+50.4 P.I. 6°05'

133+48.9 P.C.

N 1°07'E

Rd. #4

2-13-26


136+50.14 - 0°00'

137+00 - 0°58'

138+00 - 2°55'

139+00 - 4°55'

139+17.47 - 5°16'

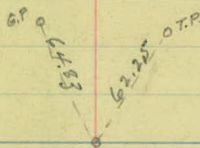

4° Curve Rt.

$\Delta = 10°32'$

Rad = 1432.69.

Tang. = 132.06

Length = 263.33


133+48.9 - 0°00'

134+00 - 0°46'

+50 - 1°31'

135+00 - 2°16'

+51.7 - 3°02½'

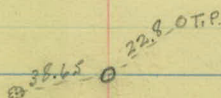

3° Curve Lt.

$\Delta = 6°05'$

Rad = 1910.08.

Tang. = 101.49

Length = 202.78

Station.

Ang. ht. Ang. Pt.

185+045

Mount.
PI

0°25'

158+484

Mount.
PI

00°01'

153+46.6

P.O.T

143+34.2

P.T.

142+430

P.I



4°29'

141+31.7

P.C.

N 1°08' E

N 1°07' E

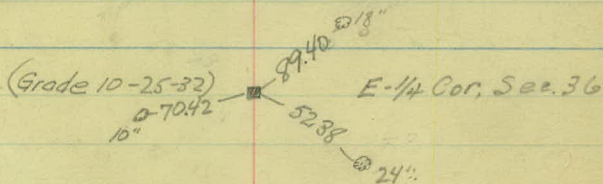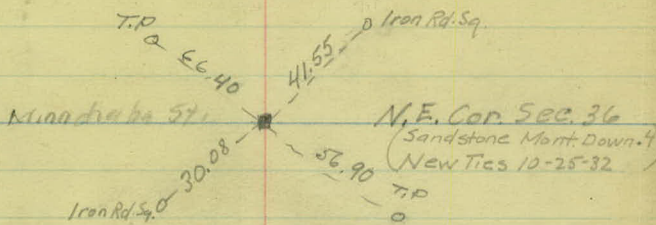

8" oak

T.P.

41.04

52.15

146+31.7 - 0°00'
 147+00 - 0°41'
 143+00 - 1°41'
 143+54.2 - 2°13 1/2'

2° Curve Lt.
 A = 4°22'
 Rad = 2864.93.
 Tang = 111.32.
 Length = 222.50.

40.3

Station

909.8t 909.8t

778+949 P.O.T




N 2° 09' E

Mont.
711+44.9 P.E.

1° 26'

N 0° 43' E

700+78.8 P.O.T

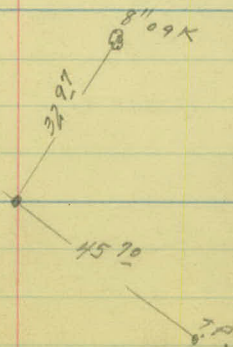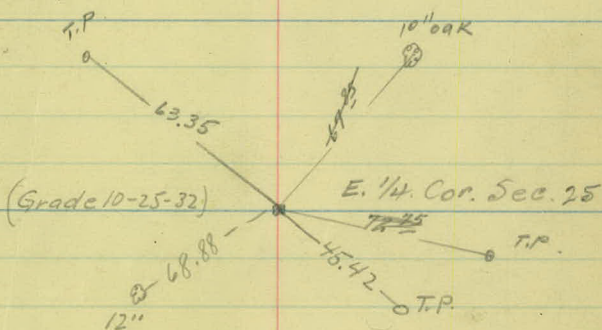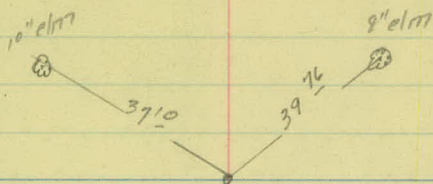

Station

ang. Lt. ang. Pt.

N 1026'E

764+43.60 Next
P.I.

0° 01'

N 1025'E

737+92.70 Next.
P.I. 0° 44'

N 2009'E

730+22.9 P.O.T

Cont. / H.L. Wilschus 017
SKEO 9/10/11
E. Fritz
JANKOSKI

7-10-76

(Grade 10-25-32)

T.P. 0 75 ³²/₁

62 ³⁵/₁

10" OAK

③

E. 1/4 Cor. Sec. 24

41 74

9" OAK

T.P.

0

28 ⁶³/₁

(Grade 10-25-32)

18" OAK

③

N. E. Cor. Sec. 25


34 ²⁰/₁

56° 55'

to Still Water

20' Pavement.

S.T.H. # 45

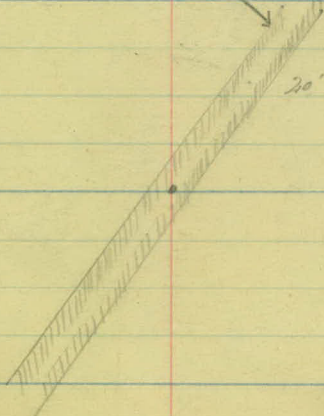

Station

279.Lt. 279.Rt.

N 1° 24' E

290+89 9 1" pipe

PL

0° 02'

273+90 55

N 1° 26' E

273+74 35

G.P.
3 Nails

53 12



3-11-26
H.L. Wilchusen
J.K. - 9/1/17
Fritz
Jankowski

Co. Rd. A.

23.70 N.E. Cor. Sec. 24
Iron Rd. Sq.
35 28

T.P. 62 57
0

G.P.

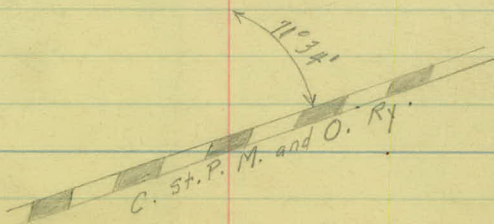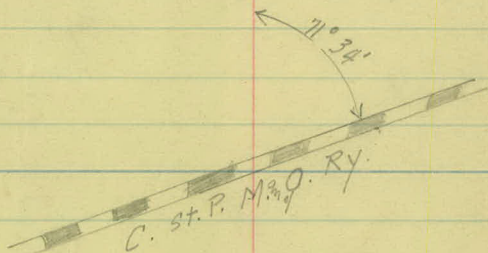

Station Point ang. Lt ang. Rt.


321+22⁰ P.O.T.

N 1° 04' E

317+36²⁵ Mont.
PI 0° 20'

N 1° 24' E

295+25³⁰ P.O.T.

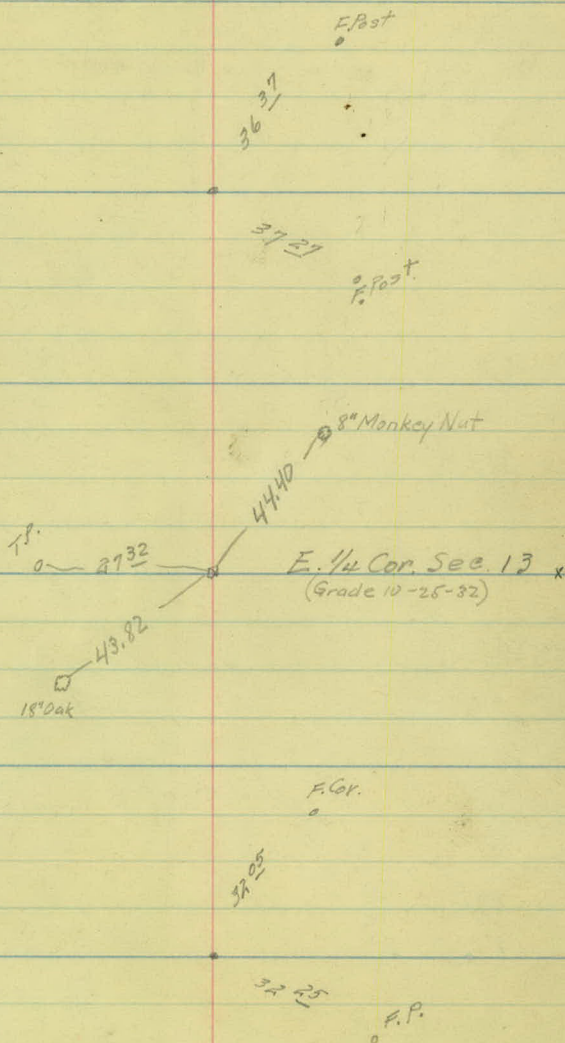

Station Point Lt. A Rt.

389+94.0 P.O.T.

379+00.00 P.O.T.

N 1° 21' E

370+08.5 ^{PI} Mont.

0° 09'

363+53.0 P.O.T.

N 1° 12' E

343+64.0 Mont.
P.T.

0° 08'

N 1° 04' E

station point Lt. Δ Rt.

417+66.7

P.T.

18°-30'

20° C. Rt.

+50

16°-09.8'

Δ 87°-00'

417

11°-09.8'

P.I. 416+78°

+50

6°-17.8'

T. 96.3.

416

1°-59.8'

L. 185.°°

415+81.7

P.C.

0°-00'

R. 287.94'

400+05.45

P.O.T.

N 1°29'E


396+40.1

P.I.
Mont



0°-08'

N 1°21'E

FROM
HERE

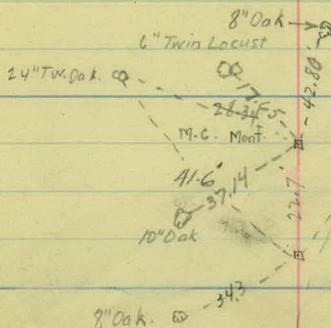

(Grade 10-25-32)

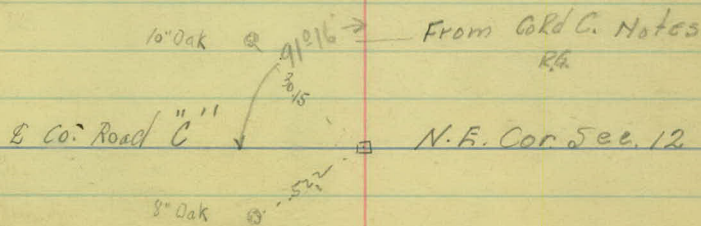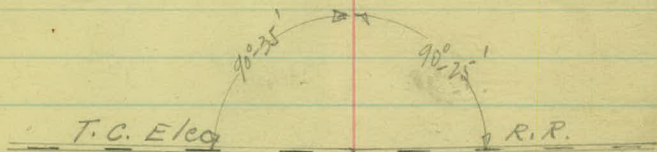

Ang. ht. [#] Ang. Rt.

423+07.6 P.T.

420+30.3 P.I. 22°00'

421+50.5 P.C.

420+82.9 P.T. 16°45'

20°-C.Lt.

+50

13°28'

Δ 33°30'

420

8°28'

P.I. 420+02.1

+50

3°28'

T. 86.7'

419+15.4 P.C. 0°00'

L. 167.5'

R 287.94

3-16-26
Cold + Windy

Sta. - Def


421+50.5 - 0°00'

422+00 - 3°28'

+50 - 6°58'

423+00 - 10°28'

+07.7 - 11°00'

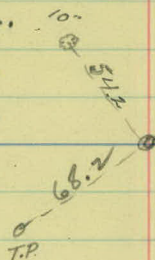

14° Curve ht

$\Delta = 22°00'$

Rad = 410.28'

Tang = 79.8'

Length = 157.1'

T.P. 88.78'

14" Oak 45.88' R.R. Spike.

²
Ang. ht. Ang. Rt.

434+85.8 P.O.T.

427+85.5 P.T.

427+18.8 P.I.

41°00'

426+44 P.C.


426+08.2 P.T.

425+46.8 P.I. 22°30'

424+83.2 P.C.

3-16-36
Cold + Windy

T.P.
0

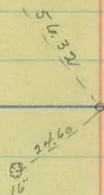

To here

Sta - Def

426+44.1 - 0°00'

+50 - 0°51'

427+00 - 8°06'

+50 - 15°21'

+85.5 - 20°30'

T.P.

Q

48.37

(Grade 10-25.32) Rad = 199.70

Iron Sq.

5.15

Mean. Tang = 74.7

Cor.

Length = 141.4

33.05

T.P.

Sta - Def

424+83.2 - 0°00'

425+00 - 10°31'

+50 - 6°01'

426+00 - 10°31'

+08.2 - 11°15'

T.P.

75.4

91.9

10"

18° Curve. ht

$\Delta = 22°30'$

Rad = 319.62

Tang = 63.6

Length = 125.0

Ang. Ht. Ang. R.

517+43.1 P.O.T

N 1° 39' E

503+34.2 P.I. 00° 12'

488+00.3 P.O.T.

484+78.1 P.O.T.

N 1° 27' E

476+95.8 P.I. Mont 00° 02'

450+57.8 P.I. 00° 02'

N 1° 29' E

N 1° 27' E

90° 32'
 Top G.R. Post 35.48
 County Road "E"
 40.28
 89° 58' R.P.
 New Ties 10-26-32
 Hole in Pavement
 & Pavement.
 N.E. Cor. Sec. 36
 35.65
 89° 40'
 Top Gd. Rail Post
 89° 50'
 Top Gd. Rail Post

32.23
 End. Fence Post
 ctr. Ball Top of Post
 32.65
 14"
 43.30
 F.P.
 37.19
 F.P.

T.P.
 73.03
 27.30
 6" Oak
 East 1/4 Cor. Sec. 36
 Mont. Found. 1' down
 (Brass Plug in Pave.)
 New Ties 10-26-32
 88.15
 12"

Co. Road "A"
 T.P. 70.55
 75.50
 15" Oak
 Brass Plug in Pavement
 New Ties 10-26-32
 Estab. from Ties
 S.E. Cor. Sec. 36
 49.20
 Iron Rd. Sq.
 47.00
 T.P.

Station

Ang. ht. ^h Ang. Rt.

556+15²⁵ P.O.T. $\frac{1}{2}$ T.C. E/c. Ry.

N 1°52' E

556+06¹ Mont.
P.I. 0°56'

544+88⁵ P.O.T.

N 0°56' E

529+68⁸ Mont.
P.I. 0°43'

N 1°39' E

E CO LINE ROAD #22

WHITE BEAR

LAKE.



SEC

2 5

COUNTY

51m Bd.

ROAD E.

SEC

36

COUNTY

COUNTY

WASHINGTON

179060
101042
780180

E.P. 4533

T.P.

4393

Iron

ROAD "D"

(1924)

46.93 T.P.

(1924)

27.64. 0"

2638.32

2635.30

2646.5

4430

3515 FT.

32.77

24370

572.71

473

138.8


611

3705

1677

5437

8097

 

E. Co LINE ROAD #22

SEC

36

E.P.

T.P.

COUNTY

ROAD "D"

✓ Iron

(1924)

46.93

T.P.

34466
56464
70932

SEC

SILVER
LAKE

T.

5873 T.

(1924)

(1924)

PAUL RD.

ROAD "C"

COUNTY

NORTH

ST PAUL

N.

T.

ST.

SEC.

12.

0 4864

0 4864

26 4402

26 4402

WASHINGTON

COUNTY


ROAD "B"

T.P.

5373

4724

T.P.

 

E Co. LINE RD. #22

SEC

12
NORTH

COUNTY

ROAD "B"

ST PAUL

SEC

13

COUNTY

COUNTY

ROAD "A"

SEC

24.

WASHINGTON

53.73
I.P.

57.73
T.O.
25.57

33.69
I.

GP.
53.10

47.24 I.P.

34.0 0


63.33 I.

65.55 T.
52.31 0
49.55 0

66.62

55.71

131281
131281
131281
132275
132275
132275
26455
26455.50

 

Eco LINE ROAD #22

SEC

24

772.55

29.75

410

STILLWATER

SEC

25

TP. 46.21

TP. 66.28

MINNEHAHA

ST.

SEC

36

32.62

2655.26

HUDSON

ROAD.

34.46

34.55

34.18

41.50

60.95


56.88

12.8

51.40

ALNOO

WASHINGTON

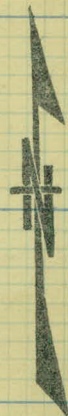

5"
3.5"
6"

45.69
6"

1069 + 388

HUDSON

ROAD.

①

E Co LINE RD.
#22

UPPER

AFTON. S

ROAD.

G.P.

36.71 TP.

44.91

67.98

TP. 400

TP.

18" pipe

475' W.

RD.

TP. 385.1

60.5% EP #120

LOWER AFTON

G.P.

12 RD.

582.2

2646

LINE

5741 BO.

51.65-84

60.5% BE

E.

385 PP

HIGHWOOD

RD.

SEC. 13

P.O.T. 0.00

39.75

Guy Pole.

Willow

Willow

54.3

Willow 34%

CARVERS LAKE.

P.O.T. 17+91.55

281.4	4
71.4	3
450.3	


Carvers

Lake

Survey

$$\begin{array}{r} 588+79.5 \\ 2+66.4 \\ \hline 591+459 \end{array}$$

$$\begin{array}{r} 280.8 \\ 72.2 \\ \hline 353.0 \end{array}$$

 

See 12

96"

41.25

137.4

good

87.74

27.39

12"

2924.93

8"

86.55

2636.08

71.60

Scrub.

Scrub

14735
13797
1148

2739.76

Soaking

good

63.36

14.07 T.P

12.80

14935


T.P.

25.57

26.33

3' tall in tie

86.5

 

Road #4

East. County line. Road.

Artificial Topography.

Sta. - 0+00 - 636+00

Sta - 0+00 - 20+00

Gravel Shoulder
Surface Width


16' 22

20 16

0400

+6⁸ M.B. 11' 4"

+ 27 P.P. 17' RH.
3.5 x 5 x 18"

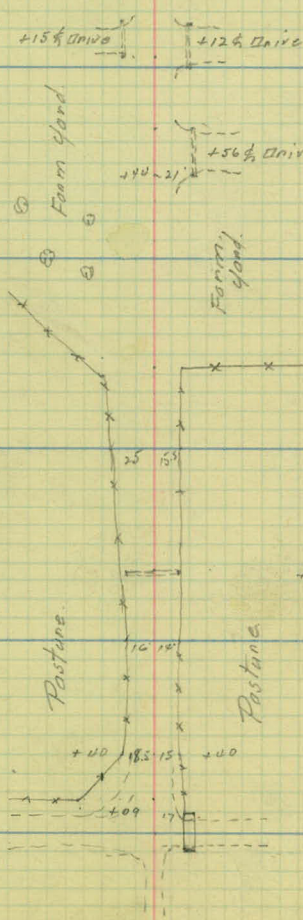

23

17

6400

23

17

+96 T.P. 23' 6"

18.5 15

+92-10" X 30.5 C.M.P

20+00

+70 P.P. 27' R²

Waste
hand

Waste hand

19+00

+46 T.P. 24.8

Cultivated land

18+00

Cultivated

17+00

+93 T.P. 25' 11"

16+00

+50 T.P. 27' 11"

+63 P.P. 27.5"

15+00

Cultivated

Cultivated

+03 T.P. 28' 11"

14+00

13+00

21

15

21

15

27+00

Cultivated

28'

High Timber

+31.5

28

22.5

+31.5

Chicken

Yard

26+00

+70 Ft. Cor. 21.5

+37-12" x 30" C.M.P.

Farm

Yard

+34 (8" @ 24' R)

25+00

+50 M.B. 18.5

27

+93 4' Drive

+36 T.P. 25.5

Pasture

pump
house

24+00

+90 P.R. 27.5

26'

23+00

+59 T.P. 20.5

22'

Pasture

Cultivated land

22+00

+69 Ft. Cor. 18.5

18.5

+45 T.P. 22.61

Farm
Yard

+07 M.B. 12.61

21+00


+80 4' Drive

Waste
landWaste
land

20+00

21 ' 16'

Cultivated.

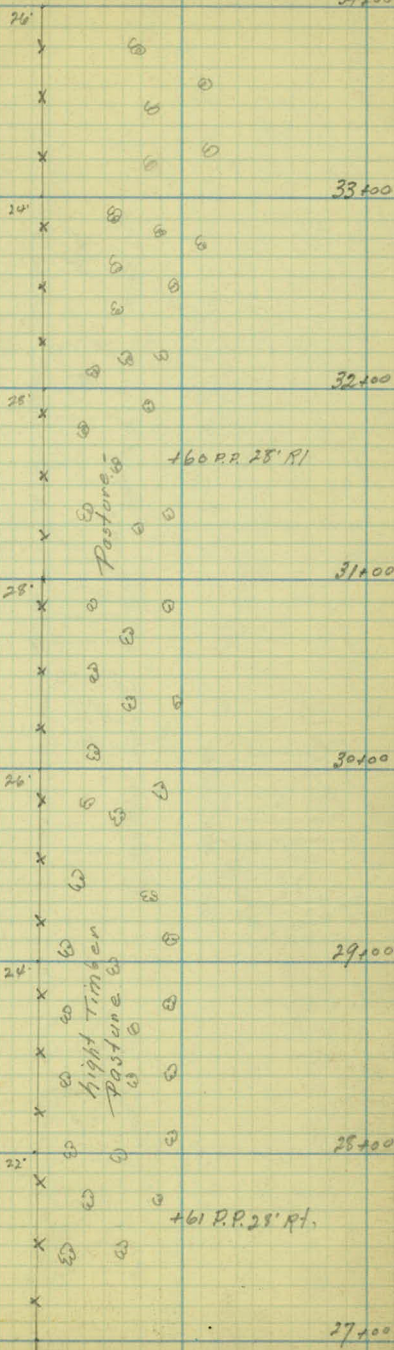

21 16

38 + 00 20 15

22' 16'

41+00

+72 Fc. Cor. 18'



+16 P.P. 27' R1

40+00

+90 +96 Fc. Cor. 18' 1/2
36" X 33" C.M.P.


Cultivated hand

39+00

38+00

37+00

Cultivated hand

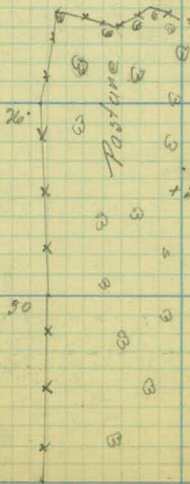

+45 Fc. Cor. 35' R1

36+00

+50 P.P. 28.5

35+00

34+00

24 16'

48+00

47+00

Cultivated land

46+00

Cultivated land

45+00

454 P.P. 27. 14

44+00

Cultivated land

43+00

Cultivated land

42+00

41+00

22

16'

55+00

54+00

+30 G.P. 15' H

Cultivated land

12.5' 18'

Cultivated land

+28 P.P. 27.5' H
+14 (24" X 22.5' C.M.P.)

53+00

52+00

51+00

50+00

Cultivated land

Cultivated land

+02 P.P. 27.5'

49+00

48+00

23 18'

24 18'

62+00

+36 T.P. 20' ht.
+15 (18" x 44' C.M.P.)

20

61+00

Cultivated land

Cultivated land

60+00

+79 T.P. 19' ht.

59+00

+16 T.P. 19' ht.



58+00

Cultivated

Cultivated

57+00

+68 Rd. Sign 23'
+68 T.P. 21' ht.

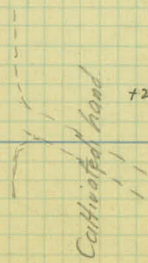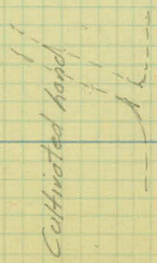

+21.30 ϕ Lower Milton Rd.

56+00

+01 Rd. Sign 18' ht.
+00 M.B. 18.5

+83 Rd. Sign 25

55+00

24

18'













+82 T.P. 20' ht

69+00

68+00

67+00

66+00

65+00

64+00

63+00

62+00

23' 17'

23 17

24 18

76+00

+65 T.P. 18.5

75+00

+07 T.P. 19' 64

74+00

73+00

+48 T.P. 20'

72+00

+92 T.P. 20' 84

71+00

+34 T.P. 20' 44

70+00

69+00

Cultivated land

Cult. land

Cult. land

Cultivated land

Cult. land

29'

+17 R. Cor 20.0

24

18


7600

+20 T, R. 17.5

Cultivated

Cultivated hand

Cultivated hand

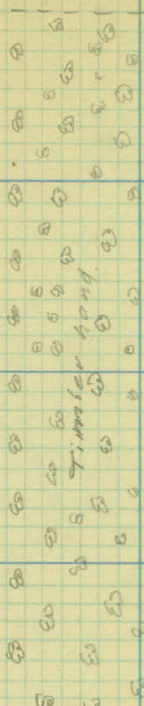

22

16

95+00

89+00

88+00

87+00

86+00

85+00

84+00

83+00

+59 T.P. 18.5

+97 T.P. 18

+44 T.P. 18.5

+21 F.C. Cor. 20.5
12" x 18.5 C.M.P.+24 $\frac{1}{2}$ Drive

+84 T.P. 18.5 H

Pasture

Pasture

Calibrated road

Concrete Brg.
5' 5106 1' thick
{ 15.5 long,
Opening 4' x 2.5 }

+21.5 (12' x 37' V.I.T.P.)

23' 17'

22 16

97400

+39 T.P. 19.5

+40 (30" X 49" C.M.P.)

96400

+36 T.P. 19' H

Cultivated land

Waste land

95400

12" X 18.5 C.M.P.

+33 T.P. + End Fe. 18.5

+55 1/2 Inve

94400

93400

+39 Fe. line

+39 Fe. line

92400

+78 T.P. 18' H

Pasture

+26 Beg. Fence, 14' R/L

91400

+86 1/2 Inve (20" X 15" V.P.)

+77 T.P. 19' H

90400

23

17

104200

+92 T.P. 22.5

103200

+50 T.P. 21' 41"

Cultivated land

Cultivated land.

102200

101200

+96 T.P. 19.5

100200

+47 T.P. 18.5

Cultivated land

Cultivated land.

99200

+96 T.P. 19' 41"

98200

+97 T.P. 21.5

97200

23 18'

25 18

111+00

+19 T.P. 23

110+00

+96 T.P. 20.5

109+00

+86 T.P. 22.5

+41 T.P. 16

108+00

+60 T.P. 22' R.L.

107+00

+86 T.P. 16

Cultivated land.

Cultivated land.

+52 T.P. (19.5-25)

106+00

+75 Iron Rd. Sign 21.5
+75 R.P. 17.5

+80 T.P. 23

+43 Rd. Sign 27

18" x 40' Con. P.

18" x 50' C.M. P.

+10 T.P. 24' Ht.


105+00



104+00

21 17

23 17

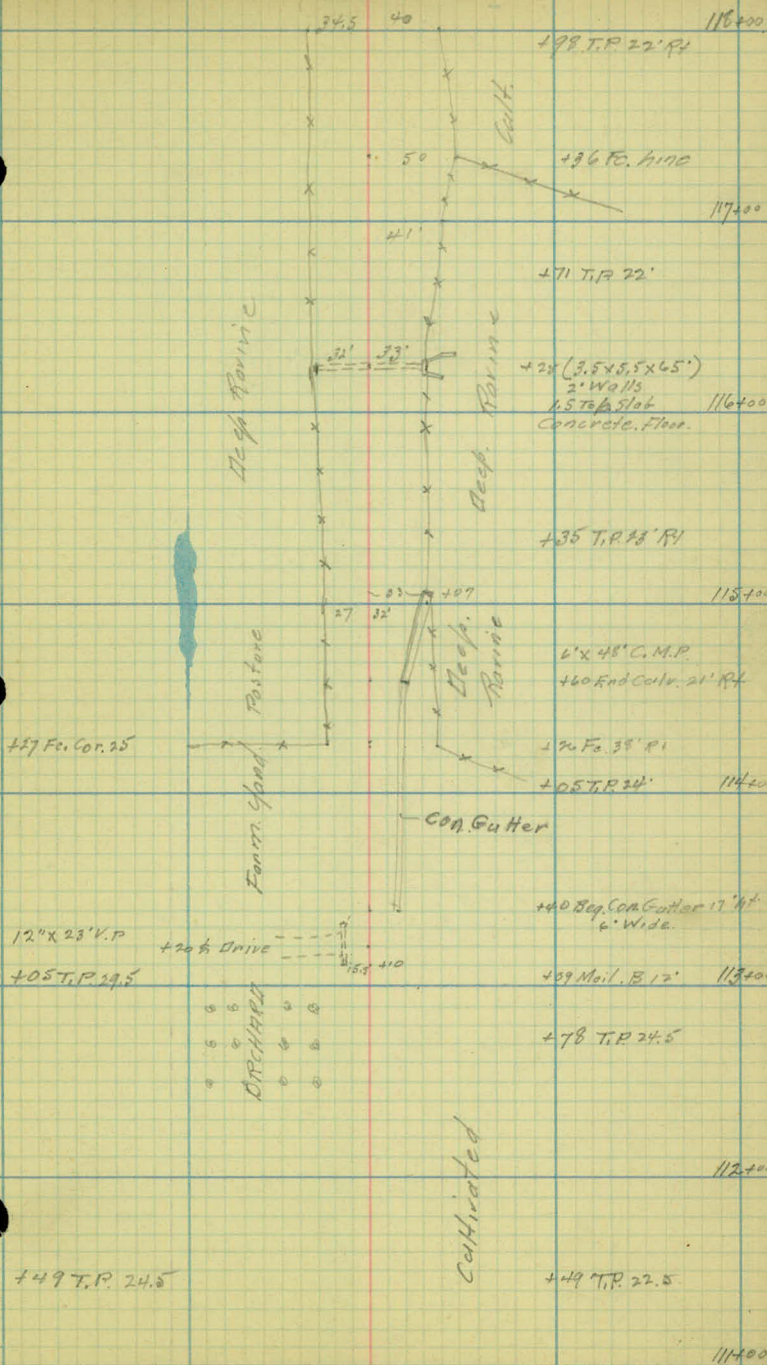

24

18

125+00

+23 T.P. 23.5

124+00

+72 End. Fe. 23'

+97 T.P. 23' Rt.

123+00

122+00

+60 T.P. 23'

121+00

+36 Fe. hinc

+37 T.P. 23'

120+00

Cult. hand

Cultivated hand

119+00

+70 Fhise.

+70 Fe. Cor. 31

+33

+50 F.E.

20' x 14' V.P.

118+00

26' 22

23' 18

130 + 00
+98 J.L. 4th St. 1894

+57 Rd. Sign 45'
+54 Rd. Sign 42'

+11 M.B. 15' RT. (5 Boxes)
131 + 00

+57 T.P. 25'
+55 Rd. Sign 16' RT.
ART. NY

+76 T.P. 26' RT.
130 + 00

+48 T.P. 24'
129 + 00

+19 T.P. 20'
128 + 00

127 + 00

+58 T.P. 24' RT.

126 + 00

+61 T.P. 24' RT.

125 + 00

Cultivated land

Cultivated land

138+0.0

137+00

136+00

135+00

134+00

133+00

132+00

+42 G.P. 34'

+19 Cross drain 35'
S.L. 25'

+84 Lake Sign 22
+82 G.P. 29

+43 L. drive

S.L. 18'

+41-2 TRAP 36

+86-2 Trees 29

S.L. 15'

+87 Stop Sign 15
+36 G.P. 28'
+26 C.Rd. Sign 36

18" CM

Tanner's Lake

cultivated lake shore property

+79 Ca. Lake Sign 26

+40 T.P. 22'

+19 Col. 15'
Lake 37 S.L. 27

Lake 38

+86 T.P. 21'

Lake 35 S.L. 19'

+64 T.P. 19'
+60 T.P. 35

+81-Trap 26'

Lake 70'

+65 T.P. 21'

Lake 125'

+49 T.P. 22

S.L. 14'

+14 T.P. 42'
+6 T.P. 25'

145+00

144+00

143+00

142+00

141+00

140+00

139+00

3/8/26

+72 T.P. 28'

Woods
400'

+42 Cor FL: 33
+29 ~~drive~~
+20 Cor FL: 21
+08 T.P. 29'
FL. 30'

FL. 30'

+70 + Fence 31

FL. 31

+15 B. FL. 29
+07 drive
+90 tree 29'
+70 tree 29'

Yards

+32 Tree 28'
+12 Tree 29'
5.617'

+87 Tree 28'
+64 Tree 28'

+40 tree 28'
+16 tree 28'

+99 Tree 27'
+71 Tree 28'

Yards

Lake Shore property

Lake

Runners

+71 H. FL 25'

+46 T.P. 28'
+31 - ~~drive~~

FL. 28
4 Trees 25
+ 81 Tree 25

+14 T.P. 21'
FL. 24

+13 FL 25'

Lake 50'

+3 T.P. 19

Lake 32

T.P. 21 Lake 32'

Lake 34'

152+00

151+00

150+00

149+00

148+00

147+00

146+00

3/8/26

cultivated

+41 T.P. 32'

F.L. 33'

+90 B-of Cult.

+23 T.P. 32'

F.L. 33'

F.L. 32'

+16 T.P. 32'

pasture

F.L. 33'

+52 T.P. 32'

pasture

F.L. 32' - S. L. 1/4

+32 Tree 22'

Property

+05 T.P. 28'

lakeshore

+174 F.L. 29'

+90 E. of F.L. 32' x x x x x

F.L. 32'

F.L. 32'

F.L. 31

+65 ~~Advised~~
12" x 18" C.M.P.

F.L. 31 - S.L. 1/4

F.L. 31

F.L. 32

Woods

Woods

Woods and yard

0.17' +59

159+00

158+00

157+00

156+00

155+00

154+00

153+00

+73-15" x 32' V.P.

17' 15"

Cultivated

+56 Top Woods

S.L. 13'

Woods

drive

Woods 27' out

S.L. 14'

3/8/76

+50 T.P. 22'

+37 Tree 21'

F.L. 34'

Cultivated

+12 T.P. 24

S.L. 11' +01 Tree 21' F.L. 34'

+73 Tree 21'

F.L. 33'

+65 T.P. 33'

F.L. 32'

+29 T.P. 31.1

Tree 22' F.L. 32'

Cultivated

+18 Tree 21' F.L. 32'

+89 T.P. 32'

+64 Tree 24'

S.L. 13' F.L. 32'

166+00

165+00

164+00

163+00

162+00

161+00

160+00

3/8/76

+69 T.P. 19

FL. 21

FL. 23

FL. 34

FL. 25

+37 B. of FL. 36

S.L. 12

Cultivated

Cultivated

+31 T.P. 18

+45 F. of FL. 22

FL. 30
+97 T.P. 19

FL. 31

+57 T.P. 20

FL. 29

Cultivated

Cultivated

+10 T.P. 21
S.L. 12. FL. 31

FL. 33

173+00

172+00

171+00

170+00

169+00

168+00

167+00

3/8/76

+55 T.P. 28'
+71 T.P. 28'

+52 F.L. 33'
+40 T.P. 20'

F.L. 24'

POSTUM

+65 FENCE 22'

F.L. 21'

12"X16" C.M.P. +50 1/2 F.E. +72

F.L. 22'

+16 T.P. 20'

+74 T.P. 20'

F.L. 21'

+38 T.P. 20'

F.L. 20'

+04 T.P. 20'

F.L. 21'

Cultivated

Cultivated

P.h. 19'

+51 1/2

+22 F. drive
12"X15" C.M.P. (BQ)

180+00

179+00

178+00

177+00

176+00

175+00

174+00

3/8/76

+62 B. T.P. 29'
+61 T.P. 20'

+17 + Fence 23/
FL 3/SL 14

FL. 24' SL. 11'


FL. 29'

+27 T.P. 19'

FL. 21'

12" X 16" C.M.R

+88 F.E

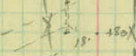

+65 FL. 24'

Trees

+36 T.P. 23'

FL. 26'

FL. 19'

Trees

FL. 34'

+55 T.P. 20'

and

FL. 23'

30'

48" X 12" C.M.

+66 L. drain 8'

FL. 28'

+15 T.P. 20'
FL. 24'

FL. 25' S.L. 14'

+94 T.P. 24'

pasture

+67 T.P. 19
+57 T.P. 29
+49 " 29
+37 T.P. 29

FL. 29' SL. 14'

FL. 24' S.L. 13'

+75 T.P. 21'

Cultivated Swamp

FL. 23'

187+00

186+00

185+00

184+00

183+00

182+00

181+00

3/4/26

+90 S. drive
30' x 18' +80 S. drive 22
+75 E. Cor. 17

FL. 28

FL. 16'
+90 T.P. 16'

+71 T.P. 28'

FL. 30' S.L. 12'

FL. 16' S.L. 11'

+63 T.P. 31
Hd. Wall +24.20' Cul.V. 44' long
+20 Cor Fence 31
+13 A. in Pav 24' +15 Edge of Pav
+73 A. in Pav 24'
+91 Edge Conc. 11'
+94 Co. Rd. Sign 31 12" Wing Wall
+75 Co. Rd. FL. 34' +--x--x--

+16 T.P. 16
+52.4 M. 15.6
+25 T.P. 68
+31 Rd. Sign 32'
+25 Cor Fence 44'
+23 Hd. Wall. 18

36" CM. 23'-44'
+72 Cor FL. 32'

FL. 30'

FL. 32'
+97 T.P. 18'

S.L. 15' FL. 29'

FL. 29' S.L. 12'

FL. 29'

+32 T.P. 20'

FL. 29'

P.P. 30' +09-20"x35" C.M. P

18 17

FL. 32'

Pasture

Paddy land

194+00

193+00

192+00

191+00

190+00

189+00

188+00

3/10/76

+55 T.P. 24'

+24 T.P.P. 23'

FL. 24'

+14 T.P. 24'
FL. 25'

FL. 24'

+53 T.P. 24'

FL. 26'

+09 T.P. 24'
FL. 25' - SL 12'

FL. 25'

+30 T.P. 27'

FL. 21

Pasture

Pasture

FL. 19'

+92 T.P. 22'

+74 T.P. 19'

FL. 19'

+31 T.P. 18'

FL. 18'

Cultivated

FL. 18'

+91 T.P. 18'

Pasture and Farmland

FL. 18' B.L. 12'

+60 T.P. 17'

+56 FL. 32'

FL. 32'

+24 T.P. 17'

FL. 32

201+00

200+00

199+00

198+00

197+00

196+00

195+00

3/10/76

+73 T.P. 21

+30 M. D.V. 11
+22 Tree 25
1108 D.V. 10
207 T.P. 21
F.L. 21

12'x16' C.M.P.
15' 2'

Cultivated

Pasture

Pasture

+88 T.P. 25

+67 T.P. 25

+12 Tree 23

+37 T.P. 21

F.L. 20

+27 T.P. 26
+17 T.P. 21

+05 T.P. 20
F.L. 20

+89 Tree 22

+74 Tree 22
+31 F. Cor 27
+31 Tree 22

F.L. 23

F.L. 20

+68 T.P. 23

+71 T.P. 20

F.L. 25

F.L. 19

+23 T.P. 23

+38 T.P. 19

D.V. 24

F.L. 19

+55 -12'x41.5CM

12'x5' 163

Fl. 24 S. 14

+09 T.P. 19
F.L. 19

Cultivated

Pasture

708+00

707+00

706+00

705+00

704+00

703+00

702+00

3/10/76

+49 T.P. 25'

+21-12" X 41" C.M.P

21 20

+06 T.P. 32'
+50 T.P. 23'
+66 T.P. 30'
+27 T.P. 30'

Cultivated

Cultivated

+11 T.P. 24'

+86 T.P. 31'

+47 T.P. 33'
+32 T.P. 23'
+26 T.P. 29'

+67 T.P. 29'

+77 T.P. 23'

+89 T.P. 23'

+42 T.P. 22'

+46 T.P. 23'

20' 21'

+62-24" X 41" C.M.P

+88 T.P. 26'

Cultivated

Cultivated

+08 T.P. 22'

+08 T.P. 23'

215+00

214+00

213+00

212+00

211+00

210+00

209+00

+60 Tree 35'

+63 T.P. 23'

+41 Tree 35'

+61 T.P. 24'

+62 T.P. 24'

+64 Tree 29'

+25 Tree 29'

F.L. 25'

+45 Tree 28'

F.L. 28'

+64 Tree 28'

F.L. 27

+86 Tree 27

+68 Tree - Fern. 27

gravel town Rd +44.9

+86 T.P. 25'

+59 T.P. 25'
+46 Tree 34'

Cultivated

+17 T.P. 23'

+82 T.P. 25'

Cultivated

B. ii

722+00

721+00

720+00

719+00

718+00

717+00

716+00

3/10/76

+16 T.P. 33'
FL. 32'

+60 Tree 33'

+19 Tree 33'
+19 Fen. 33'

+78 + Tree 34
+73 T.P. 27'-20'

+60 Tree 33'

+27 T.P. 29'

+80 Tree 34'

+88 T.P. 23
+61 Tree 32'

+22 Tree 34'

+41 Tree 34'

+45 T.P. 23'

Cultivated

4' 2"

FL. 29'

FL. 29'

+41 Tree 29'

FL. 29'

FL. 29'

FL. 29'

+22 Tree 29'

FL. 29'
+58 Tree 29
+83 Tree 29

+43 Tree 29'

45.28'

Cultivated

229+00

228+00

227+00

226+00

225+00

224+00

223+00

20/10/16

+58 Tree 31'
+54 T.P. 60'
+28 T.P. 23'
+16 Tree 30
+16 E of 1 Fen 30
Fl. 29

Cultivated

+76 Tree 31'

FL. 29'

+83 T.P. 23'

+58 Tree 31'

FL 30'

+77 Tree 30

+39 T.P. 23
+37 Tree 30

FL 30

+58 Tree 30

+19 Tree 31'
FL 30

+97 T.P. 22'

+79 Tree 31

Fl 32'

Cultivated

+53 T.P. 23

+19 Tree 31

Fl 32'

+68 Top Sign 12'
+59 Tree 33

+17 Tree 33'

Cultivated

+79 Tree 32'

+40 Tree 33'

+98 Tree 32'

+57 Tree 32'

+19 Tree 32'

+79 Tree 32

+40 Tree 32'

+99 Tree 31

+20 Tree 32'

B 16'

+41 Tree 31

Cultivated

Tree 31

+32 E of fen 29

Fl 29

236+00

235+00

234+00

233+00

232+00

231+00

230+00

20/10/76

+68 T.P. 27'

FL. 33'

+17 T.P. 26'
FL. 31'

+55 Fert. Entry

FL. 32'

+71 T.P. 25'

FL. 32'

+18 T.P. 24'
P.V. 33'

FL. 33'
+96 Slope Sign 12'

+60 T.P. 22'

+98 Co. Rd sign 78
+98 P. Cor 201

Cultivated

yard and trees and Pasture

Cultivated

Cultivated

11' 13"

+74 . 26

+05 . 23.2

+94
+95
+16 P.P. 39'
Tree 32

243

242

241

240

239 rod

238 rod

237 rod


13

30

231 800 Small Oaks.

cultivated

~~101 = 1.026~~

+84 Dec 25'

247-T.P.27¹

cultivated.

Small/Ones.

+23-20" Pop 2V

+06-T.P. 27'

+21-8" W.O. 26'
+10-6" TW O.K. 29'

+ 98. Fen. Cor 23

Cult. voted

42. 23

211

250

249

248

247

246

245

244

257

256

255

254

253

252

251

264

263

262

261

260

259

258

142-F. Inc-23'
+32-T.P. 24'

* * * *

Small Oaks

Trees 27

+94-T.P. 27'
+94-T.P. 21'

Small Oaks

+32-21'

+89-T.P. 23'

Cultivated.

cultivated.

+89-B. Oak 30'

+30-T.P. 22'

12'
11'

+01-T.P. 22'

+8

+01-F. ENT
12" X 15' C.M. P

Farther
yaled.

24' 26'

12' X 12' X 14'
+55 Wood Box
Cul

+8 F. (2) M. BK 13

+5-E. Oak

271

270

269

268

267

266

265

F-31

+36-T.P. 24'

+90-B.F. 75'

+70-T.P. 24'

+35-T.P. 24'
+23-F.E. 1'

+06-T.P. 21'

+68-T.P. 23'

Farm yard.

12' x 35.6 C.M.P.

x
x
x
x
x
x

21'

15'
15' +21'

+15-⊕ Sign. 12'

+90-⊕ 12'
Sign.

+39-M. B. X 10'

+30-6" oak X 6"

278

277

276

275

274

15. 17.7 - North Trk.
15. Lt. 17.5-Rt South Trk.
Full Planked

273

272

F-35
+99-10" oak 30'

 $+29-T, R-13'$

F-34

+64-F. Cor. 35

408-T. R. 24


 $+80 - \text{sign} 15$

F-32,

+75-T.P.W

$$F = 34$$

431-T.P.24

+09-R.R.Xing 13

188 E. F. 32'

12, 14, 15

+ 49 - Aut. Sig. 14

+ 96-R. 9. 1. 1. line 1. 1. 1.

$$+22-F, \text{ cos. } 27$$

410 - T. Cor. 38
410 - T. Cor. 38

419-110

12" x 16" C.M.

497-M. 18x13
+84-L.F. Ent
+71-F Line 29

12" x 16" C.M.

+96-Font
+81-NBX-24

cultivated.

131

449-FCor.39'

f23 P₂ sec. Post 31

15" x 36 C.M.P.
+ 0.96

C. 5th

+42 { 24" x 39.5 C.M.P
+57 ft

+JF F. Con 70

Small Trees

285

284

283

282

281

280

279

F-33'

+45-T.P. 23'

+24 F.C. 23'

+85-T.P. 22'

F-30'

+22-T.P. 23'

F-28'

+25-T.P. 23'

F-31'

+75-T.P. 23'

16'
10'

17.5/12.5

+34-36" X 30" ~~W.P.~~ C.M.P.
Hd. Wall on R4-6" X 1"
Hd. Wall on Lt. Tippleover

23'

+29-24" X 37.5 V.R

Klanish
Pasture

Meadow

15'
12'

292

291

+ 899 Mont. & Co. Road "A"

290

289

288

287

286

F-40

+37 E.D. 28'
+26 E.C. 50'
+10 In. Rd. 9.33'

15" X 40" C.M.P.

+63 E.C. 40'
+61 T.R. 52'

+34 T.P. 37'

40 yds

Cult.

+84 Reflec Sign 27'

+62 E.P. 25'

17'
12'

+37'

+86 T.R. 25'

Meadow

Pasture

+01 T.P. 25'

299

298

297

296

295

294

293

F-24'

F-21'

F-29'

120-12" X 48" V.P.

F-25'

F-29'

F-22'

F-25'

F-40'

F-34'

cultivated

Pasture.

445-400020'

N
=

Cult.

306

305

304

303

302

301

300

F-45

ω
ω
ω
ω

x ω
x ω
x ω
x ω

F-26

F-43

F-27

F-37

Timber
oaks

41

Timber
oaks

F-29

+47 - Northrup 20
+18 - F cor. 42

+18 Δ F-48
+06 Δ F-34

small
oaks
432

F-31

F-34

F-32

F-43

F-33

313

312

311

310

309

308

307

+79-12"x40.5' C.M.P.

17'

Pot Hole

F-24'

+85-End Timber

F-24'

F-23'

+63-E. Small Tree 54'

16'

F-23'

+63-B. Small Tree 71'

+53-F. Ent.

+43-F. Cor. 26'

F-24'

F-25'

+60-F. Cor. 30'

Pot Hole

Oaks

F-27'

+90

320

319

318

+86.25-Mont.

317

316

315

314

+126-T.P. 21'

-F-32'

cultivated.

+198-T.P. 27

F-30'

cultivated

+122-4" Tree 23
-18-F.Cor. 27

+135-T.P. 29
2.3 Sept. 1941

+176-4" Tree 20.
+61-B.F. 30
12" x 16" C.M.P.
+54-L.F. Ent.
+45-E.F. 33

F-33'

Scattered
oaks

60
100

timber
+123-F.Cor. 28
F-30

60
100

Marsh

61
101

F-22'

327

326

325

324

323

322

321

F-26
+73-T.P. 24

F-25

14" oak

+49-T.P. 23

+15-F. com.

F-29

+13-F. com. 28

+20-T.P. 22

+75-M.B. 14

+60-F. Ent

+49-E.F. 24

+93-F. com. 25

+8-M.B. 15

+79-F. Ent

+97-T.P. 23

+68-T.P. 28

+50-T.P. 27

F-32

F-29

F-31

+8-B. Row Oak 28

F-24

F-24

F-21

+94-12" Pop 24

F-31

Yard

Orchard

Yard

6"-14" Oaks

Cultivated

{ 12" x 12" x 25'
Cob. Stone
Cult.

12" x 18.5' C.M.P.

334

333

332

331

330

329

328

+73-12" Oaks

+46-F. Ent.
12" x 16.5' C.M.P.

+99-T.P. 24' - front.
+P.D.

12" x 6.5' V.P.
+19 & steps 4' wide.

+68-T.P. 25'

+11-F. Ent.
+102-M.B. x 15'

+35-T.P. 25'

+54-M.B. x 14'
+40-F. Ent.
+32-F. C. 173
+13-T.P. 20'
F. 22'

+25-10" Oaks

F-21'

+99-T.P. 19'

+16-12" x 20.5' C.M.P.

Yard.

Yard.

12" x 11' V.P.

12" x 6.5' C.M.P.

10" Oak
Pasture

+31-14'
+73-16.5'
+19-130'

+15-15'

28

+104

+34





















+85-Ent Oaks
12" x 16.5' C.M.P.

6"-10" Oaks

cultivate

+69-B. Trees 21'
+47-A. Cor. 38
+38-A. F. 32'

+99-F. Oaks

F-34'

6-10" Oaks

341

340

339

338

337

336

335

+17-T.P. 3 P.P. 24

+39-15" x 44.5" C.M.P.

+51-T.P. 3 P.P. 25

+19-T.P. 4 P.P. 25

+91-T.P. 6 P.P. 25

+06-F.L. 25

+61-T.P. 25

+34-T.P. 25

24.5 20

14 14

+17-End

8-15" O.K.S

+46-200

vertical

vertical

F-29

F-29

F-29

+19-10" O.K.S
F-27

F-25

+47-F.C. 25
+41-E.T. ENT
15" x 16" C.M.P.

348

347

346

345

25' 16'

344

464 L^o Mont. E Co. Road B & Road in Wash. Co.

343

342

15"X16" C.M.P.

+00 Drive 15' +93

347

+16 R.P. 37' ✓

+27 T.P. 27' ✓

348

+99-6" @ 20'

+59-12" @ 21'

+53-13" @ 29'

Gravel

+00 f. Road

+77 R.P. 35' ✓

+70-12" @ 31'

12"X32" C.M.P. 17' +77

+45-4" @ 21'

+11-6" @ 24'

+92-12" @ 25'

+83-4" @ 32'

+54 Fc. Cor. 33'

+49 Fc. 27'

12"X16" C.M.P.

+60 Drive 16' +55

Cultivated

346

+01-8" @ 31'

+06 x x 25' ✓

+87-6" @ 29'

+12-12" @ 25'

+63 R.P. 31' ✓

+47-8" @ 29'

+34-12" @ 24'

+15-4" @ 25'

+05-4" @ 25'

+79 16.5

+67 f. Drive

+96 T.P. 26' ✓

12"X16.5" C.M.P.

345

+89 Rd. sign 17'

+72-T.P. RR. m ✓

+03-8" Oak 17'

+90-14" Oak 18'

+82-F. Ent.

+57-14" Oak 16'

12"X16.5" C.M.P. 16' +74

Yard

+60 20.00

6-8" Oak

Cult

+64(A)-M.B. 41'

18"X23.5" C.M.P.

+43-T.P. + F. Cor. 15'

+31-A.P. 32'

F-33

+35-B. Oak 32'

344

355

14

22

354

353

352

351

17'

350

17'

23'

349

+50-8" @ 23'

+25-12" @ 28'

Cultivated

+90 T.P. 24 ✓ 356

+54-15" @ 27'

6" Trees

+81-16" @ 29'

12" x 31" C.M.P.

+57 R. HIVE

Cultivated

+24 T.P. 24 ✓

353

+91-12" @ 27'

Undeveloped land

+58 T.P. 25 ✓

352

Cultivated

351



Orchard

+90 T.P. 25 ✓

350

+13-10" @ 29'

+10-12" @ 25'

349

362

361

360

16

22

359

358

357

356

+79-12" @ 27'

Good

Cultivated

+48 T.P. 21' ✓

+202 Road

+20 Rd.

+96 F.C. Can 26'

+83-8" @ 23'

+77-6" @ 23'

+43-8" @ 24'

+39-6" @ 25'

+35-6" @ 22'

+34-6" @ 25'

+87-3" @ 25'

+52 T.P. 21' ✓

+75-12" @ 22'

+72-8" @ 22'

+36-4" @ 23'

+36-6" @ 21'

+94-12" x 42.5' C.M.P.

+64-8" @ 18'

+46-8" @ 23'

+00 F.C. Can 25'

+88 F.E.

+07-12" @ 20'

Partial

Cultivated

+21 T.P. 22'

+87-10" @ 18'

+88 F.E.

+57 T.P. 22'

369

17' 26'

368

367

366

365

17' 24'

364

363

15" x 40.6' C.M.P.

15' + 87

12" x 32' C.M.P.

370

+53-12" @ 29'

+16-8" @ 31'

369

+52 R.P. 29' 1/2
+42 1/2 M/C
12" x 12' C.M.P.

+54-R.P. 46
Power Tel. line
ring

368

plotted
plotted

+08 Rd. Sign 25'

367

8th Ave. N.H. +75 1/2 St

+75 1/2 St

12" x 32' C.M.P.

+55 (2) M. Box 25'

+55 End Hedge 25'

+16-12" @ 27'

Hedge 25' 366

+75-10" @ 27'

+70 T.P. 19 ✓

+18 1/2 Alley

+30 Beg Hedge 25'

+18 1/2 Alley

365

+90-12" @ 27'

+67 T.P. 18 ✓

+49-8" @ 25'

+35-10" @ 24'

+07-9" @ 27'

+96 1/2 @ 24'

+90-12" @ 25'

364

plotted prop.
plotted property

+47 1/2 St

+47 1/2 Tr 2

+14 T.P. 20 ✓

363

376

375

18

26

374

373

372

371

370

377

376

375

373

372

371

370

+61 T.P. 38' 64

+63 1/2 Alley 9' X 55' C.M.P.
+72 T.P. 38

+61 1/2 Drive

+55 1/2 Steps (2' X 6' C.M.P.)

+89-20" @ 29'

+85-15" @ 29' 1/2 Drive 12' X 16' C.M.P.

+45-12" X 49' C.M.P.

+10 (-) 6" @ 23 371

+79-12" @ 28'
+66 M.B. 27' +66 Rd Sign 3112' X 46' C.M.P.
10" Drive 235 1/2 St.
+20 Power line Xing
+07 Hedge & Car 27.5

+20 R.P. 12' R1

+90 No Dump
Sign 9.5

+59-6" @ 23'

+36-12" @ 23'

+29 Beg. Hedge 29.5

+99-12" @ 29'

12' X 40.5 C.M.P.

+64 (-) 6" @ 29'

+53-8" @ 29'

+52-6" @ 26'

+47-8" @ 24'

+42-6" @ 25'

+86 1/2 Drive
+72 1/2 Alley

plotted

plotted

+87-15" @ 33

+43 20" @ 34'

+40 Hdg. 24.5

+36 Rd Sign 31

+06-12" @ 26' 371

+73 12" @ 32

+35 R.D. 16

+08.55 1/2 St

+08.55 1/2 St

+59-6" @ 23'

{+62 1/2 Work
6" X 6' V.P.

17

22

382

+95-12" @ 18

122 & Rd

25'

+79

+80 Drive

5" x 20' V.P.

+58 T.P. 25

383

+07 Fc. Cor. 26

+55 & Drive

+67 T.P. 25

382

381

+85-6" @ 81

+73-12" @ 30

+61-12" @ 30

+50-12" @ 30

+38-8" @ 31

+29-8" @ 31

+24 Rd. 5.90 24'

+65 M. @ 21

15.3wde

+50 Drive

12th Ave. N.E

+00 & 51

380

+35 & Rd

+18 Rd. 5.90 16'

+11 Refl. 19' R1

+07 End. Pav.

379

To No. 51 P.

49

378

+79 T.P. 4.90 Xing +65 Drive

+66 15" @ 27

+57 T.P. 27

+06 & 51 P

377

18

26

18

26

391

390

389

388

387

386

385

384

+51-10" X 36" V.P.
+44 M.B. 15' 61

+32 curve

+92 F. Cor. 34.0

+31 End. E. 30.3

+17 End. E. 42.4

+59 R.R. Xing. P. 70'

+61 P.P. 31' Rt

+97 F. Cor. 38' 61

32.5'

+99 E. Cor. 37.5

+47 P.P. 34' Rt

+21 1/2 Drive

27'

+22 (2) M. Boxes 15'

+15 R.R. Xing. P. 15'

+02 T.P. 22'

22'

+66 1/2 Drive
+55

12" X 24" { C.M.P.
V.P.

X+55

X

X

X

X

X

X

X

X

X

X

X

Cultivated

Cultivated

+54 T.P. 23'

+38-12" X 38.5' V.P.

23.5-45'

+09 T.P. 24'

17' 26'

+71-14" X 43' V.P.

+86 16.4
15.6 +56

+80-6" @ 16'

+86 Rd. S. 1/4 15.5

+76 P.P. 25'

+66 Rd. S. 1/4 19'

+58-15" @ 24'

+17-15" @ 32'

+12-(2)-8" @ 27'

+88-8" @ 22'

+81-6" @ 23'

+76-6" @ 25'

+70-15" @ 24'

+53-12" @ 22'

+41-8" @ 25'

+37-8" @ 28'

+25-12" @ 20'

+40 & Co. Rd. "C"

+09-12" X 35' (C.M. + V.P.)

16 19'

+07 & Enire

+88 N.B. 14' 41'

+10-15" @ 29'

+91 RR. 1/4 14'

+49-12" @ 29'

+25-12" @ 30'

Platted bond

Platted bond

+95-6" @ 17'

+73-6" @ 17'

+49-6" @ 19'

+29-4" @ 20'

+92 P.P. 19'

+80 P.P. 1/4 19'

+12 P.P. 39' R1

+72 P.P. 19' R1

+52-10" @ 32'

+47-12" @ 33'

+33-12" @ 33'

+24 P.P. 70' R1

+12-12" @ 34'

+09-6" @ 34'

+03 10" @ 34'

+94-10" @ 32'

+85-12" @ 32'

+72-8" @ 29' R1

+43-12" @ 28' R1

+93 P.P. 19' R1

+34-12" @ 28'

+26-12" @ 30'

+04-18" @ 29'

+92-15" @ 30'

+23 P.P. 20'

16' 24'

405

21

pasture

+70 R.R. 12' R1

404

+06-12" @ 34'

+06 R.R. 11.5'

+88-15" @ 28'

+57 Fe. Cor. 18'

12" X 51' V.P.

+69 1/2 Rd

+69 Rd Blind End

+35-24" @ 34'

+36 R.R. Danger Sign 14'

30'

12'

+51 R.P. 17' R1

403

26'

+97-12" @ 20'

+85 R.R. 12' R1

+70-12" @ 22'

+08 R.R. Xing Sign 12'

+31 1/2 Driv'e

+41 Fe. Cor. 19'

+14 M.B. 14'

+03-12" @ 22'

402

24 1/2'

+77-12" @ 21'

+71 Bep. Hedge 25.5'

+56 R.P. 13.5'

401

+64-(3) 8" @ 25'

+57-15" @ 36'

+42-6" @ 25'

+37 R.R. 15'

+32-12" @ 26'

+26 R.R. 20' R1

+20 R.R. Xing. Sign 14'

+15'

+93 R.R. hinc Xing

400

18" X 90' (C.M. + V.P.)

+83 R.R. 20' +87-15" @ 36'

+77 1/2 Box 12.5' +77 R.R. 13'

+73 R.R. Xing Sign 12.5 R1

+45-20" @ 29'

+36-8" @ 27'

+32-8" @ 30'

+16-2 (12" @) 30'

+14-6" @ 30'

+11-2 (6" @) 30'

399

+15-3 (10" @) 26'

+25'

+93-15" @ 24'

+83-12" +15" @ 31'

+75-15" @ 31'

+49-12" @ 25' 1/2

+33 P.P. 25.5'

+30-(2) 1" @ 38'

+18'

+2 1/2 R.R. Driv'e

+36 R.R. 16'

10" X 16' C.M. P.

+11 M.B. 14'

+03 R.R. Xing. R1 398

22

31



17

28

412

+71 & Drive

+34-15" @ 33'

+20 Fc. Cor. 34'

+96 End. Fc. 35'

+64 M. Box 15'

+44-12" @ 25'

+42 End. Ret. Wall. 23'

12" x 28" C.M.P.

+14 M.B. 17'

+96 P.P. 17.5 ft

411

+106 & Drive

PROP

+38 Fc. Cor. 26'

+07 Caution Sign 19' 410

+176 Fc. Cor. 34.5'

Culv. Covered up.

+77 P.P. 16'

+19 (2) 6" @ 30'

+19

+20 & Drive

+25 M.B. 17'

409

+70-30" @ 34'

+47-30" @ 34'

+54 P.P. 15'

408

+71 P.P. 19'

+72 Fc. Cor. 34'

12" x 40" V.P.

+44 & St

+56 P.P. 13'

407

+33-18" @ 26'

+14-18" @ 26'

+99-15" @ 23'

+82 (6) 8" @ 26'

+09 P.P. 13.5

406

405

Post/Vine

Pasture

Rd. 67 $\frac{1}{2}$ Rd. 17.

Gravel Shoulder
Surface Width

+50

5.0

4.7

5.0

+50

8.0

10.0

+50

9.0

8.0

4.5+00

20

32

+86-10" @ 20

+41-9" 8" @ 21
+34-12" @ 23
+17-6" @ 26
+14-5" @ 29

+97 T.P. 21.5

+22 End. Fe. 46.5

+02 1/2 Drive

+50 Bag. Fe. 38

+19 Fe. Con. 34

+3 1/2 Drive

+53 1/2 Drive

+63 1/2 Drive


49

+50 Fe. Con. 43

Orchard

Orchard

Cultivated

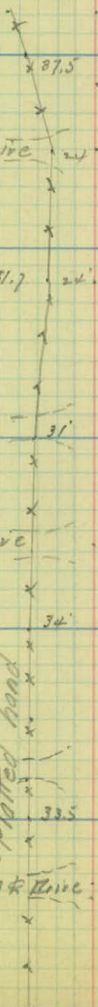

+94 Drive 12"X16' C.M.P.
+86
+74 T.P. 30

+81 T.P. 33.5

+46 P.P. 26

+16 P.P. 23

+23 T.P. 19

418

417

416

415

414

413

412

Rd. 41. Rd. 71

+50

00

425+00

24

32

00

00

00

423+00

00

+50

3.0

422+00

2.0

+50

3.0

3.0

3.0

24

38

1.0

+66

00

+50

0062

3.0

426

+81 T.P. 63'

+31-12" @ 18'

+14-12" @ 37'

+09-15" @ 20'

+92-15" @ 23'

+57(2) 8" @ 32'

+45-T.P. 73'

+04-12" @ 29'

+68-16" @ 46'

+32 T.P. 70' Ht.

+33-20" @ 43'

+13-3" @ 30'

+05-3" @ 20'

+81-12" @ 23'

+76-6" @ 28'

+75-8" @ 20'

+14 T.P. 58'

+86-8" @ 23'

+77-10" @ 22'

+34 T.P. 35'

+99(2)-8" @ 21'

+89-3" @ 16" @ 19'

+62 T.P. 54'

+44-30" @ 18'

+71-12" @ 20'

+66-15" @ 20'

+36-4" @ 26'

+10-(2) 11" @ 50'

+02-15" @ 30'

+05 T.P. 61'

27'

27'

25'

22'

28'

28'

31'

34'

34'

37'

39'

Pasture

+51 1/2 Drive

+60 Drive

+21 Drive

Silver Lake

Pasture hand

425

424

423

+33 Lake Sign 20.5

422

421

420

419

20	28	00
----	----	----

2.8

30	45	5.0
----	----	-----

35	52	10
----	----	----

38	53	4.0
----	----	-----

32	45	8.0
----	----	-----

30		3.0
----	--	-----

433

181 T.P. 29' 4"

34

344

432

455 T.P. 27' 47

54

3.5

431

+25-T.P.29'

34.

24.

430

+ 95 Fc. 30

+78 FC.28

445. M.B. 15.

431 T.P. 25

Timber band.

Catharted

429

 $+70 - 17^{\circ} \text{ @ } 22'$

465-18" @ 19

+ 375 Sharp Turn Sign. 14'

+29 T.P. 28.

22

26'

428

456 T.P. 31

34

55

+17 Ref/Hor. 18.4)

Dodge Bros }

4905, P. 29. Hb.

37

43

427

+67 Beg. Ec. 11

5

4.

454 T. P. 32

39.

426

32

20' 30

420

33

+21 T.P. 29' 6"

X

X

X

32'

439

+82-12" X 45' V.P.

X

23' 22'

E. End, Calv. Covered

X

X

32'

+93 T.P. 29

X

X

X

32'

+104 F.E.

438

Cultivated

Cultivated band

+65 T.P. 29

X

X

X

33

+65 P.G. Cor. 34'

436

+34 T.P. 29

X

X

X

X

X

X

X

34

+11 F.C. Cor. 32'

+97-12" @ 23'

+65 R Drive

32'

18'

+92

+67-(2)-12" @ 18'

+52 F.C. Cor. 34

6 6 6 6 6 6

Cultivated band

+91 R Drive
8" x 17.5 V.P.

435

+07-T.P. 29

X

X

X

X

34

Timber band.

434

433

22

34

21

32

447

446

445

444

443

442

441

440

+66 T.P. 29'

+45 T.P. 27'

+28 Power line Xing.

+27 T.P. 28'

+03 T.P. 28'

+29 T.P. 29'

+51 T.P. 28'



4-wires

27' 26'

+39-10" x 53' V.P.

Cultivated land.

Cultivated land.

18' 28

29'

454

28'

453

Cultivated land

Cultivated land

33

452

+97R Drive

+75-10" @ 31

+51-8" @ 31

+27 M.B. 23'

451

+58 R Rd. 11

{ +80 R.R. 39
X-line

+33 Rd. Sign 29
+32 F.C. 30
+32 Rd. Sign 28'

{ +35 T.P. 42
X-line

450

31

+73 T.P. 27'

449

+95 T.P. 29'

32

448

33

+82 T.P. 28'

Cultivated

Cultivated

447

Gravel Shoulder
Surface Width.

22 31

22 30

Timber land.

Cultivated land.

+38 Fe. line 29

+86 - 8" x 5 1/4' V. P.

Cultivated

Cultivated land



460

459

458

457

456

455

454

21' 33'

37 38

468

X X
X X
X X

Cult. land

36 30

467

Timber land

+69 F. line 36
+58-12" @ 30'

+77(5) 12" @ 28'

32'

466

36' 36'

465

Pasture land

39'

464

+93 F. Cor. 34

35'

463

+95-10" @ R.

+36-16" @ 30'

Timber land

Cultivated land

37'

462

461

22'

30'

+77-12" V.P. 54.5'

Timber land

PASTURE

ORCHARD

Chicken
Yard

+18 1/2 Drive

+85 M.B. 15

Frame
Shed
Concrete
Foundation

Timber land

Cultivated land

+50-10" x 38" V.P.

22 32

22 32

+66 1/2 Drive

18" @ 30'

242 1/2 in. Rod + 90 Fe. Cor. 32
+ 64 1/2 Drive

+65 (2) Mail, B. 15'

+54 1/2 @ 33

12" @ 27'

30' @ 29'

4" @ 26'

15" @ 29'

4" @ 33'

24" @ 29'

10" @ 29'

12" @ 28'

30" @ 28'

16" @ 29'

Form Yard

+57 (2) 16" @ 29'

40' 30'

14" @ 29'

+86 - 12" x 70' V.P.

18" @ 27'

Cultivated land

Cultivated land

+59 Fe. Cor. 33

Timber land

35'

26'

+91 Fe. Cor. 27

475

24.

32

Cultivated land.

Meadow
land.

32' 100 Fe. Cor. 32 488

+10-2x2 Post 31'
+05-2x2 Post 46.5
+00-2x2 Post 50.5 467
+96 Fe. 57.5
+82 Fe. 40.5
+69 Fe. 33.5
+53-2x2 Post 31

32' 486

33' 485

33' 484

Cultivated land

late View Cemetery
No. 5th. Pacl.

32.5

+73-2x2 Post 31.5
+58-2x2 Post 47
+51 Drive
+44-2x2 Post 46
+23-2x2 Post 52

22

31

Pasture

Cultivated
land

Cultivated land

+32 Fc. Cor. 36

12" X 16" C.M.P

+37 1/2 Drive

+36 E Drive

12" X 16" C.M.P

+20-10" @ 26'

+44-10" X L' C.M.P

+44-17"

Farm yard

- +83-8" @ 25
- +61-12" @ 26
- +71-12" @ 24
- +44-6" @ 21
- +41-10" @ 24
- +41-14, 15, 14
- +37-8" @ 21
- +21-6" @ 24
- +11-8" @ 25
- +66-(2) 12" @ 29

ORCHARD

Cultivated land

Meadow
land

495


494

493

492

491

490

 

Gd. Rail 17.5

Par. 13.7

Par. 13.7

Gd. Rail 16.8 503

+84 Gd. Rail 14

+84 End. Par.

+90 Gd. Rail 13

+71 Ant. Stop-Sign 14.5

+52 Gd. Rail 13.5

+45 Beg. Gd. Rail 14.5

+50 Gd. Rail 13.5

+42 Beg. Gd. Rail 15

Cult. land

Cultivated land

+09 Fc. Cor. 36

502

Pasture land

x

x

x

x

x

x

x

x

x

x

x

x

x

x

x

x

x

x

x

x

x

x

36

36

35

35

35

35

+36 F.E.

+76-12" @ 26'

+53-16" @ 24'

+45-16" @ 24'

+14-16" @ 23'

501

500

499

498

497

+40-15' x 67' V.P

496

32

20

29'

22'

☐
Ctr. Sec. 25

☐
91°31'

☐ E. 1/4 Cor. Sec. 25

☐ 51.26' 3''0.
☐ N.E. Cor. Sec. 25