

OFFICE OF COUNTY ENGINEER
RAMSEY CO. MINN.

Road Map Survey

SILVER LAKE RD.

From W. County Line To Fairchild Ave.

Road Acc't. No. 100

Date Filed 3-27-28 File

3-27-28

3/20/28

C. W. S.
A. B.
W. A.
T. W.

Rd 90 100

Silver Lake Rd.

West Co. line

To

Fairchild Ave

Road Map

Drawn 3-27-28
C. W. S.

Sta Point Alt Δ Rt.

7+58⁴⁶ P.T.

6+47²⁵ P.I. 22°-34'

5+32²⁹ P.C.

0+00

Δ 22°-34'

D 10° 14'

T. 114⁴⁶

L. 225⁶²


R. 573⁶⁹

OFP

5420

5212

OFP

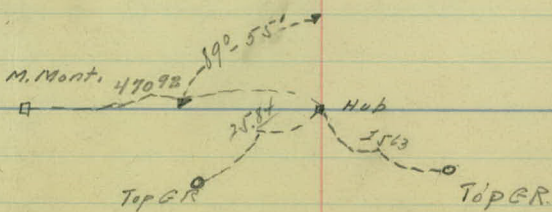

Sta Point ΔL ΔR

16+89⁸⁷

P.T.

✓

$\Delta 2^{\circ}26'$

D. 2°

T. 60⁸⁵

L. 121.67

16+29⁰⁵

P.I.

2⁰26'

R- 2864.93 ✓

15+68²⁰

P.C.

✓

13+65⁵⁴

P.T.

✓

$\Delta 18^{\circ}40'$

D. 12° Lt

T. 78.62 ✓

12+88⁶⁰

P.I.

18⁰40

L. 155.62 ✓

R- 478.24 ✓

12+09⁹⁸

P.C.

✓

0 C.R.

9260

2126

0 C.R.

4L+

4R+

24+87⁶⁹

21+58⁵¹ P.T. ✓

Δ 43°-26'

D249



T. 95⁷⁸ ✓


L. 180⁹⁷ ✓

20+72³² P.T.

43°-26' R-240.49 ✓

19+77⁵⁴ P.C. ✓

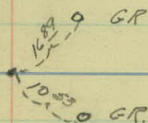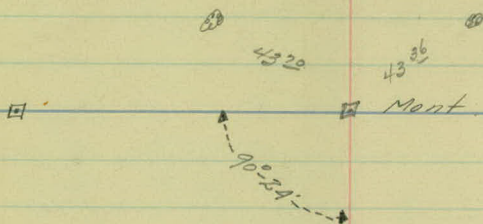

 

3/20/28
C. W. S.
A. B.
W. A.
T. W.

Silver Lake Rd

Rd 961000

From West Cokine

To

Fairchild Ave.

5+00

4+00

+28 R Drive Rt 15"x24" CM

+18 R Drive Lt 15"x20" CM

3+00

+12 L Drive Rt 15"x24" CM

+14 R Drive Lt 15"x24" CM

2+00

1+00

+00 R S. Drain 15"x36" CM 50 Rt.

+00 R S. Drain 15"x36" 20' Lt

0+00.

45035

F 33

F 38

Pasture

Cul

+28 F Cor 34'

+08 Beg Culv 23'

+08 R Fence 34'

16 Beg Culv 24'

+02 Beg Culv 21'

+00 Beg Culv 22'

Cul

Cul

4 3 Drain 15"x36" cm 24'

West Co. Line

+00 3 Drain 15"x36" cm 20'

11+00

10+00

9+00

8+00

7+00

6+00

Meadow.

Cut.

+59 F 35 at 30

F 33

F 33

F 33

F 33

+50 F 35

F 33

Pasture

Cut.

+55 X Drain

18X60 C.M.

RT30

LT30

1/2 X Drive Rt

15X44 C.M.

✓

17+00

16+00

15+00


14+00

13+00

12+00

✓ G.R. 13

✓ +58 Beg G.R. 13

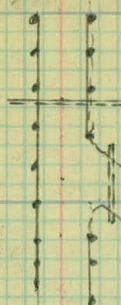

✓ +37 Beg G.R. 13

✓ +90 Beg Cul. 29

✓ +84 ECR 13

✓ +47 Beg G.R. 13

Plotted Prop Meadow

Plotted Prop Meadow

23+00

22+00

21+00

20+00

19+00

18+00

✓ +535 EGR 13'

✓ +73 TP 21'

✓ +50 GR 13'

✓ GR 14

✓ +50 GR 14'

✓ +13 Bog GR. 14'

Plotted Prop. Meadow

Plotted Prop Meadow

✓ +27 EGR 13'

✓ +21 EGR 13'

30x00

24x00

Fairchild Ave

