

Dr. 10

OFFICE OF COUNTY ENGINEER
RAMSEY CO. MINN.

Road Map Survey

COUNTY ROAD B

From White Bear Av. to E. Co. Line

Road Acc't. No. 15

Date Filed 1-30-26

File _____

ALIGNMENT

COUNTY ROAD B

FROM

WHITE BEAR AVE.

TO

EAST COUNTY LINE

4.15

STA Pt. ΔL ΔR .

472+34.45 Mon $0^{\circ}05'$

Computed stationing

470+83.4 P.O.T.

464+90.2 P.O.T.


MON

10,605.15

366+29.3 ↓

COUNT ROAD "B" #51.

HENNEPIN COUNTY

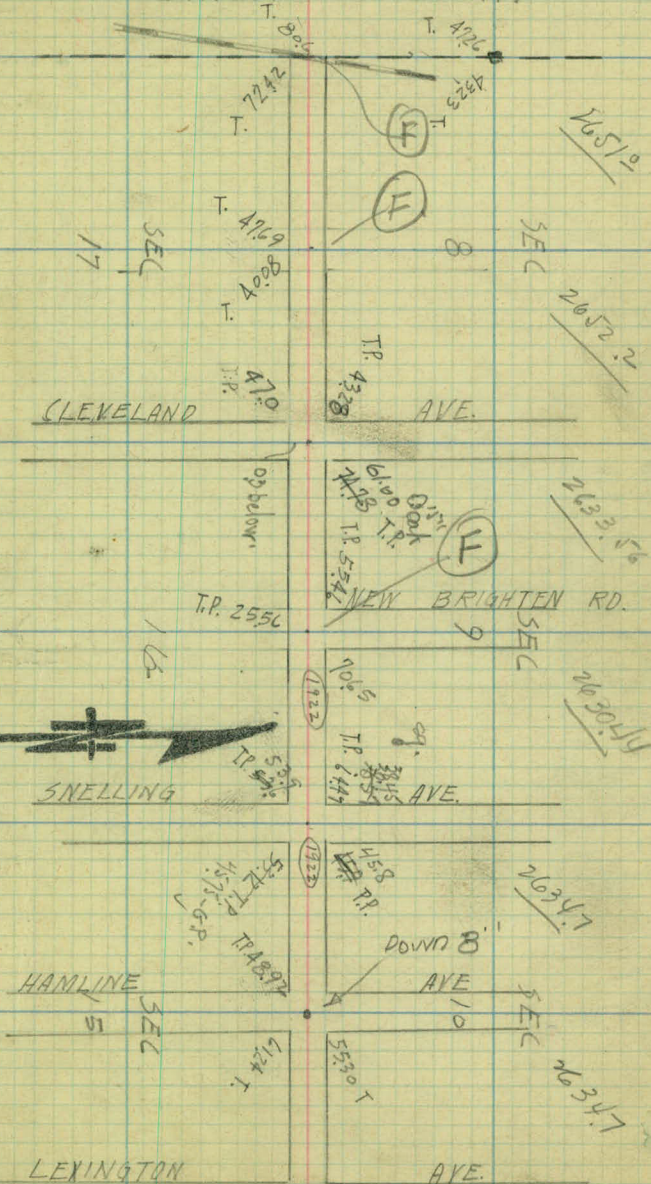

Tip
Sw. 28
1/24
6/11-7P,
• 7000

COUNTY ROAD "B" #51

LEXINGTON

AVE.

(F)

TP 3304

3727 TP

5285 TP

TP 435

2621.20

VICTORIA

ST.

SEC

4

4547

2618.9

DALE

ST.

8149-4508

TP 6478

5234
8149-4508
5234

4423 TP

4458

2611.4

SEC

13

2613.4

4978 TP

4016-PP

ST.

RICE



4300 TP

456 TP

chicken coop

TP 294

8334

TP 5212

2409.7


SEC

18

None

M S MENEMY

ST.

 

COUNTY ROAD "B"

2665, 16

WHITE BEAR AVE.

WHITE BEAR & LAKE PHALEN RD.

SEC 14

SEC 11

N ST. PAUL

NORTH ST. PAUL

SEC 12

SEC 13

47224 QUS
26113.6
472408 02

26096

26225

26102


TP 5373

4724 TP

WASHINGTON COUNTY



472 + 34.45

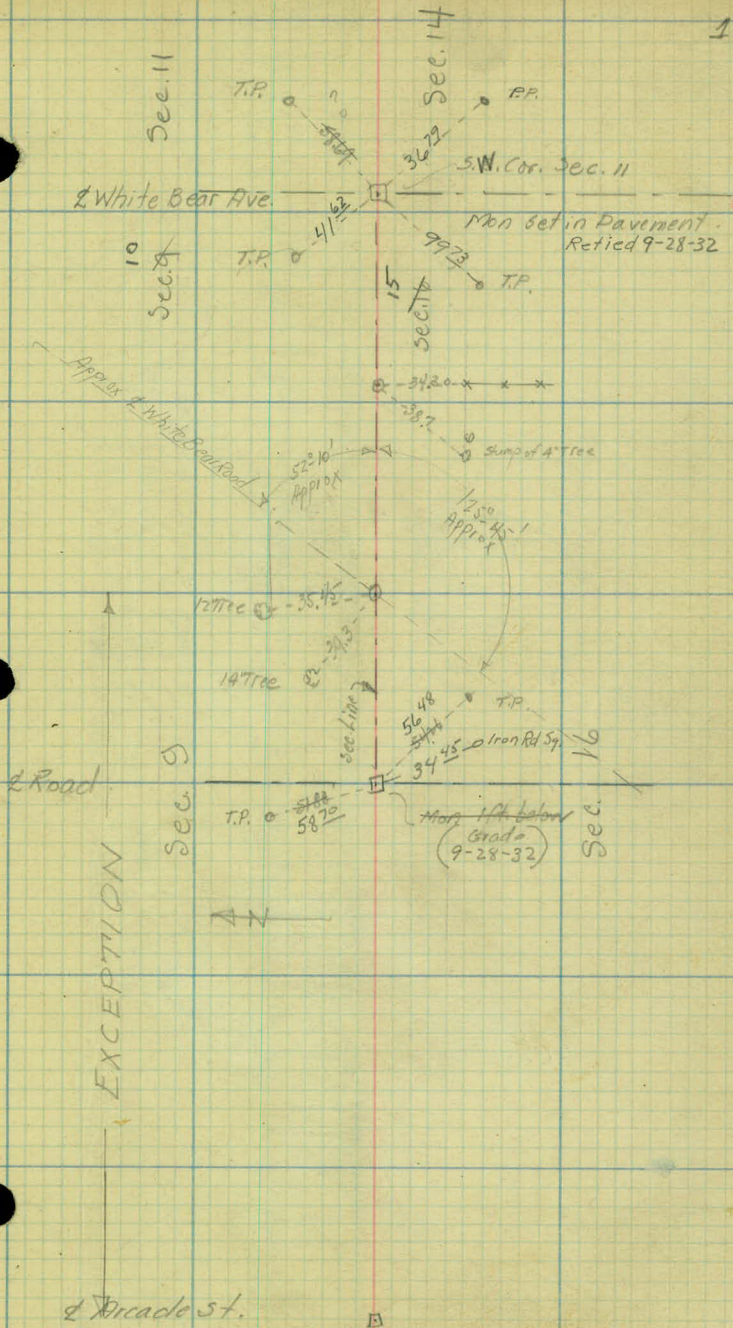

Station Point Lt. Δ Rt.

524+59.6 P.I.
Mont 0°37'

518+31.1 P.O.T.
Elec. R.R.
2610.50

515+46.7 P.O.T.
Line

498+44.1 Mont. 0°20'

2614.25

487+76.2 P.O.T.

T.P. 0 76.23
 Tree 0 11.4 113
 T.P. 0 55.68
 Iron Mont. (Grade 9-30-32)
 -384-321-

Dec. R.R.
 Dec. R.R.

6" Oak

T.P.

14-113

10" Oak

Sec. 11

Man. 0.5 below Grade
 (9-29-32)

T.P.

Sec. 14

T.P.

0

22.3

24.65

8" Poplar

Station Point L. A. Rt. Bear.
576+98.0 Mont.

563+20.2 P.O.T.

2610.50

550+87.5 Mon. 0°40'

546+40.2 P.O.T.

539+66.35 P.O.T.

2627.90

530+98.0 P.O.T.

Washington Co. 85.53 47.28 0 T.P. 12
 (New Ties 9-30-32)
 Ramsey County 46.57 72.57
 10" Oak 0 1 Nail
 Cor. Ho.


24" Oak
 37.6
 5.96
 0 T.P.

Sec. 12
 TOP SHUTOFF
 Hyd. 0 38.52
 (Grade 9-30-32)
 Tree 34.7
 104 B.O.
 52.93 Tree
 18" W.O.
 30.15 0 T.P.
 Ho.

Sec. 13

2.7.11.11
 46.3
 16.0
 S.W. for Conc. Wall

37.29
 33.1 0 R.P.
 T.P. 0 52.10
 No. St. Paul Road

 

TOPOGRAPHY

COUNTY ROAD B

FROM

WHITE BEAR ROAD

TO

EAST CO. LINE

1/2 15

469

468

467

466

465

1902

2 White Bear Road.

190

2 F. Ent Lt.

464

463

+97-2' Oak 28'

+74-10' Oak 25'

+57-10' Oak 25'

+64 T.P. 31'

+24 T.P. 31'

+75 T.P. 30'

+07 14' Oak 38'

+72-14' Oak 33'

+22-M.B. 27'

+16 T.P. 30'

+19-14' Tree 25'

+10-12' Tree 9'

+16-10' Tree 11'

+05-8' Tree 23'

cultivated.

cultivated

Meadow

Meadow

Road

476

475

474

473

474.5 2 White Bear Ave.

473 12" x 30' cm.

5' Lt. & 27' Rt.

472

471

+88- 2 F Ent Lt.

+49 2 F Ent. Rt.

470

+30-F.R.O.R. 31'

Posture.

+69-T.P. 17'

+94-T.P. 13'

cultivated.

+16-T.P. 16'

+77-T.P. 17'

Brush

+85-T.P. 16'
+83-5)-M.B.X. 10'

+95-T.P. 22'

+60-Intd Sg 22'

20' one side road pavement.

+06-T.P. 15'

Farm Road.

+76-W.T.M. 20'
+66-4" Tree 29'
+62-6" Tree 29'
+47-E.F. 23'
+43-T.P. 31'

Cult.

+88-F.Lor. 34'
+52-4" Tree 29'
+55-4" Tree 29'
+45-6" Oak 27'+19-8" Oak 24'
+10-T.P. 31'

+20- 2 FE RT + RT.

483

482

481

+70 15" X 36" C.M. 17.5 RT

480

479

478

-58 20" X 53.5 C.M. 25.5 RT 25 AT

477

198-T.P. 16'

125-M. 5X. 11'

12"-vix 18'

190-T.P. 14'

118-T.P. 19'

brush

118-F. cor. 28'

169-F. cor. 21'

112-T.P. 14'

F. 22'

119-T.P. 16'
F- 25'

timber

timber

126-T.P. 14'

190-F. cor. 24'
119-T.P. 19'

brush

119-T.P. 13'
125-F. cor. 22'

pasture

118-T.P. 18'

119-T.P. 13'

462- F. ENT RT.

490

489

421- F. ENT LT.

488

487

496- F. ENT RT.

488- F. ENT RT

486

437- I. ROOD LT.

485

460- I. F. ENT LT.

484

+63-T.P. 18'

Form Yard. +20-T.P. 17'

cut

+25-T.P. 17'

000 +21-T.P. 17'

+05-M.B. 12'

Form Yard

+31-M.B. 14'

cut

+90-T.P. 17'

+44-T.P. 17'

+06-M.B. 10'

15" X 16" C.M.

+89

+8

+27







Form Yard

+76-T.P. 22'

+28-M.B. 14'

+22-E. Hedger

Form Yard

+53-M.B. 13'

+85-T.P. 15'

Form

Hedger

160

497

496

495 + 100 L F. ENT LT.

494

493

175 - 2 F. ENT RT.

492

193 L Road LT.

491

T.P.
#12 26'
F. 22

Marsh.

#75-F. Cor. 17'

#11-T.P. 14'

#58-T.P. 26'

Pasture

#10-F. Cor. 31'

#09-14" Oak 25'

#77-M. B. 16'

#69-2" Ev. Green 26'

#60-4" Ev. Green 27'

#04-T.P. 22'

#94-E. Hedge

#10-T.P. 13'

Cultivated.

Orchard

#76-2-M.B. 12'

Farm
Yard

#10-16" Oak 27'

#29-T.P. 20'

#27-M. B. 11'

#06-B. Will. 22'

#10-T.P. 13'

Cultivated

Cult.

504

503

502

501

500

1199

154 L E Cat Rt.

149.1 Mont.

498

+85-T.P. 24
 +84-F.C.R. 38
 +73-A.F. 33
 +62-T.P. 27 ✓

+85-T.P. N ✓

504

+58-T.P. 27 ✓

+91-T.P. 14 ✓
 +85-T.P. N ✓

503

+93-T.P. N ✓

+97-F.C.R. 33
 +86-T.P. 26 ✓

+01-T.P. 14 ✓

502

+86-R.R. 119 29.14
 R.D.

501

+26-T.P. 27 ✓

+21-T.P. 14 ✓

F. 33

+65-T.P. 27 ✓

+49-F.C.R. 24

+25-T.P. 13 ✓

gate

2-11/12

Timber

Barber pit
 Timber

Timber

II

511

510

509

508

507

506

103 L Road No. 8 So.

505

F-33

+75-T.P.15

+57-T.P.18

+42-T.P.19

+32-T.P.22

+23-T.P.23
F33

+38-T.P.25
+19-F. 100 33

cultivated

any path

30 Small
Trees

+24

508

+39-G.P.15

+31 $\frac{1}{2}$ $\frac{1}{2}$ Elec. R.R.

518

+28- 24" x 36" C.M. with Head W. 1 $\frac{1}{2}$ " x 5 $\frac{1}{2}$ "

517

516

+46.2 Int of Line R.R. (Full Planked Xing)

515

514

513

512


+93-T.P. 35
 +78-B.F. 33
 +75-R.R. 59/16
 King



+53-E.F. 35


+34-F.Crr. 37
 +05-B.F. 37

+93-B.F. 39
 +91-R.O.W. 44

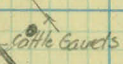

+72-E.F. 25
 +69-T.P. 27
 +52-Eloc. R.R. R.O.W. 27

R.R. 553

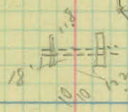

+59-T.P. 18

+51-E.R.R. R.O.W. 22

R.R. 17.3
 +98-Hk. Xing.
 +77-Hk. Xing.
 +52-T.P. 19

+60-R.R. Xing 10

+100-Hk. Xing.
 +06-P.K. Xing.
 R.R. 130

+90-T.P. 25
 +67-F. 38
 +61-T.P. 19

F. 33


R.R. 34.5
 +82-T.P. 16

+29-T.P. 18

+05-Co. R.R. Xing 59
 R.R. 500

+01-T.P. 17

+00-T.P. 34

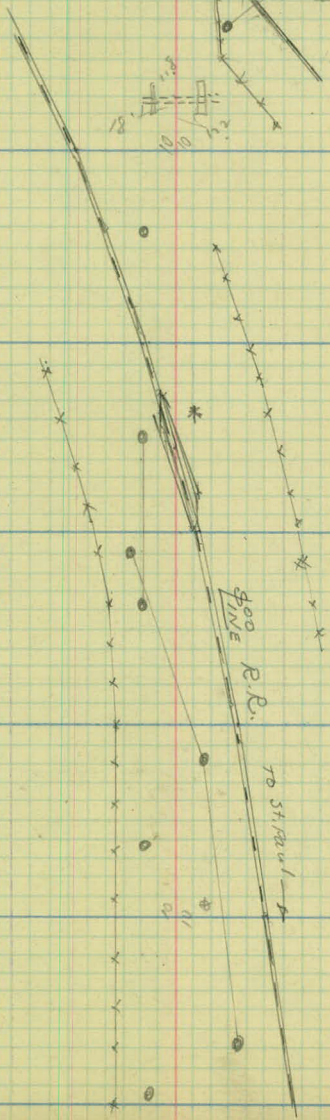

+03 - FENT 194.

525

+95 - FENT 14.

524

+36 24" x 30' G.M. Wall 10' x 5' Conc.

523

522

521

520

519

+28-T.P. 21'

+05-X.P. 21'

+80-T.P. 21'

+54-T.P. 21'

+50-R.R. 59.13

+28-T.P. 20'

+56-F.Cm. 24'

+07-T.P. 10'



+54-F.Cm. 30'



cultivated



+33-F.Cm. 32'

waste land

timber



+19-F.Cm. 31'

532

531

+98 - 1 No. St. Paul Road.

530

529

528

527

526

Plattel Land

To No. 51. 1st. 1st. 1st.

platted
land.

499 D.P. 38

487 Ir. Stop. Sq. 7

462 II. Rd. Sq. 19

403-T.P.51

#78 - End Wall 6'

+348 Rubble Wall is

Lawn.

~~37° 21'~~

720

10

2.

② ②

ch 2

8 Bru

2


6

415-P.P. 28

Stop. 1
#22 - Jk. Rd. Sg. 17
+ 11 - T.P. 28
530

+80-T.P. 21 ✓

$+76-8''00''$ 26
 $+73-10''$ 29

$45^\circ - 10'' \text{ or } K31$
 $+ 37 - 12'' \text{ or } K33$
 $+ 20 - 8'' \text{ or } K28$

460-T, P. 21

490-14" Oak 28
 469-12" Oak 21
 449-G.P. 18"

+55-T.P. 21

Row-Park Brush, W. 200

+48- Drive H.

539

+80- L Drive Lt.

538

+77- L Second St.

537

536

535

+70 Drive R-1.

+70 Drive Lt.

534

533

+65-4' walk N/S
conc. curbing

68 164 164

LOWP.

198-Street 31'
191-Fire Hydrant 33'

Platted Land

Scattered

Platted Land

546

545

+29 - ϕ Street.

544

543

542

+96 - ϕ Drive Rt.

541

540

$$\begin{pmatrix} 12 \\ 12 \end{pmatrix}$$

+34 End Hedge 37

+52-P.D. 27'

 +63-Fire Hyd. 18
 +56-Cor. Hedge 23
 +50-P.P. 38

+03-P.P. 27'

+58(2) Max 19'

+96-F. 01.30'

+05-Proc. L. 16'

Platted Land.

+62-P.P. 24'

+06-F. Line 23

+8-E. Wall. 33'

+61-F. Cor. 32'


+41-E. F. 34'

 +20-conc. Wall 33'
 +19-Proc. L. 24'

+37-23' conc. step 10'

Lawn.

Trees.

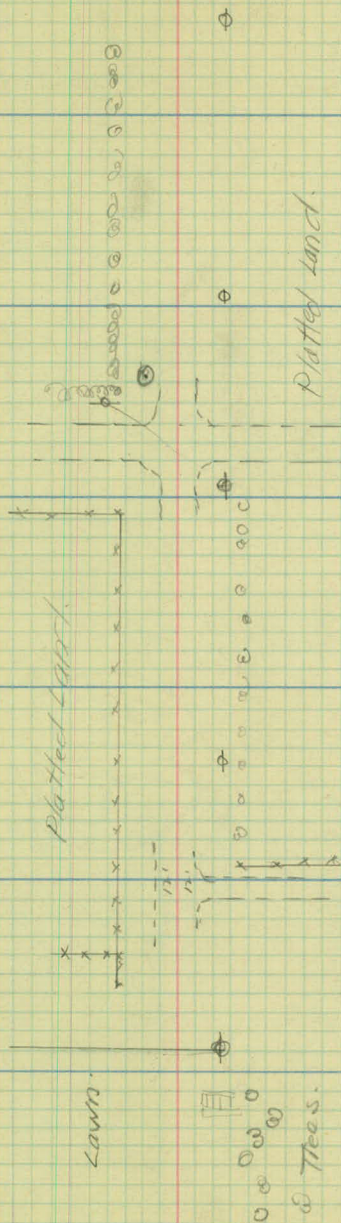

553

+40 30" X 36' C.M.

552

551

+34 Drive R/L

550

549

+20 2 Drive R/L

548

+63 Drive Lt.

547

F-24'

F-18

80

+68-F. Cor. 20'

F23

+21-Fire Hydr. 19'

+23-10" Oak 18'
F-22'

+87-F. Cor. 28'

+42-12" Oak 29'

+23-12" Oak 28'

+66-B.F. 21'

+26-Wood 4' steps 21'

+33-E. Hedge

+43-8" x 11" c.m.
12' x 20' c.m.

+16 Hedge

WALK 11' x 11'

Plaster Wall
Open Field

Timber

15' x 10' c.m.
+26

10" Oak
14" Oak
12" Oak

11' x 11'

560

559

783 Drive Rt.

558

754 2 street

557

556

555

554

401-Hedge 2 33

452-P.P. 17

Berry
Rd.

458-P.P. 18

494-Fire Hydrant
+79-Prop. 41

401-P.P. 17

435-P. 50

434-P. 40

LANE

Lawn

434-F. Cor. 28

407-F. Cor. 36

493-A.F. 41

Platted

Platted Lane

567

566

+25 - Drive Rt.

565

+45 & Charles St.

564

563


+06 Drive Lt.

562

561

+14-10" W. Oak 16'

457
15' Oak 20'

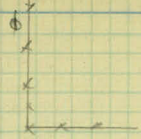

+96-R.R. 18'
+42-R.C. 26'
+20-12" Oak 16'
+17-8" Oak 28'
+08-8" Oak 22'

+99-8" Oak 30'

+57-T.P. 18'

12" Oak 20'



8" Oak 20'


+10

Berry Patch.

6" Oak 20'

+44-R.R. 18'
+44-M.B. 12'

+63-St. sign 40'
+63-Fire Hyd. 34'

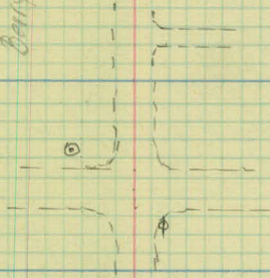

+29-R.R. 17'

+12-24" Oak 31'

+01-P.R. 17'
+98-M.B. 11'

10' 1/2"

10' 1/2" Oak 18'

+14-Hedge

+98-Hedge 9' 23'



+14-R.R. 18'

+49-24" Oak 26'

+20-P.R. 17'

574

573

572

571


+86 - 2 Road Lt.

+42 - 2 Road Rt.


570

569

568

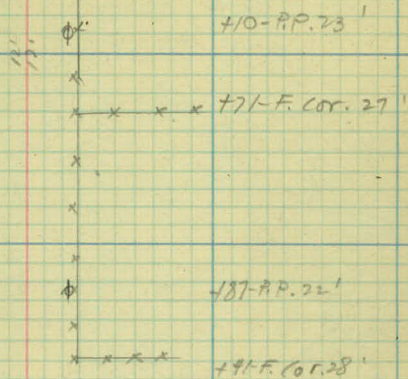

+63-PP.21'

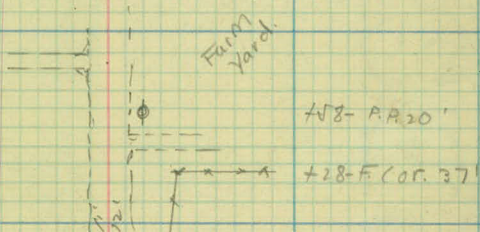

+38-8" Oak 28'
 +29-10" Oak 19'

+68-6" Oak 17'
 +61-8" Oak 14'

+17-PP.18'
 F23'

577

+98

576

575

cultivated

Washington county

184 Co. Dr. Rd. Og. 25

MOOT.


forming
land

174-AD 421

171-AD 251



cultivated.

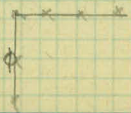

174 F. Cor. 28

178- P. P. 28

