

OFFICE OF COUNTY ENGINEER
RAMSEY CO. MINN.

Road Map Survey

PARK AVE.

From ^{Bldg.} Bald Eagle Ave. To Hugo Rd.

HUGO RD.

From Park Ave To N. Co. Line

Road Acc't. No. 18C

Date Filed 4-12-27

File

ALIGNMENT.

PROGRESSIVE SURVEY

÷ PARK AVE ÷

Rd. No 18

FROM BALD EAGLE BLVD. E. TO HUGO ROAD.

Received 4-11-27
O. Van Dusen

Office of Ramsey Co. Engineer	
ST. PAUL, MINN.	
Date Filed	4-12-27
File No.	16

STA. PT. $\Delta L.T.$ $\Delta R.T.$

✓
1+06.25 P.T.

12°-45'

1+00

12°-00'

0+54.41 P.I.

Δ 25°-30' ✓ R

+50

6°-00'

D 24°-00' ✓

✓
0+00 P.C.

0°-00'

T 54.41 ✓ ✓

* = STA. 10+58.69 (BALD EAGLE BLVD E)

L 106.25 ✓

4-4-27

COOL & RAIN

(3)
A.W.L.
A.L.P.
W.G.A.
H.B.

(P.I. BALD EAGLE BLVD. E.)
(STA. 12+71.10)

12" BIRCH

24.90

158.00

= STA. 11+13.10
(B.E. BLVD. E.)

12" BIRCH

26.55


18+79.12 END OF PAVEMENT.


4-5-27

CLEAR & WARM

{ A.W.L.
A.L.P.
W.G.A.
M.B.

(4)

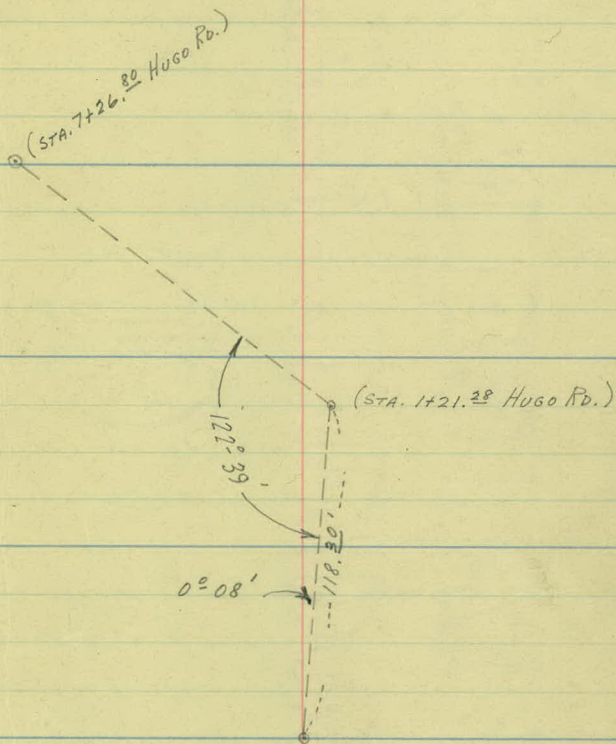

 

TOPOGRAPHY

PROGRESSIVE SURVEY

- PARK AVE. -

ROAD No 29

5+00

+65 $\frac{1}{2}$ DIVISION ST. TO RT. (20') 80'

4+00

3+00

2+00

1+00 $\frac{1}{2}$ 15' RD. TO RT. (BEAVER AVE.) 60'

0+00

6+00
4-5-27
CLEAR BY ARM { A.W.L.
A.L.P.
W.G.A.
H.B.

+65 6" BASS. 14

+39 8" BASS. 20

+17 6" ELM. 18

+01 8" BASS. 19

+71 30" OAK 27

+29 XRD. SGN. 12

+24 8" ELM. 17

7+00

+09 22" OAK 18

+97 18" OAK 26

YARDS

+36 12" OAK 19

9+00


+47 12" OAK 22

10+00

+75 I.R.D. SGN. 20

+93 14" OAK 25

+30 10" BIRCH 17

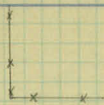

+52 TENNIS COURT 32

+29 10" OAK 27

+09 P.P. 17

+65 2

+24 P.P. 16

+32 T.P. 15

+10 END ROW 22

YARDS

+68 P.P. 16

+00 BEG. ROW OF
SMALL ELMS 24

+55 5' C. STEPS 13

+51 12" BASS 22

+19 14" MAPLE 23

+14 P.P. 16



+65 F.C. 33

+27 4' C. STEPS 17

+10 C.B. 10

+08 14" OAK 23

+00 F.L. 29

+13 4 15' ST. TO LT. 50'
12+00

11+00

10+00

+78 4 DRIVE TO RT.

9+00

+35 4 24' ST. TO RT. 60'
8+00

+97 4 DRIVE TO LT.

7+00

6+00

13+00

+50 48" C.M. 18'
 (15' x 1' HEADWALL) CONC.
 +37 G.R. 14'
 +30 BEG. G.R. 15.3
 PLANK

East St

+95 P.P. 19

MEADOW

+05 12" OAK 16

+10 P.P. 16

YARDS

+84 P.P.

CHURCH

+34 14" ELM 19'
 +18 6' WALK 16'

ELK STR

WOODED

+83 END F.L. 28

+75 12" OAK 23

+59 P.P. 16

F.L. 28'

YARD

WOODED

+47 10" OAK 23

+25 P.P. 17

+10 TENNIS. 35

+11 F.C. 28

WASTE & CULT.

+67 END G.R. 15

+65 XRD. 56W. 12

+59 G.R. 14

+59 26' W. BRIDGE 22

+51 48" C.M. 19

+45 25' W. BRIDGE 22

+15' HEADWALL (CONC.)

+100 G.R. 13.7

+72 G.R. 13.7

+66 BEG. G.R. 14.8

+44 P.P. 16

19+00

+36

± 10" Rd. To Rt.

60'

18+00

17+00

+34

± EAGLE ST. TO LT. & RAILROAD AVE TO RT.
(20') (24')

60'

16+00

15+00

14+00

13+00

+79 F.L. 32

+30 X FENCE 32
+29 P.P. 29

YARDS

+31 F.C. 32
+27 T.P. 21FILLING
STATION

+73 2-GAS PUMPS 35

+106 T.P. 20
+01 END ROW 24

YARD

+17 ROWS TREES 30
+14 T.P. 19

WASTE

+10 END G.R. 15.3
+03 G.R. 14

+68 T.P. 19

+00 G.R. 14

+79 E.R.D. 39
+71 12" G.M. 17
+47 15" G.M. 18
+27 8" OAK 31
+32 15" G.M. 20
+21 10" OAK 17
+09 P.P. 18
+00 12" G.M. 25

WOODED

+16 SIGN 55

BILLBOARD
(TO MINNEAPOLIS)+72 SIGN 33
+62 P.P. 25
+57 I.R.D. SIGN 31+99 P.P. 17
+96 N.E. COR. 30
STORE
+75 N.W. COR. 31


STORE

+23 14" OAK 31

+52 P.P. 15

WASTE & CULT.


+29 P.P. 18

 


PARK AVE.

From Bald Eagle Blvd. E. to Hugo Rd.
Road a/c N.º 29

BALD EAGLE
LAKE

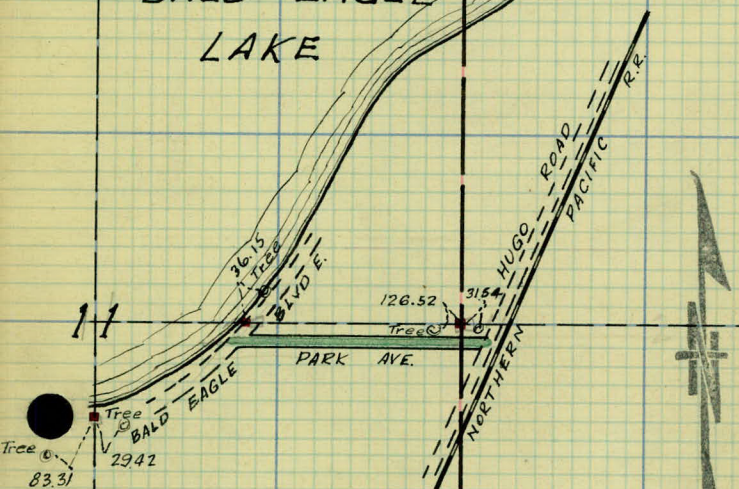

 

{ 3-16-33
Weber
Wilke
Hilton

《Present Traveled &》

Alignment Hugo Rd.

From

Buffalo Ave To N. County line

Δ -Pt. Δ -Lt.

$17+15.41$

$12^{\circ}38' L$

$14+68.11$ P.O.T. So. Line Sec. 1-30-22

$12+79.44$ P.I.

$14^{\circ}38' L$

$8+59.89$ P.I.

$14^{\circ}16' L$

$3+42.05$ Δ Pt.

$1^{\circ}00' L$

$0+00$

$0^{\circ}28' R$

3-17-33

Ext = 10.5

12" W.O. 46.50

Spike

41.29
O.P.R.

Boulder North

& Gilbert

176.75 M.

Mont and So. of line.

82.20

Nail 1787 platted.

Ext = 11'

Spike 33.75 O.T.P.

47.63
P.R.

O.T.P.

Ext = 10'

52.51
Spike
9.82 O.T.P.

Ext = 0

50
Spike
7.45 O.T.P.

58.2
15" Oak

18" W.O. 44.15
59.92 O.T.P.
Spike

Δ -Pt Δ -Lt.

72+44.52

57+94.28 P.I.

1030'R

50+77.43 P.I.

1149'R

42+59.91 F.O.T.


E+W $\frac{1}{4}$ line Sec -1-30-22

36+27.21 P.I.

444'R


30+48.10 P.I.

819'L

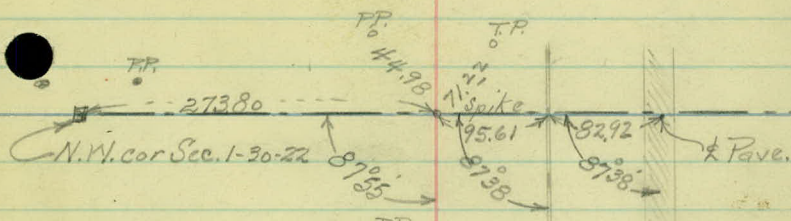


Ext. 10'


Ext. = 13.5

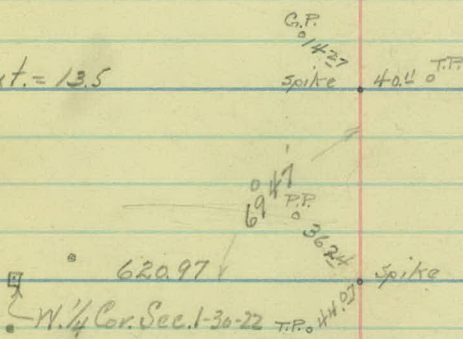

Ext. 1.0'

Ext = 10'

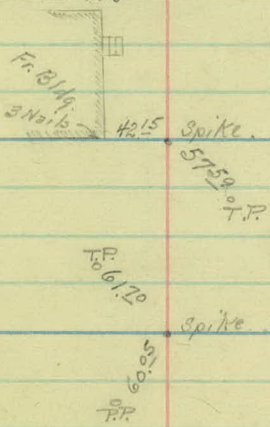

 

Alignment.

Road 9/c #18

From Sta. 0+00 to 90+69.

HUGO ROAD.

ROAD MAP SURVEY

Examined - 3-9-27
C. J. Wanders

Office of Ramsey Co. Engineer
ST. PAUL, MINN.

Date Filed

4-7-27

File No.

16

Station Point 4.4. Δ Rt. Calc. May. Bear. 1395.

8+36.96	P.T.	6°38'30" ✓	
8+00		5°32'	$\Delta = 26°34'$
+50		4°02'	$\Delta = 13°17'$
7+26.80	P.T.	13°17' ✓	$D = 60$ ft
7+00		2°32'	$T = 111.24$ ✓
+50		1°02'	$L = 221.40$ ✓
6+15.56	P.C.	0°00' ✓	$R = 955.37$ ✓

3+16.35 P.O.T


1133°43'E ✓

02+20.22	P.T.	28°38' ✓	
02+00		26°00'	$\Delta = 114°32'$
+50		19°30'	$\Delta = 57°16'$
01+21.28	P.T.	57°16' ✓	$D = 260$ ft.
01+00		13°00'	$T = 121.28$
+50		6°30'	$L = 220.22$
0+00	P.C.	0°00' ✓	$R =$

589°-01'E ✓

2-24-27

{ Wilshusen Fair-Warm.
O.S.
A.M.
M.B

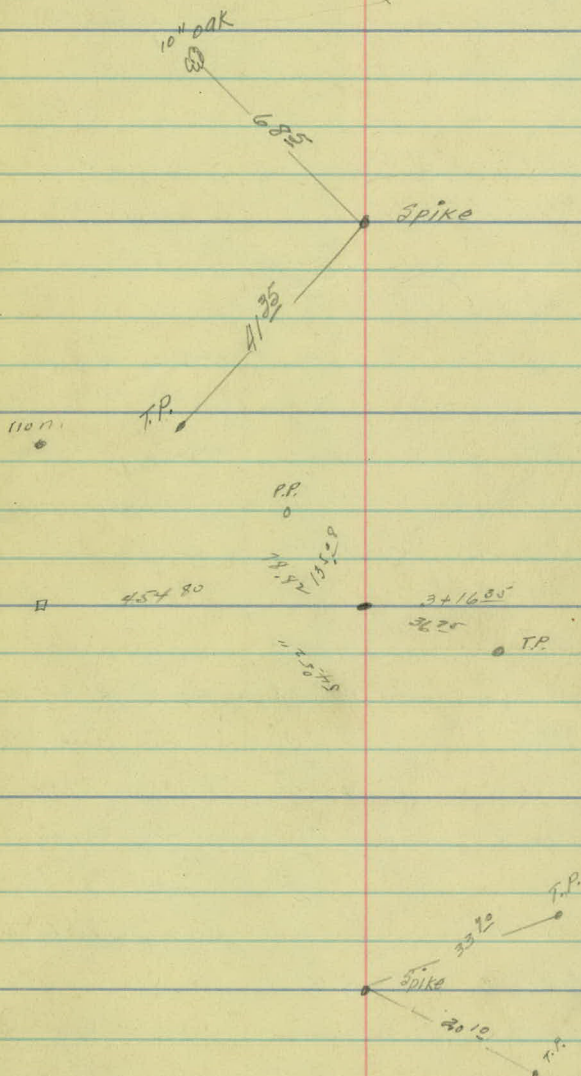

Station	Point	Δ Lt.	Δ Rt.	calc. Bear.	Wing. Bearing
---------	-------	-------	-------	----------------	------------------

21+26.85 P.O.T.

N 24° 44' E

16+18.94 P.T. ✓

2° 08'

16+00

2° 02' Δ-A = 8° 32'

15+00

1° 32' Δ = 4° 16'

14+05.70 P.I. ✓

4° 16' D = 10 Rt.

14+00

1° 02' T = 213.43 ✓

13+00

0° 32' L = 426.67 ✓

12+00

0° 02' R = 5729.65 ✓

11+92.27 P.C. ✓



0° 00'

N 20° 26' E

2-25-27

Wishnison
D.S.
A.M.
M.B.

cold-windy

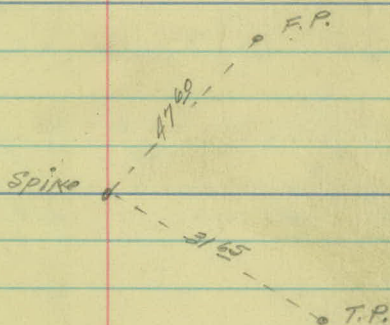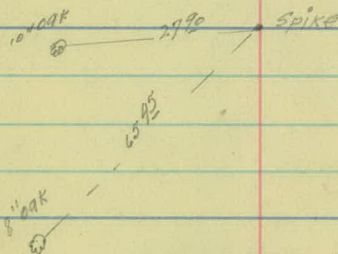

Station	Point	A Lt.	D Rt.	Calc. Bearing	Mag. Bear
33+03.32	P.T.	7°45'	✓		
33+00		7°41'			2-A = 31°00'
+50		6°41'			A = 18°30'
32+00		5°41'			D = 4° Lt.
+50		4°41'			T = 194.98 ✓
31+10.80	P.I.	15°30'	✓		L = 387.50 ✓
31+00		3°41'			R = 1432.69 ✓
+50		2°41'			
30+00		1°41'			
+50		0°41'			
29+15.82	P.C.	0°00'	✓		
					N 19° 10' E ✓
28+55.43	P.T.	6°46'	✓		
28+00		5°39'			
+50		4°39'			
27+00		3°39'			2-A = 27°04'
26+87.0	P.I.	13°32'	✓		A = 13°32'
+50		2°39'			D = 4° Lt.
26+00		1°39'			T = 169.90 ✓
+50		0°39'			L = 338.33 ✓
25+17.10	P.C.	0°00'	✓		R = 1432.69 ✓

2-25-27



Whitson

O.S.

1 A.M.

M.B.

Cold

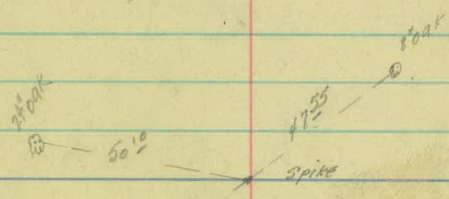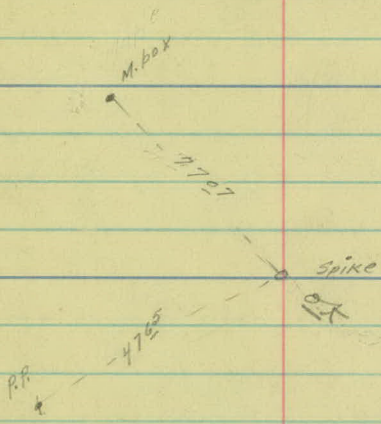

Station Point A Lt. Δ Rt. calc. Bearing

51+07.10	P.T.	4°22'	✓	Δ = 18°12'
51+00		4°29'		Δ = 9°06'
50+00		3°29'		D = 2°14'
48+80	P.I.	9°06'	✓	T = 287.90 ✓
49+00		3°29'		L = 455.00 ✓
48+00		1°29'		R = 2864.93 ✓
47+00		0°29'		
46+52.10	P.C.	0°00'	✓	

N 16°36' W ✓

37+08.87	P.T.	6°08'	✓	
37+00		5°57'		Δ = 24°32'
+50		4°57'		Δ = 12°16'
36+00		3°57'	✓	D = 4°14'
+50		2°57'		T = 153.96 ✓
35+56.15	P.I.	12°16'		L = 306.68 ✓
35+00		1°57'		R = 1432.69 ✓
+50		0°57'		

34+02.19	P.C.	0°00'	✓	
----------	------	-------	---	--

N 42°20' W ✓

2-25-27

2-28-27


Wilshusen

D.S.

R.M.

M.B.

Windy. Cold

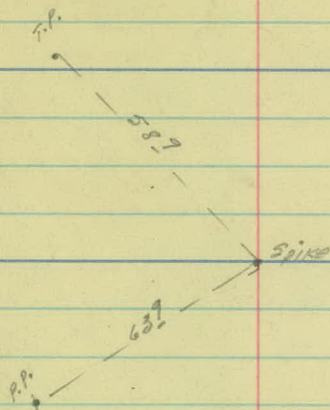

8" Maple

40.76

Spike

64.57

T.P.

Station	Point	Δ Lt.	Δ Rt.	calc. - Bearing	1149.1 Bearing
71+01.20	P.T.	✓	5°-41'	2A	22°-44'
71+00			5°-39.2	Δ	11°-22'
70+00			4°-09.2	D.	3°-Rt.
69+12.40	P.I.	✓	11°-22'	T.	190.09 ✓
69+00			2°-39.2	L.	378.89 ✓
68+00			1°-09.2	R.	1910.08 ✓
67+22.31	P.C.	✓	0°-00'		

N 190°-57' W ✓



55+88.92	P.T.	✓	2°-52'30"	2-A	11°30'
55+00			2-02'	Δ	5°45'
54+40.3	P.I.	✓	5°45'	D	2° Rt.
54+00			1°-02'	T	143.88 ✓
53+00			0°-02'	L	287.50 ✓
52+96.42	P.C.	✓	0°-00'	R	2864.73 ✓

N 250°-45' W ✓

2-28-27

WILSON
D.S.
A.M.
M.B.

313/27

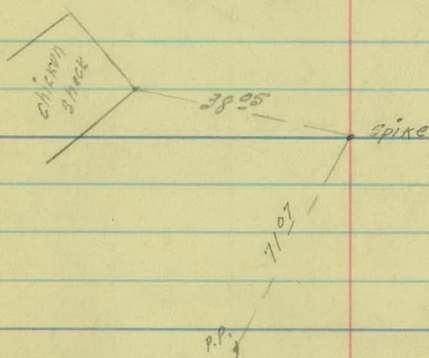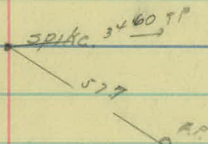

chicken
stock

Station	Point	Alt	Alt	Calc Bearing	Mag Bearing
---------	-------	-----	-----	--------------	-------------

90+69⁰⁰

N. 2° 11' E. ✓

78+17⁸⁰ PT ✓

5°-23'

78+00 =

5°-06²⁵

2A 31-32'

77+00 =

3°-36²⁵

A 100-46'

76+00

2°-06²⁸

D 30 Rt

76+38⁸⁰

PT ✓ 10°-46'

10°-46'

T 179.79 ✓

75+00

0°-36²⁸

L 353.39 ✓

74+58⁹¹



PC. ✓


0°-00'

R: ✓ 1910.08

N 85° 45' W ✓


H.L.W. 3/5/27
 D.S.
 A.B.
 T.M.

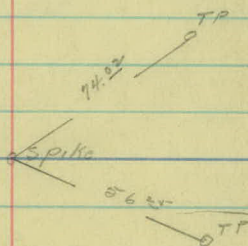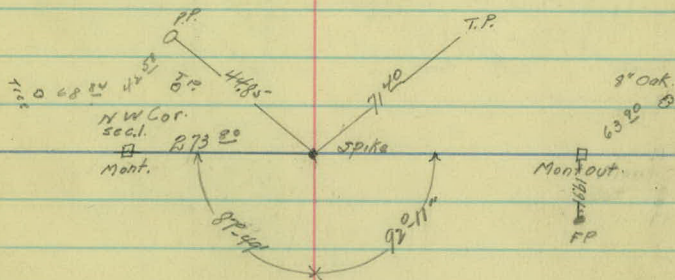

 


Sections Tico.

Road 9/6 18.

 


H. L. W.
 V.S.
 A. B.
 T. M.

3/7/27

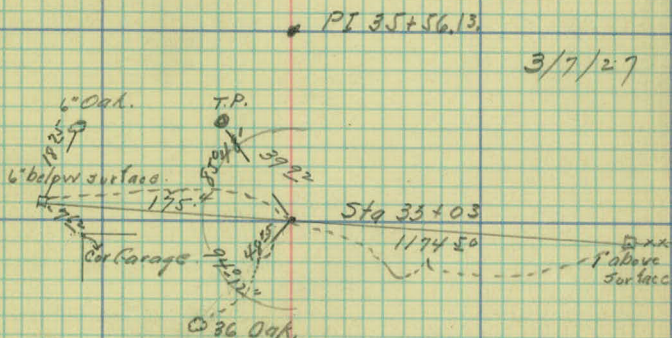


PI 31+10.8°

Pl. 7+26.89

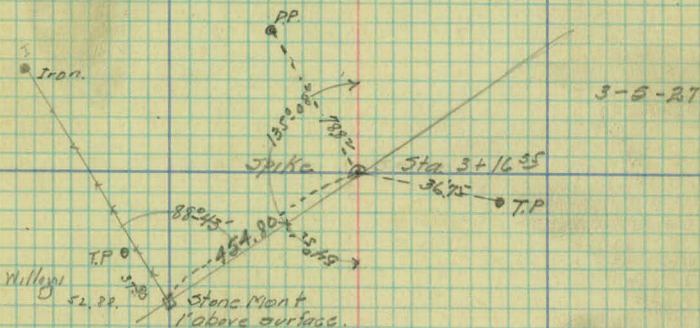


3-5-27

Pl. 1+21.28

 

H.L.W.
D.S.
T.M.
A.B.


3/3/27

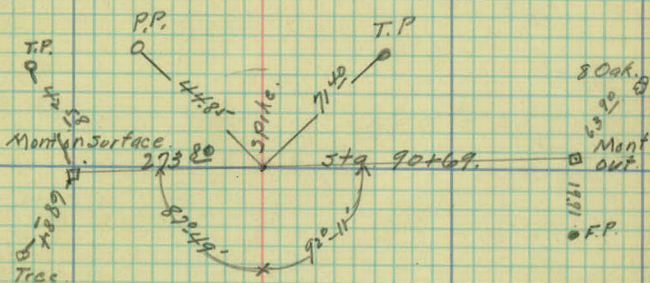


• PI 76+38.90

3/7/27

• PI 69+12.40

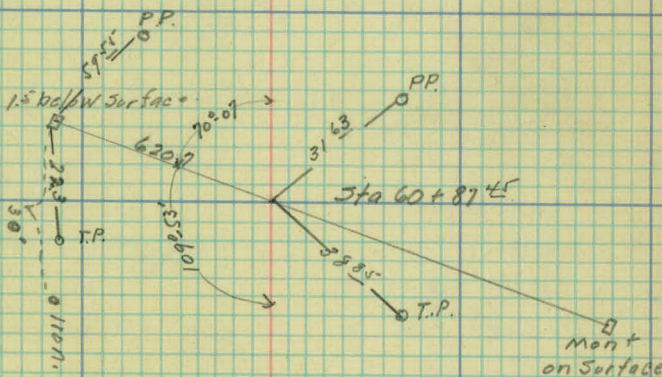

• P.I. 54+40.3

 

Topography
Road q/c #18
From Sta 0+00 to

Road bed.
Lt. Rt.

+33 F.E. Lt.

6+00

5+00

14' 12'

+04

± of cross drain
15' Lt. 16' Rt.
12" C. H.

4+00

+64 ± F.E. Lt.

3+00

2+00

+35

± 14/15 Lt

1+00

8' 15'

0+00

3-28-21 29.700

Wilkinson
D.S.
P.P.
M.B.

+46 M.P. 24'

+46 T.P. 30'

+16 M.T. 118'

+16 S.T. 80'

+70 E.Cult. 23

+51 P.P. 21'

+33 T.P. 47'

ST 82 INT 141

+94 P.P. 17'

+08 T.P. 41'

+64 E.Vard.
+58 R.F. 20

F. 23'

+00 M.T. 184'

+00 S.T. 76'

+03 R.P. 35'

+28 P.P. 26

+20 T. 197'

+20 S.T. 71'

+64 Rd 319 W 18'
+60 E. 21'

+85 Tree 13'

+71 T.P. 30'

F. 16'

E. Woods 39'

+12 P.P. 36'

+54 T.P. 16'
+50 F. 26

Pav. 10' F. 31'

+04 Edge Pav.

20' 13/K. Top

+14 E. Woods 26
Pav. 10

Road bed
Lt. Rt.

13+00

12+00

+74

4. Cross drain

20' V.P. 8" 14' Rt.

11+00

+57

Road Lt. Radius

10+00

17'

10'

+15

P.E. Lt.

9+00

+68

4. Walk 29' Lt.

8+00

+40

P.E. Lt.

7+00

2-28-27 29.1400

+22 P.P. 1. R 24'

+75 2-M. by 23'
+75 B. Cultivated


+26 x P. 22'
+26 M. by 24'

+25 M. by 21'
0. P. 24'

Cultivated

Yard

Yard

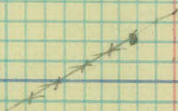

+90 T. R 24'

F. 24'

+61 F. P. 27'

+92 T. 112 1/2

+22 T. P. 29

F. 23'

+68 J. P. End 3 T. 100

+00 M. T. 107
+00 S. T. 103
+16 T. P. 29
F. 36

F. 34'
+95 T. P. 29'

+37 M. T. 1005
+37 S. T. 85'

P. 38'

Trce 261
+75 T. P. 27'
+75 T. P. 20
+70 F. 21
+64 Trce 25'

Property
Railroad
P.O. W.
Railroad P.O. W.

Road bed.
Lt. Rt.

138

F.E. Lt.

20+00

14'

10'

19+00

108

E. of Buffalo Ave

18+00

17+00

16+00

110

F.E. Lt.

15+00

12'

12'

14+00

310.21+00

2-28-27

+28 E.F. 28'
+20 N.P. 20'
F. 29'

+00 T. 98.5
F. 31'
+95 T.P. 29'

F. 31'

+55 F. 32'
+47 Rd. 19'

F. 28'
+90 Rd. 9'
+91 D.E. 27'
+69 T.P. 27'
+54 Rd. 30'

Gravel Buffalo Ave. Road

+50 Rd. 37'
+30 Rd. 21

+85 Rd. 17.5 F. 26
+60 Rd. 9'
+40 T.P. 24'

+26 P.P. 24'

F. 26'
+18.5 T. 113'

+05 B. to H.
+19 N.P. 19'

+13 T.P. 28'
F. 28'

+22 P.P. 22'

+00 T. 117.5
F. 28'
+92 T.P. 22'

P. 30'

yard

yard

cultivated

Railroad Property

Road bed.
Lt. Rt.

+22

F.E. Lt.

27+00

+51

Int. of Cross drain

44' X 12" V.P.

26+00

25+00

12'

12'

24+00

23+00

+12

R.E. Lt

22+00

21+00

2-28-29 19. 18+00

+69 M. by 14'

+96 T.P. 24'

2-28-27

+45 E. Swamp
+88 Tree 15
+32 Tree 15

Yard

Swamp

Swamp

+12 E Woods 100'

Woods 31'

+11 P.P. L.P. 22'

Woods

+22 B. Woods 22'

Yard

E. of P. 32'

+80 T.P. 21'

+62 C.V. 21'

Property

+72 T.P. 19'

+70 Rd. 3190 14'

+170 T 775

E. 32'

+57 T.P. 24'

+35 T.P. 31'

E. 38'

Railroad

+35 T.P. 32'

+10 E. 31'

34+00

33+00

32+00

31+00

30+00

12'

12'

250

E. of Taylor Ave

45' x 12" C.M. 19' 10" of R

29+00

28+00

19. 35+00

W. 15th St
25'
R.R.
15'

2-28-77
193 T.P. 23'

+ T 78

122 Tree 28'

+76 T.P. 21

+0824 T. 77'

F. 35'

+56 T.P. 21

F. 34'

+42 T.P. 27'

B. 4 F. 39'

+17 T.P. 18'

+15⁸⁴ T. 76'

+18 T.P. 18'

+55⁴³ Truck 76²

R.O.W.
Railroad

R.O.W.
Railroad

+61 P.P. 22'

+26 P.P. 22'

+82 W.P. 15'

+23 P.P. 13'
+21 P.P. 19'


+81 W.P. 18'

+73 P.P. 19'

+23 P.P. 18'

Yard Woods

Yard and Woods

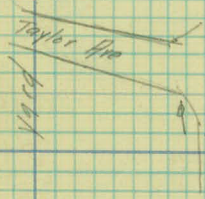

Road bed.
Lt. Rt.

41+00

+78 F.E. to Lt.

20' X 12" C.M. 26' Lt from $\frac{1}{2}$

+24 F.E. to Lt.

40+00 13' X 12" R.P. 24' from $\frac{1}{2}$ 13' 12'

+75 F.E. to Lt.

18' X 12" C.M. 23' from $\frac{1}{2}$
good

+46 F.E. to Lt.

39+00 $\frac{1}{2}$ F.E. to Lt.

+60 $\frac{1}{2}$ F.E. Lt.

20' X 12" C.M. 25 Lt.
good

+66 F.E. Lt.

38+00 26' X 15" C.M. 26' from $\frac{1}{2}$
good

37+00

154 $\frac{1}{2}$ of Conc. bx Culv.

40' Long. 4' X 8' opening 22.3 Rt. 17.7 Lt.

36+00

35+00

14'

14'

42+00

WILSON

2-28-27

+68 P.P. 21'
+60 + P. 31

+68 T.P. 20'

Row Trees 31'

F. 37'

+30. N. 6x16'

+55 T.P. 20'

+01 P.P. 21'
Row Trees 30'

F. 36'

+09 N. 6x16'

+46 T.P. 20'

F. 36 T. 295

+45 N. 6x15'
+35 P.P. 21

+32 T.P. 22'

+16 N. 6x15'
R. Trees 34'

F. 36

+16 N. 6x15'
Row Trees 37.5'
+91 N. 6x16'
+89 P.P. 23'

+08 T.P. 23'

+21 T.P. 23'

F. 36'

+35 E. of Wood 230'

+12 P.P. 18

+05 T.P. 26
F. 36

400'

Lava property and scattered trees

Railroad

R.O.P.

Railroad

Road bed.
Lt. Rt.

48+00

15

10'

Box Cul. 6' x 12' x 12' Fair

+82 E Drive Lt

47+00

46+00

45+00 Drive Way to Lt.

44+00

15

11

43+00

+18 EE to Lt.

42+00

+4.44+00

Mossy
25.
T.M.
M.B.

+28 P.P. 30'

+08 T.P. 28

Track 35'

22'

+47 R.P. 19'

8' wide

+99 L. Walk 17

+94 T.P. 30

3' wide

+53 P.P. 28

+52 T.K.s 57'

Rail Road R.O.W.

1/2 M.P. Trks 40

+81 T.P. 25'


177 P.T.P. 25'

+86 P.P. 20'

+88 T.P. 24'

+87 G.P. 19'

+50 Car. Chick. 29

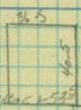

Railroad Property

+15 T.P. T.P. 22'
F.E. 28

+83 T.P. 17'

+96 P.P. M.B.V. 21

+97 Car. Garage 31

+17 Tree 20

+74 " " 26

+47 Tree 26

+34 P.P. 20

+16 Tree 20

+95 Tree 20

+80 M.B.V. 14'

+79 T.P. 21

+79 T.P. 19'

+09 Streets 30'

E34'

Road Bed
Lt Rt

55+00

54+00

13' 13

+15 x Drain' 12" x 40 16' R

53+00

13' 13'

52+00

51+00

9 10

50+00

49+00

3/3/27

Seukup
D.S.
AB
T.M.

+67 R.F. 32'

+95 House 26'

+67 TP 18'
+67 M.B. 15'

+10 TP 27'

T. 81'

+94 House 50'

+50 House 41'

+71 TP 28'
+20 T 22'

+98 TP 20'

+15 L 3g. 18'

+10 TP 16'

+08 T 27'

+95 T. 15'

+84 T. 17'-25'

+68 T 20'

+53 25. 18'

+39 RTP 42'

End Brush

T. 68'

+81' RP 23'

+44 Brush 20'

+44 TP 12'

T. 47'

+31 TP 20'

+76 RTP 30'

T. 39'


+91 PP 25'

+65 Bag Brush 26'

+26' TP 27'

+11 RTP 15'

T. 34'

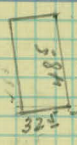

R.R. ROW

Road Bot
L+ Rt

62+00

61+00

Side Drain 13" x 51" C.M. Good.

+ 95 E Overlake Ave 281

60+00

11 14'

5900

58+00

57+00

56+00

13' 18'

5/3/27

Meadow

P.R.R.O.W.

+ 88 F.C. 30'

+ 15 P.P. 23'

Over Lake A.D.C.

+ 77 B.C. 30'

+ 68 M.P. 10'

+ 58 M.P. 13'

+ 47 T. 12'

+ 22 T. 18'

+ 70 T. 13'

+ 41 T. 14'

+ 34 P.P. 31'

+ 76 T. 15'

+ 26 T. 15'

+ 01 T. 14'

+ 01 End Brush 29'

+ 52 T. 14'

+ 46 P.P. 19'

Bag Brush 29'

T. 11 E House 31'

118 119
116
114 115 116

111

112

111 112

111 112

111

111 112

111 112 113

111 112 113

+ 84 T.P. 28'

F. 24' T. 84

+ 70 T.P. 27'

+ 03 C.P. 28'

+ 60 T.P. 27'

T. 23' F. 33'

+ 49 T.P. 27'

F. 33'

+ 20 E. W. 14' 20'

F. 33'

+ 33 T.P. 27'

F. 33'

+ 24 T.P. 22'

T. 12' T. 34

N.P.R.

P.R.R.W.



Road Bed
Lt Rt

+49 & Drive Lt

69+00

13'

13'

68+00

67+00

66+00

65+00

64+00

63+00

13

13'

3/3/27

Cultivated.

+15 GP 21
+09 PP 27

Drill.

+56 B.F. 35'
+18 TP 25'
+40 End F. 35'
F 35' T 85'

RR ROW

+18 TP 31'
T 85' F 36'

+10 PP 24'

+15 TP 32'
F 37'

NP RR

+18 TP 31'
F 33'

Cultivated.

+14 PP 26'

RR ROW

+08 TP 33'
T 83' F 35'

F 35'

+90 TP 39'

Meadow

+08 PP 29'

F 35' T 85'

Road Bed
ht Rt.

76

75

13

13'

74

73

72

12

11

71

70

Cultivated.

+09 PP 21'

+75 GP 21'

+07 PP 22'

Cultivated

+09 PP 20'

N.P.R.R.
R.R. P.O.W.

T 89 F 39
+ 96 TP 28

T. 84' F 35'

+74 TP 191

T. 78 F 28'

+65 TP 21'

F 25 T. 75.

+55 T.P 23'

T. 74 F 25'

+48 TP 26'

F 29-F 79'

+25 TP 28'

F 33 T. 92'

83

82

13'

14'

+25 E Drive Rt & Lt

81

80

79

78

77

15'

17'

3/3/27

+99 TP 28'

+05 PP 22'

T 91 F 31

+86 TP 22'

+45 RTP 37'

T 93 F 31

09 PP 28'

+01 BMB 17

Brick H.

Brick Rt

+30 BF 33'

+66 TP 25'

+20 EF 33

T 92 F 33

+81 RTP 37'

+17 TP 21

T 92 F 33

+18 CP 21'

+09 PP 24'

RR.R.O.W.

N.P.R.

+20 RTP 37

+18 TP 21

T 92 F 36'

+12 TP 27'

T 91 F 42

+08 PP 19'

+03 TP 30'

T 91 F 43'

Road Bed.
L+ R+

+69 B. M. Co Rd.

90

14'

15'

89

88

87

12'

14'

86

85

84

Joe/Kop
P.S.
AB
T.M.

+69

43" 158"
24" 151"

+67 T. 95' F 32'

+67 Jr Rdg 29'

+14 TP 25'

F 32

42 Co Rdg 35'

403 PP 23'

+08 RTP 40

F 32'

405 PP 22'

+91 TP 25'

T 95' F 30'

+12 TP 24'

+45 RTP 39'

T 94' F 29

+57 Rd Sp. 16'

+34 TP 24'

T 92' F 30

+80 RTP 39'

+15 TP 20'

T 91' F 31

409 P.P. 23

+16 RTP 39

T 90' F 32

R.R.R.W.

N.R.R.

265

2758⁰
3
82145

02
37462

Hugo Road
and
Railroad Alinement

Park Ave → North 400'

use "R-20"

8° 61
43

1° 45'

17+82

9° 01'

105'

17

8° 18

152.5

182

16

52.5

1050

4200

15

43.050

14

52.5

13

2

12

3° 55.5'

262.5

240

22.5

11

3° 03

52.5

8° 48'

4° 22.5

10

2° 11.5'

52.5

55.5

9

1° 19.0

52.5

3

52.5

8

52.5

26.5

49.5


262.5

472.5

2100

7+51.5

2598.75

 

7+51.5 PT

5° 17'

7

³⁴
4° 46'

$\Delta = 10^{\circ} 34'$

6

3° 46'

5

2° 46'

4

1° 46'

3

46'

2+23.2 PC

0° 00'

200

10/100

60'/100

.515
360
30.900

23.2
1.60
13.920

76.8
4.460
46.080

9° 0' 9 0'
5 17
14° 18'

5° 17'

0.00

DIRINK

Pepsi

2° 1°/100'

15'/25'

1°45' 1°30'

105' 1°15'

52.5' /100/1°

13.1' /100/45'

30'

15'

PCC 0.00

13.1

13.1

26.2

39.3

52.4

13.1

65.5 1°05.5'

13.1

78.6 1°18.6'

91.7 1°31.7'

13.1

1°44.8'

1°57.9'

2°11.0'

June 5, 1968

Face
PP
o

Face
o PP

54.10

76.97

o

Iron

114.45

Face
PP o

PARK AVE.

P.C.

2123.12

1155.7

67.5

P.T.

FK
GA
DM

May 5, 1968

Cor.
Foundation
#5333

111.05

81.22'

Capped Iron

104.35'

67.46

#5325

89.80'


Cor. Found

85.47'

38.07'

Iron


Face
PP

 

J.A.
LP:D
BJ
B.L.

JUNE 29, 1976
Cldy
1

ALINEMENT

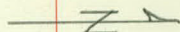


HUGO Rd 1200' S.

FROM 1200' South of


OVER LAKE Rd to OVER LAKE Rd


WEST 1/4 LINE
SEC. 1, R. 30, T. 22

MONT.

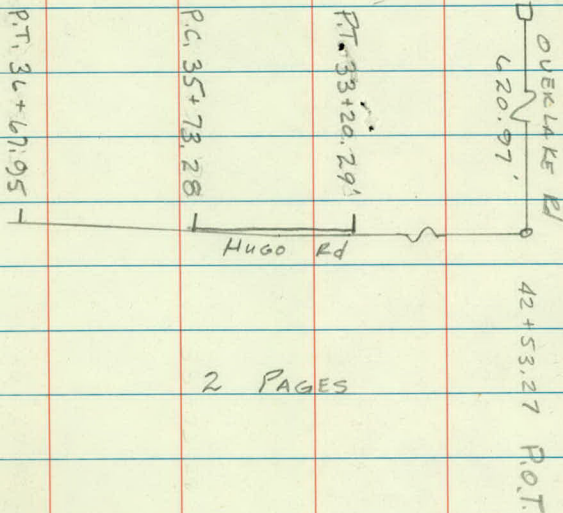

2 PAGES

 

 

STA	Point	Lt	Δ	Rt
-----	-------	----	----------	----

42+53.27	P.O.T.			
----------	--------	--	--	--

36+67.95	PT			
----------	----	--	--	--

+50				
-----	--	--	--	--

36+20.66	P.I.			
----------	------	--	--	--

36+00				
-------	--	--	--	--

35+73.28	P.C.			
----------	------	--	--	--

33+20.29	PT			
----------	----	--	--	--

			$2^{\circ} 22'$	
--	--	--	-----------------	--

			$1^{\circ} 55' 05''$	
--	--	--	----------------------	--

				$\Delta 4^{\circ} 44'$
--	--	--	--	------------------------

				$D 5^{\circ} 00'$
--	--	--	--	-------------------

			$0^{\circ} 40' 05''$	
--	--	--	----------------------	--

				$T 47.38'$
--	--	--	--	------------

			$0^{\circ} 00'$	
--	--	--	-----------------	--

				L
--	--	--	--	-----

J. A.
LPD
B. J.
B. L.

JUNE 29, 1976
CLDY 75° 2

N.W. COR OVER LAKE Rd

Hugo Rd

Hyd R.

86.03'

PK 62.01'

1/4 LINE AT
OVER LAKE Rd

PP

68.80

S.W. COR OVER LAKE Rd
AND Hugo Rd

Sta

Point

21

1

R+

CURVE

DATA