

OFFICE OF COUNTY ENGINEER
RAMSEY CO. MINN.

Road Map.....*Survey*

PORTLAND ST.

From.....*Lake Ave.*.....To.....*N. Co. Line*

Road Acc't. No.*51 19*

Date Filed.....*6-4-26*

File.....

of Ramsey Co. Engineer
ST. PAUL, MINN.

6-4-26

Ponthand. Street.

Road # ~~27~~ 19

Alignment.

Sta. 0+00 To 100+00

Austin

Skoglund

Fritz

Alexander

Rasmussen

Jankoski

Panty.

Apr. - 1926

Station.

Ang. ht. ⁸ Ang. Rt.

26+86²⁵ P.I.

0°28'

17+59⁴ P.I. 1°00'

15+96¹⁵ P.O.T. ~~8~~ R.R.


6+80¹ P.I.

0°49'

0+00



800 ft.

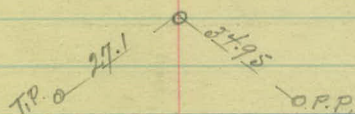

Iron. P. O

O Iron. P

P.I. 75401.4

43.83

930.08

34.0

0+00

To St. Paul

Station

Ang. ht. Ang. Rt

37+93.7 P.I. Sec. Tie.

38+73.7 P.T.

37+93.7 P.I. 26°09'

37+10.26 P.C.

34+49.3 P.O.T



37+10.26 - 0°00'

+50 - 3°10 3/4'

38+00 - 7°10 3/4'

+50 - 11°10 3/4'

+73.7 - 13°04 1/2'


16° Curve R.H.

$\Delta = 260.69'$

Rad = 359.27 ✓

Tang = 83.44 ✓

Length = 163.44 ✓

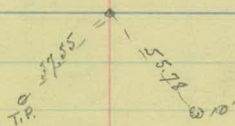

54.68 @ 18"

59.42 @ 16"

Station

Ang. ht.

Ang. Rt.

61+23.0 P.T. ✓

59+78.0 P.I.

14° 35'

58+31.33 P.C. ✓

48+82.12 P.T. ✓

47+56.9 P.I. 25° 38'

46+26.39 P.C. ✓

41+54.4 P.I. 1° 25'

Sta - Def

58+31.33 - 0°00'

59+00 - 1°043'

60+00 - 4°13'

61+00 - 6°43'

61+23 - 7°17½'


5° Curve. R1

$\Delta = 14°35'$

Rad = 1146.28 ✓

Tang = 146.67 ✓

Length = 291.67 ✓

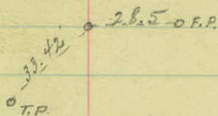

Sta - Def

46+26.39 - 0°00'

+50 - 1°11'

47+00 - 3°41'

+50 - 6°11'

48+00 - 8°41'

+50 - 11°11'

+82.72 - 12°49'


10° Curve. R1

$\Delta = 25°38'$


Rad = 573.69 ✓

Tang = 130.51 ✓

Length = 256.33 ✓

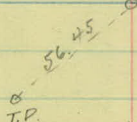

T.P. 35.92

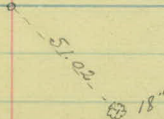

4

Ang. ht. Ang. Rt.

70+02.6 P.T. ✓

69+30.4 P.I. 2°54'

68+57.6 P.C. ✓

65+12.82 P.C. See.
Tie

67+77.0 P.T. ✓

66+45.3 P.I. 10°34'

65+12.82 P.C. ✓

Sta - Def.

68+57.6 - 0°00'

69+00 - 0°25'

70+00 - 1°25'

70+02.6 - 1°27'

T.P. 2

42.88

31.93

2° Curve. RT

$\Delta = 2°54'$

Rad = 2864.93 ✓

Tang = 72.51 ✓

Length = 145.00 ✓

66+45.3 P.S. 0

74+03.

176.1

M.C.

P.C.

65+12.82

Sta - Def.

65+12.82 - 0°00'

66+00 - 1°45'

67+00 - 3°45'

67+77 - 5°17'

4° Curve. RT

$\Delta = 10°34'$

Rad = 1432.69 ✓

Rad = 1432.64 ✓

Tang = 132.48 ✓

Length = 264.17 ✓

26.93 Triple

72.18

Twin

2

Ang. ht. Ang. Rt.

$73+62.62$ P.T. ✓

$73+03.7$ P.I. $4^{\circ}43'$

$72+44.7$ P.C. ✓

✓ $72+33.2$ P.T. ✓

$71+40.1$ P.I. $7^{\circ}30'$

$70+46.2$ P.C. ✓

Sta - Def

72+44.7 - 0°00'

73+00 - 1°06 1/2'

73+62.63 - 2°21 1/2'

4° Curve. ht.

$\Delta = 40 45'$

Rad = 1432.69

Tang = 59.00 ✓

length = 117.92 ✓

22.770 F.P.

15.08 F.P.

Sta - Def

70+46.2 - 0°00'

71+00 - 1°05'

72+00 - 3°05'

+33.7 - 5°45'

4° Curve. Rt.

$\Delta = 70 30'$

Rad = 1432.69 ✓

Tang = 93.898 ✓

length = 187.50 ✓

22.65 F.P.
T.P.

79+81.03 P.T. ✓

78+89.5 P.I. 7°20'

77+97.70 P.C. ✓

76+01.24 P.T. ✓

75+10.4 P.I. 18°21'

74+17.24 P.C. ✓

Sta - Def.

77+97.7 - 0°00'

78+00 - 0°03'

79+00 - 2°03'

79+81⁰³ - 3°40'24.38
FR32.27
FR

4° Curve. ht.

 $\Delta = 7^\circ 20'$

Rad = 1432.69 ✓

Tang = 91.80 ✓

Length = 183.33 ✓

Sta - Def

74+17⁷⁴ - 0°00'

+50 - 1°37'

75+00 - 4°07'

+50 - 6°37'

76+00 - 9°07'

+01²⁴ - 9°10½'23.6
T.P.21.18
T.P.

10° Curve. ht.

 $\Delta = 18^\circ 21'$

Rad = 573.69 ✓

Tang = 92.66 ✓

Length = 183.50 ✓

Ang. ht. Ang. Rl.

84+39.94 P.T. ✓

83+80.4 P.I. 4°46'

83+20²² P.C. ✓

81+84³⁹ P.T. ✓

81+08²⁵ P.I. 31°26'

80+27²² P.C. ✓

Sta - Def.

83+26.77 - 0°00'

84+00 - 1°35'

84+39.24 - 2°23'



4° Curve. ht.

$\Delta = 4^\circ 46'$

Rad = 1432.69 ✓

Tang = 59.63 ✓

Length = 119.17 ✓

Sta - Def


80+27.25 - 0°00'

+50 - 2°17'

81+00 - 7°17'

+50 - 12°17'

+84.39 - 18°43'

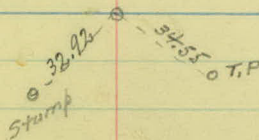

20° Curve. ht.

$\Delta = 31^\circ 26'$

Rad = 387.94 ✓

Tang = 81.04 ✓

Length = 157.16 ✓

Station.

Ang. ht ^{ft} Ang. Rt.

89+86⁵⁹ P.T. ✓

89+00.9 P.I. 24°26'

88+12⁰⁷ P.C. ✓

86+58¹⁸ P.T. ✓

85+69⁵⁵ P.I. 8°53'

84+80⁵¹ P.C. ✓

Sta - Def

88+12.7 - 0°00'

88+50 - 2°39'

89+00 - 6°09'

+50 - 9°39'

89+86.9 - 12°13'


14° Curve. ht.

$\Delta = 24° 26'$

Rad = 410.28

Tang = 88.83 ✓

length = 174.52 ✓

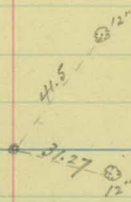

84+80.51 - 0°00'

85+00 - 0°29 1/4'

86+00 - 2°59 1/4'

86+58.8 - 4°26 1/2'


5° Curve. ht.

$\Delta = 8° 53'$

Rad = 1146.28 ✓

Tang = 89.04 ✓

length = 177.67 ✓

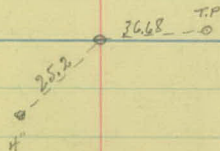

Station.

Ang. ht. ⁴ Ang. Rt.

93+80²⁵ P.T. ✓

93+22⁴ P.I. 23°36'


92+62²⁵ P.C. ✓

92+00¹⁷ P.T. ✓

91+30⁴⁵ P.I. 11°12'

90+60¹⁷ P.C. ✓

92+62.25 - 0°00'
 93+00 - 3°46 1/2'
 +50 - 8°46 1/2'
 93+80.25 - 11°48'

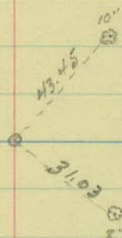

20° Curve Lt.
 $\Delta = 23° 36'$
 Rad = 287.94 ✓
 Tang = 60.15 ✓
 Length = 118.00 ✓

90+60.17 - 0°00'
 91+00 - 1°36'
 +50 - 3°36'
 92+00 - 5°36'
 +50.17 - 5°36'



8° Curve Rt.
 $\Delta = 11° 12'$
 Rad = 716.78 ✓
 Tang = 70.28 ✓
 Length = 140.00 ✓

Station

²
Ang. ht. Ang. Rt.

100+61.26 P.T. ✓


99+76.0 P.I. 49°58'

98+76.2 P.C. ✓

98+13 ⁴⁷ P.T. ✓

96+14 ⁹⁵ P.I. 20°04'

94+12 ¹⁴ P.C. ✓

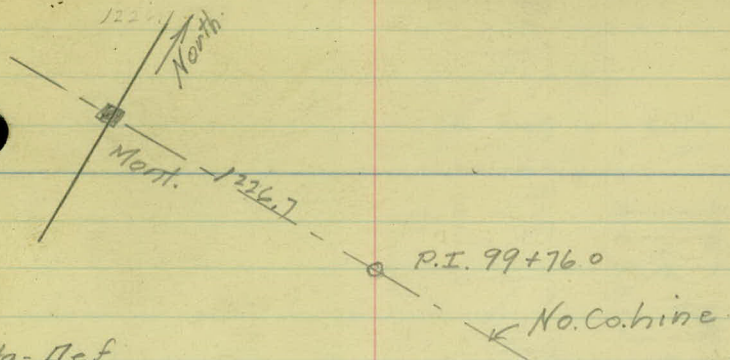

Sta - Def

98+76.2 - 0°00'
 99+00 - 3°13'
 +50 - 9°58'
 100+00 - 16°43'
 +50 - 23°28'
 +61.26 - 24°59'



27° Curve ht.

$\Delta = 49°58'$


Rad = 214.18 ✓

Tang = 99.80 ✓

Length = 185.06 ✓

Sta - Def

94+12.44 - 0°00'
 95+00 - 2°12'
 96+00 - 4°42'
 97+00 - 7°12'
 98+00 - 9°42'
 +13.47 - 10°02'

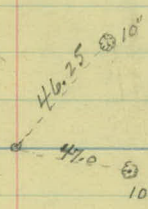


5° Curve Rt.

$\Delta = 20°04'$

Rad = 1146.28 ✓

Tang = 202.81 ✓

Length = 401.33 ✓

 

Portland Street.
Rd ~~#37~~ 19

Art. Topography.

Sta. 0+00 - 101+00

Hustin
Skoglan
Fritz
Alexander
Rosmussen
Jankoski

} Party.

Apr - 1926.

Shoulder Gravel
Width Surface

22 18

12 11 10 9

10

+73 T.P. 22

+43-6" @ 31

+37 Clump of 6-6" @ 19.5
 +04 P.P. 29
 +02-8" @ 22.5
 +01-6" @ 18.5 5400

+24 1/2 Drive 153 F.C. Cor. 39
 30.5 28.2 12" X 14" C.M.P.
 +76 P.P. 28.5

+57 Clump of 7-8" @ 3

+10 T.P. 25

15

+13-12" X 30.5 C.M.P.

4400

+57 G.P. 33
 +73-6" @ 28
 +69-6" @ 29.5
 +65-6" @ 21

37

+49 Beg Fence 35.5
 +32 T.P. 44.5

+30 T.P. 45 (2 Tel Cable Xing)

15 1/2 Rd

3400

+91 T.P. 26.5

+92 P.P. 25.0

2400

+73 T.P. 28

+92 P.P. 24.5
 282 1/2 Drive

+55 End Hedge 39

+33 Heg. 39 Beg.

+83 1/2 Drive 17
 +16 1/2

12" X 13.5 Iron Calv.
 +50 End Hedge 39

Hedge 33 1400
 +90 P.P. 23.5

+54 T.P. 31

+46 G.P. 30.5

+30 Iron Rd 3.9n 30

12" X 43.5 C.M.P. +34 Hedge 39
 +22 1/2 Iron Calv Xing

+40 Hedge 33.5

+06.6 Edge Pav

0400

11.5 : 10 9.5 : 8.5

195 T.P. 24.5

147 Fc. Cor 3.6

148 T.P. 21

Timber 30

155 Timber 6.14 29

116 T.P. 23

151 1/2 Con. Steps 21.6

102 Hedgehinge 25

180 T.P. 22

12" X 12" S.M.P.

131 T.P. 21

161 T.P. 21

104 1/2 Drive

5 M 9.11
Timber

108 1/2 Drive

106 1/2 Drive

175 1/2 St.

39

36

37

37

14.9

149 P.P. 28
179 P.P. Xing Sign 10

152 P.P. 29

140 Reg. Fc. 37

163 P.P. 30.5

124 Caution Sign 16.5
School

175 1/2 St.

163 P.P. 30.5

13400

12400

11400

10400

9400

8400

7400

6400

13: 9 10: 7

+99 R.R. Xing Sign 16

10" X 12" C.M.P

+94 T.P. 29.5

+29 M.B. 17

+26 M.B. 17

+23 M.B. 17

+96 School Caution Sign 16.5

+51 M.B. 13.5

+54 T.P. 29.5

18" X 28" V.P

Burned

+33-24" @ 39.5

+21-24" @ 39

+10 M.B. 11.5

+07 M.B. 11.5

+59-8" @ 38

+32 T.P. 28

+11 R.R. Xing P. 13.0

7-4" X 10" X 14" Xing Planks

15+96 13" Mainline

15+80.9 4" Side Track

7-4" X 10" X 16" Xing Planks

+39 R.R. Then 39

+71-T.P. 27

10" X 32.5 C.M.P

+64 F.C. Cor 38.5

+96 R.R.

+64 P.P. 22.5

+62 Hedgehine

+46 F.C. Cor 31

+53 1/2 Drive

+49 26.5

+77 1/2 Drive

+84 Hedgehine 31.5

+73 Hedgehine 21.5

+79 P.P. 21

+53 R.P. 21.5

+31 R.R. Tel. Wire Xing
2 Wires

Tracks 15" Ctrs.

+51 F.C. Cor. 33

+50 P.P. 26.5

+39-12" X 30.5 C.M.P

+65 R.P. 27

+44 R.R. Xing Sign 20

25' 16'

13'; 12 10'; 9

+36 T.P. 30.5

Undeveloped land

+98 T.P. 30

+62 M.B. 14

10" X 42" C.M.P.

+104 Road

+78 - 5' X 6' Con. Culv. 30' long

+55 T.P. 29

+46 End. Fe. 25.5

+97 21

15 15

Par. Wall - 15" X 5' X 7'
W. 195 8" X 7.5'

+64 - 36" @ 42'

+39 - 18" @ 42'

+17 - 20" @ 41.5

23100

+69 - 36" @ 35'

+65 P.R. 14.5

+47 - 30" @ 35'

+26 - 12" @ 35.5'

22400

+21 M.B. - 14'

+18 T.P. 29

+88 Fe. Cor. 30.5

12" X 28" C.M.P.

+76 & Drive

+57 27

+20 - 2' Con. Walk

+95 - 30" @ 34.5'

+81 - 20" @ 34'

+67 - 20" @ 24'

+53 - 50" @ 34'

+34 - 30" @ 34'

+22 - 30" @ 34'

+08 - 30" @ 34'

+07 Fe. Cor. 33'

+06 P.P. 23

21400

6" X 12" V.P.

+00 & Drive

+19 29

+57 - 2 M.B. 19'

+67 T.P. 30

20400

24' 15'

+60 T.P. + Fe. Cor. 28

+20 M.B. 14' 61

Reg. Brush.

Form
Yard

+138 Drive

+21-8" 60 25'
+06-12" 60 31'
+04-5" 60 24'

3340

+18 T.P. 26.5

End. Brush.

Timber land.

Form
Yard

+80-8" 60 21, 2'

+42-10" 60 32.5
+38-10" 60 27'
+35-6" 60 21'
+25-12" 60 36

+08-8" 60 30.5

3240

+36 M.B. 16'

+24 Drive

3140

+73 T.P. 29'

+99 P.P. 28.5 End

Timber land.

3040

+24 T.P. 29

Brush
+5 small
trees

Cultivated

+20 P.P. 28

2940

+46 Fe. Cor. 32.5

+37 M.B. 19.5

Brush 22

+338 Drive

Tree line 27
End

Brush 25

+81 T.P. 30

Tree line 27.2

2840

+47 P.P. 28.5

Tree line 29'

2740

Ced. in Tree
Hedge.

20

14

21

15

+06 T.P. 32'

40100

Reg. Fence

39100

+73 T.P. 29'

Cultivated land

Cultivated land

38100

+61 T.P. 27'

+50 End. Brush 21'

Brush 15'

+25 T.P. 26'

Brush 22'

Brush 20'

+94 T.P. 245'

+25 Bog Brush 20' h
+26 M.B. 13

+076 Road.

+95 F.C. Cor. 20.0'

+46-10" @ 24
+41-10" @ 22.5
+33-8" - 24.5
+24-10" - 25.5

37100

36100

35100

+90 F.C. Cor. 26'

Timber + Pastureland

Farm. +
Gund.

+40 to Drive

+11-6" @ 29'

34100

20' 12'

180 R.C. Δ 14

+13 T.P. 26'

+77 T.P. 33'

+42 T.P. 31'

+60 T.P. 34'

+64 T.P. 34.5'

Cultivated land

Cultivated land

Timber land

23
16 16
E.E.

+93-12" x 32' R.P.

+4210" @ 25.5

+95-8" @ 21

+58-8" @ 28.5
+49-6" @ 19.5
+47-6" @ 21.5
+35-8" @ 26
+20-12" @ 25

+56-6" @ 21.5

+100 R.D.R.C.

4740

4640

4540

4440

4340

4240

4140

20

15

+64 T.R. 19

19

52500

+10 T.R. 19

21

53400

Fence. Down

21

52400

+64 T.P. 21

21

51400

+14 T.P. 21 ht

21

50400

Cultivated land

22

49400

+55 T.P. 24

21

48400

21

24

15

20

15

+89 T.P. 16'

+75 $\frac{1}{2}$ Olive

Form Yard

Cultivated land

+85 F.C. Cor. 33

+65 F.C. Cor. 23

+95 M.B. 14'

+67-10' @ 20

+45 T.P. 17'

Cultivated land

ORCHARD

+35 F.C. Cor. 22

+77 F.C. 17'

Cult. land

+54 T.P. 17'

+10 T.P. 18'

Cultivated land

Fence Row

Cultivated land

||

24'

16'

+24 - End Orchard
+13 - T.P. 17.5

+85 Beg. Orchard 26'

+25 M.B. 13'

+81 End. Fc. 15

+62 T.P. 15'

+27 Fc. Cor. 14'

10" x 36" C.M.P.
+16 Fc. Cor. 23'
+11 T.P. 21'
+06 M.B. 11'

+38 Rd.

+93 - 2(6" x 12" C.M.P.)

+70 T.P. 21'

+37 T.P. 18 1/2'



Cultivated
land

Parm.
cloud

Cult.
land

Cultivated
land

Cultivated land

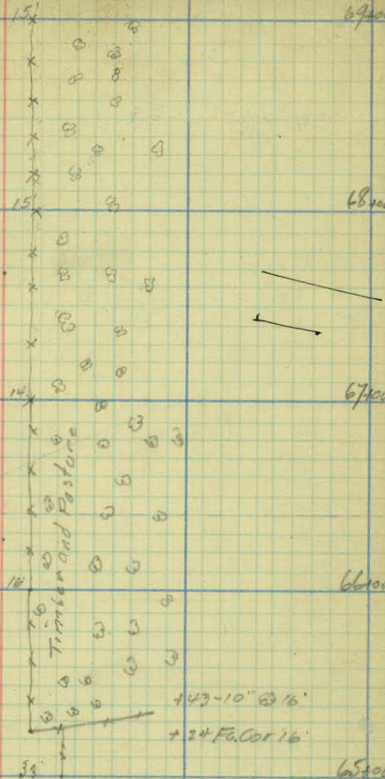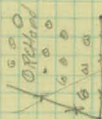

22' 15'

76200

75+00

74+00

73+00

72+00

71+00

70+00

69+00

+26-T.P.-16'

+22-T.P.-20'

+37-Fence Cor.

Fence intersects at sta. 73+00

+80-T.P.-21'

+18-T.P.-21'

+68-T.P.-20.7

+65-End of woods

Cultivated

Cultivated

Cultivated

Marsh

Marsh

Cultivated

17'

17'

17'

16.5'

16'

15'

22' 15'

83+00

+31-T.P.-17'

82+00

Sta 82+00-End brush 18'

Brush-15'-6'-width

81+00

+84-T.P. 35'

+50-Begin-Brush 20'-10' deep 48'

80+00

+80-Fence Cor.

+55-T.P. 32'
Fence intersects +50

+47-Fence Cor 20.5

79+00

Farm Yard

23'

+40-Corr. fence
+30-E Farm entrance

Fence intersects sta 78+43

+15-30" 8 24'
Sta. 78+00-E Road

+13-3-Mail boxes-25'

+91-T.P. 46

78+00

+66 concrete steps



cultivated

77+00

- +95-4" 8-33'
- +88-4" 8-33'
- +76-3" 8-33'
- +67-4" 8-33'
- +53-3" 8-34'
- +41-4" 8-34'
- +25 8 12"-33'

Farm Yard

+81-T.P. 19'-wires
{ cross road at 76+50 }

76+00

cultivated

cultivated

cultivated

19

13

+71 Twin 10" @ 22

+54 T.P. 10

Small
hole

Pasture

+89 F.C. Cor. 15
+89 T.P. 24

+45-6" @ 14.5

Brush

Pasture

Cult. land

Form
Yard

+78 T.P. 92.5

+10 F.C. Cor 20

+05 3/4 Drive

Cult. land

Cult. land

+97 T.P. 10

22

15

18

11

97+00

21.5 20'

+01 T.P. 37'

96+00

Pasture.

24 20.5

95+00

+30 T.P. 34.5

15.5 19.5

94+00

Pasture

16 16.5

93+00

Marsh

16 21

+69 T.P. 24.5
+60-12'X33' V.P.

Marsh

12.5 16.5

92+00

Small
Timber

23

23 17.5

91+00

+19 T.P. 29.5

24 19

20 19

+21-12'X33.5 V.P.

Small
Timber

90+00

19 12'

4-29-26

161405

+49 T.P. 12.0

100400

99+0

485 T.P. 16

+ 54 Fe. 17.5

+ 54 Fc. 17.5
+ 41 Bcg. Fc. 28

+28 $\frac{1}{2}$ Drive

104 Fc. Cor. 25

 $+81 \text{ FC} \Delta 30^\circ$

447 Fe. $\Delta 19$

98+00

+ 28 T.P. 22'

9770

