

OFFICE OF COUNTY ENGINEER  
RAMSEY CO. MINN.

Road Map Survey

FAIRCHILD AVE.

From Co. Road D To Rice Creek Rd.

Road Acc't. No. 20

Date Filed 4-7-25

File

4-7-25

Alignment  
Fairchild Ave

Thru. Dec. 30-30-23

Use this revision

Station Point A-Lt. A-Rt.

61+00 P.O.T.

|               |                             |                   |
|---------------|-----------------------------|-------------------|
| 58+62.97      | $1^{\circ}09^{\frac{1}{2}}$ |                   |
| +50           | $1^{\circ}05^{\frac{1}{2}}$ | A- $2^{\circ}19'$ |
| 58            | $0^{\circ}50^{\frac{1}{2}}$ | D- $1^{\circ}L$   |
| +50           | $0^{\circ}35^{\frac{1}{2}}$ | T-115.85          |
| 57+47.15 P.I. | $2^{\circ}19'$              | L-231.67          |
| 57            | $0^{\circ}20^{\frac{1}{2}}$ | R-572965          |
| +50           | $0^{\circ}05^{\frac{1}{2}}$ |                   |
| 56+31.30 P.C. | $0^{\circ}00'$              |                   |

|               |                             |                    |
|---------------|-----------------------------|--------------------|
| 51+9502 P.T.  | $1^{\circ}21^{\frac{1}{2}}$ | A- $2^{\circ}43'$  |
| 51+50         | $0^{\circ}54^{\frac{1}{2}}$ | D- $2^{\circ}R$    |
| 51+27.15 P.I. | $2^{\circ}43'$              | T-67 <sup>96</sup> |
| 51+00         | $0^{\circ}24^{\frac{1}{2}}$ | L-135.83           |
| 50+59.19 P.C. | $0^{\circ}00'$              | R-2864.93          |



10-5-32

T.P. 0-547-1855 P.P.

T.P. 0-3288-6947 P.P.

G.R. 0-1561-2282 G.R.



Station Point A-Lt. A-Rt.

100+25.70 P.I.

0°10'

95+32.80 P.I. 0°48'

90+74.50 P.I.

0°35'

86+09.85 P.I. 0°20'

78+61.10 P.I. 0°18'

74+92.90 P.I.

0°47'

8" Oak @ 48 45 -

10" Oak @ 49 75 -

18" Oak @ 40 0 -

24" Oak @ 48 18 -

15" Oak @ 30 24 -

20" Oak @ 58 97 -

12" Oak @ 50 07 -

F.P. @ 26 71 -

F.P. @ 27 54 -

56 13 - O.P.P.

T.P. @ 31 26 -

22 22 - O.P.P.

Station Point  $\Delta$ -Lt.  $\Delta$ -Rt.

109+23.39 ←  
109+18.67 = P.T.

109  
+50

108+38.30 P.I.

108

107+54.98 P.C.

11°27'5"

10°09'  $\Delta$ -22°55'

6°39' D-14°R

22°55' T-83.32

3°09' L-163.69

0°00' R-410.28

106+21.99

106

105+63.00 P.I.

+50

105+00.91

12°06'5"

9°54'5"

24°13'

4°54'5"

0°00'

$\Delta$ -24°13'

D-20°L

T-62.09

L-121.08

R-287.94




T.P. o-3428

83<sup>36</sup>

24" Poplar

T.P. o-2898

30" Oaks 42<sup>60</sup>

 

Sec. Ties

No.  $\frac{1}{4}$  Sec. 30



106.60

331.91  
91°40'

108+38.30

104+89.20

Cent. Sec. 30



62°

78+61.10-P1.

Fairchild Ave

92°09'

So.  $\frac{1}{4}$  Sec. 30



4.96

52+32.13


Co. Rd. 'E'

104.85

106°38'

51+27.15



 

Alignment notes on Rd # 20.  
(Fairchild Ave) from Co. Rd D.  
to Rice Creek Rd. (S.T. H. # 62).

Office of Ramsey Co. Engineer  
ST. PAUL, MINN.

Date Filed 4-7-25

File No 16

Crane.

Wilshusen.

Fritz.

Franko.

| Sta. | Point | Lt. | Rt. | Calc<br>Bearing |
|------|-------|-----|-----|-----------------|
|------|-------|-----|-----|-----------------|

26+16<sup>1</sup> P.O.T.

4+32<sup>18</sup> Center of West Bound Soo line Track.

N00°-00'W.

4+14<sup>29</sup> Center of East Bound Soo line track.

0+00




3/26/26

Rd. Sign 0-3283

Center of Sec. 31, Stone Mt.

Tree 5245  
Tree (Grade 9-21-32)  
Tree

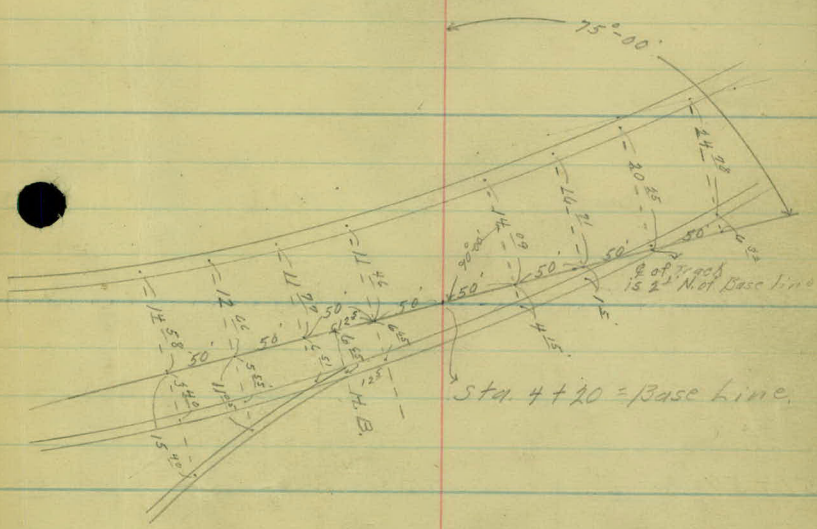

P.P.  
Guy Pole 44.43  
Iron  
Stone Mount

1/4 Cor. on the S. line  
of Sec. 31-30-13

P.P. 46.0

| Sta. | Point. | Lt. | Rt. | Calc<br>Bearing |
|------|--------|-----|-----|-----------------|
|------|--------|-----|-----|-----------------|

N00°-25'E

58+17<sup>6</sup> P.T.

56+92<sup>6</sup> P.I. 2°-30'

55+47<sup>6</sup> P.C.

N02°-52'E

53+07<sup>57</sup> P.T. ✓

51+59<sup>3</sup> P.I. 2°-58'

50+10<sup>2</sup> P.C. ✓

N00°-00'W

3/26/25

55+67<sup>6</sup>

56+00 - 0°-10'

+50 - 0°-25'

57+00 - 0°-40'

+50 - 0°-55'

58+00 - 1°-10'

717<sup>6</sup> - 1°-15'

□ Tree

Δ - 2°-30'

D - 1°-00' L.

T - 125<sup>00</sup> ✓

L - 150<sup>00</sup> ✓

R - 5729<sup>65</sup>

1/4 Cor. on the N. Line

F.C.

48.65

50+10<sup>7</sup>

Sec. 31.

+50 - 0°-12'

G.R. Post.

24.82

0 E.P.

45.67

Stone Mont. Down 0.4'

51+00 - 0°-27'

+50 - 0°-42'

41.12

0 E.P.

Δ - 2°-58'

D - 1°-00' R.

52+00 - 0°-57'

+50 - 1°-12'

Guard Rail Posts

T - 148<sup>9</sup> ✓

L - 196<sup>67</sup> ✓

53+00 - 1°-27'

+50<sup>59</sup> - 1°-29'

R - 5729<sup>65</sup>



| Sta. | Point. | Lt. | Rt. | Angle<br>Bearing. |
|------|--------|-----|-----|-------------------|
|------|--------|-----|-----|-------------------|

N01°-08'E

|                     |      |  |  |        |
|---------------------|------|--|--|--------|
| 91+70 <sup>15</sup> | P.I. |  |  | 0°-31' |
|---------------------|------|--|--|--------|

N00°-37'E

|                    |      |  |  |        |
|--------------------|------|--|--|--------|
| 83+60 <sup>3</sup> | P.I. |  |  | 0°-24' |
|--------------------|------|--|--|--------|

|                     |        |  |  |  |
|---------------------|--------|--|--|--|
| 78+62 <sup>65</sup> | P.O.T. |  |  |  |
|---------------------|--------|--|--|--|

N01°-01'E

|                     |      |  |  |        |
|---------------------|------|--|--|--------|
| 76+36 <sup>35</sup> | P.I. |  |  | 0°-33' |
|---------------------|------|--|--|--------|

✓

|       |        |  |  |  |
|-------|--------|--|--|--|
| 61+00 | P.O.T. |  |  |  |
|-------|--------|--|--|--|

N00°-28'E

3/27/25

Fence Post.

34

85

34

Fence Post.

Fence Post

0  
4


10

2

Fence Post.

470

On Fence Line

1' Above Ground. 15


Stone Mont

Center of Sec 30,

T. P. C.

315


o P. P.

o Fence Post.

78


Source: Post

Sta. Point Lt. Rt. Calc Bearing

N24°-21'W.

104+26<sup>89</sup> ✓ P.T.

105+66° P.I. 24°-53'

N00°-32'E

105+02<sup>47</sup> ✓ P.C.

99+91<sup>55</sup> P.I.

0°-32'

97+34<sup>18</sup> ✓ P.T.

N00°-00'E

96+78<sup>25</sup> P.I. 1°-08'

96+11<sup>55</sup> ✓ P.C.

105+02 <sup>47</sup>

+50 - 4°-45'

106+00 - 9°-45'

+26 <sup>52</sup> - 12°-26' <sup>5</sup>

Stamp  
52  
10

9  
4  
Tree

Δ - 24°-53'

D - 20°-00' L.

T - 63 <sup>53</sup>

L - 124 <sup>42</sup>

R - 287 <sup>94</sup>

0 40 55

96  
0 37

96+21 <sup>56</sup>

+50 - 0°-8' <sup>5</sup>

97+00 - 0°-23' <sup>5</sup>

+34 <sup>98</sup> - 0°-34'

0 T.P.  
25

59

Tree

Δ - 1°-08'

D - 1°-00' L.

T - 56 <sup>7</sup> ✓

L - 113 <sup>33</sup> ✓

R - 5729 <sup>65</sup>



| Sta. | Point | Lt. | Rt. | Calc<br>Bearing |
|------|-------|-----|-----|-----------------|
|------|-------|-----|-----|-----------------|

|                     |        |  |  |  |
|---------------------|--------|--|--|--|
| 152+38 <sup>2</sup> | P.O.T. |  |  |  |
|---------------------|--------|--|--|--|

N00°-47W.

|                     |        |  |  |  |
|---------------------|--------|--|--|--|
| 134+34 <sup>2</sup> | P.O.T. |  |  |  |
|---------------------|--------|--|--|--|

|                      |      |  |  |  |
|----------------------|------|--|--|--|
| 131+40 <sup>20</sup> | P.I. |  |  |  |
|----------------------|------|--|--|--|

0°-02'

N00°-49' W.

|                      |      |  |  |  |
|----------------------|------|--|--|--|
| 108+92 <sup>19</sup> | P.T. |  |  |  |
|----------------------|------|--|--|--|

|                     |      |  |  |  |
|---------------------|------|--|--|--|
| 108+34 <sup>5</sup> | P.I. |  |  |  |
|---------------------|------|--|--|--|

13°-32'

|                      |      |  |  |  |
|----------------------|------|--|--|--|
| 107+74 <sup>52</sup> | P.C. |  |  |  |
|----------------------|------|--|--|--|

N24°-21' W.

3/30/25

38 45 Tree.

38 1/2

Tree.

Hub 38 1/2

Hub.

38 1/2

25 5" Oak.

Center of Sec. 19.

51 Stone Mont. (Grade 9-21-32)  
51 1/2 12" Oak

54 1/2

8" Oak.

107+74 1/2

108+00 - 2°-33'

+50 - 7°-33'

+92 19°-11°-46'

A - 23°-32'

D - 20°-00'

T - 57 28 ✓

L - 117 67 ✓

R - 287 94 ✓

38 9" Hub.

27 1/2 Hub.

323 14

U.R.O.

Stone Mont

106 1/2

Sta. 104+91 35

1/4 Cor. N.  
Line Sec. 30

18" Oak

32 1/2

41 23

12" Oak

| Sta | Point | Lt. | Rt. | Bole<br>Bearing |
|-----|-------|-----|-----|-----------------|
|-----|-------|-----|-----|-----------------|

170+91<sup>0</sup> P.O.T.

N 00°-12 E

157+75<sup>13</sup> P.I.

0°-59'

N 00°-47 W

4/1/25

At fence intersection  
1' above ground,  
stone Mont.  
Center of Sec. 18.

Rice Creek N. Rd

S. T. H. #62

14" B.O. 3 9/22


Cor. Conc. Porch

stone Mont. (9-22-32)  
Down 0.3'

1/4 Cor. on the N. Line of  
Sec. 19.

T.P. 0-3/18



 

Art. Topog. on Rd # 20.  
from Co. Rd 13. to Rice Creek Rd.

sta.

5

4

3

1

2

1

0+00

3/27/23


+95 Guy Pole 10' L. 3 2 1  
+95 R. Cot. 40' L.

+94 P.P. 14' R. ✓

Guard rail L. & R. 4' High.  
Plank Flooring.

+95 End of Bridge ✓  
9' L. & 9' R.

500 Line R.R. Overhead  
Timber Bridge.

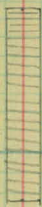

+66 Beginning of Bridge  
8' L. & 40' R.

+67 T.P. 14' L.  
+64 Guy Pole 10' L.

+54 P.P. 14' R. ✓

+51 - 10' L.  
G.L. - 6' L.

S.L. - 16' R. ✓  
G.L. - 11' R.

Cultivated Field

+27 P.P. 14' R. ✓

+36 - 11' L.  
G.L. - 9' L.

+51 F. Ent. ✓

Pasture

S.L. - 12' R. ✓  
G.L. - 10' R.

+96 P.P. 14' R. ✓

+25 I.S.P.  
Without Markers.  
+22 Guy Pole 30' L.

+27 P.P. 39' L.  
-34 Mail Box 12' L.  
-36 " " " "  
-41 " " " "  
-45 " " " "  
-47 " " " "  
-50 " " " "  
-53 " " " "

-16 - 37<sup>th</sup> Ave.  
-16 Co. M. L.  
-32 Side Dr. 17.20' R.  
18' X 31' U.N. Gossy Comp  
-41 P.P. 14' R. ✓

S.L. = 8' L. S.L. = Shoulder line  
G.L. = 5' L. G.L. = Gravel line

S.L. - 14' R. ✓  
G.L. - 10' R.



5+9.

11

10

9

8

7

6

5

5/27/20

✓ +94 Side Drain 27 ft.  
12" x 22" C.M. Good Cond.  
✓ +92 F. Cor. 20 ft.  
✓ +84 T.P. 20 ft.

5th q.

17

16

15

14

13

12

11

3/27/20

✓ +57-40"-T.-26'L.  
+40 Mail Box 12'L.

✓ S.L.-12'L.  
G.L.-9'L.

✓ +84 T.P. 18'L.

✓ +69 40"-T.-23'L.

✓ +77-40"-T.-28'L.

✓ +39-30"-T.-23'L.

✓ +15 T.P. 19'L.  
S.L.-13'L.  
G.L.-11'L.

✓ +98-24"-T.-24'L.  
✓ +84-24"-T.-24'L.

✓ +36 Guy Pole 24'L.

+36 Mail Box 13'L.  
+34 " " "  
+33 " " "  
+28 " " "

✓ +64 T.P. 12'L.

✓ +65 F.Ent.


+44  
+31 Mail Box 15'L. Farm yard

✓ +18 P.P. 34'L.

✓ +04 F.Ent.

Hay Field

Farm Yard

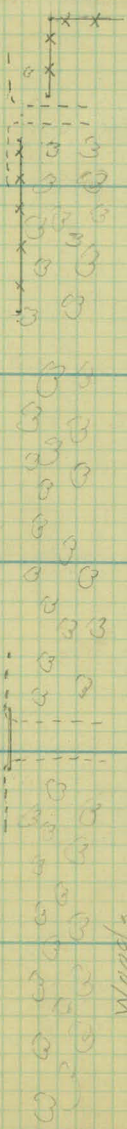

+87 F.Cor. 33'R.  
+78 P.P. 15'R.

+47 F.Cor. 33'R.

+58 F.Ent.  
+22 F.Cor. 15'R.  
S.L.-11'R.  
G.L.-9'R.

+38 P.P. 14'R.  
+30 F.Cor. 19'R.

S.L. 16'R.  
G.L. 7'R.

+37 P.P. 12'R.

✓ +06 Sunset Lane.  
✓ +90 Side Driv 12'L.  
12' x 32' C.M. Good Comp.

+59 P.P. 11'R.

+03 P.P. 10'R.



Sta.

23

22

21

20

19

18

17

3/22/25

✓ S.L. - 12' L.  
G.L. - 9' L.

✓ #81 T.P. 17' L.

#59 Mail Box 18' L.

✓ #14 - 24" - T. - 24' L.

✓ #57 T.P. 18' L.

Hay field

✓ #79 - 30" - T. - 23' L.  
✓ #68 - 40" - T. - 29' L.  
✓ #56 F. Ent.  
✓ #46 Side Drain 14' L.  
12" x 22' C.M. Poor Cond.  
✓ #40 - 36" - T. - 25' L.  
✓ #24 - 36" - T. - 30' L.  
S.L. - 11' L.  
G.L. - 9' L.  
✓ #91 T.P. 18' L.

✓ #69 - 40" - T. - 30' L.

✓ #44 - 24" - T. - 25' L.

#07 Mail Box 12' L.

✓ #44 - 40" - T. - 28' L.  
✓ #42 T.P. 18' L.

#38 P.P. 17' R.

S.L. - 12' R.  
G.L. - 9' R.

#60 F. Ent.

#96 P.P. 17' R.

Cultivated field

#54 P.P. 16' R.

S.L. - 11' R.  
G.L. - 9' R.

#21 P.P. 16' R.

✓ #11 F. Ent.  
✓ #00 Side Drain 14' L.  
10" x 18' C.M. Poor Cond.

Cultivated field

54.

59

28

27

26

25


24

23

3/27/20

✓ +76 C.F. 22' L.

S.L. - 13' L.  
 C.L. - 9' L.  
 ✓ +101 B. Cor. 22' L.  
 ✓ +100 T.P. 19' L.  
 ✓ +99 Nail Box 13' L.  
 ✓ +85 F. Ent.  
 ✓ +70 S. & S. Drain 14' L.  
 12" x 22' C.M. Good Cond. 13' L.

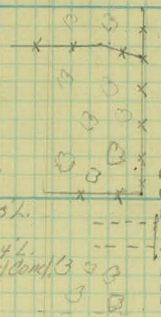

Cultivated field.

+42 P.P. 20' R. ✓

S.L. - 13' R.  
 C.L. - 10' R.

✓ +78 - 12" - T - 24' L.

✓ +57 T.P. 18' L.



+50 C.F. 25' R. ✓  
 +50 P.P. - 19' R. ✓

Hay field.

Orchard.

✓ S.L. - 12' L.  
 C.L. - 9' L.

+12 P.P. 19' R. ✓  
 S.L. - 13' R.  
 C.L. - 9' R.

✓ +89 T.P. - 18' L.  
 ✓ +78 Nail Box 12' L.  
 ✓ +77 Nail Box 12' L.  
 ✓ +77 - 36" - T - 25' L.

+61 F. Ent. ✓

← Drains

✓ +99 Cross Drain  
 12" x 32' C.M. Good Cond.  
 Extends 17' L. & 15' R.

Cultivated field.

+50 P.P. 18' R. ✓

✓ +52 T.P. 18' L.



Sta.

35

34

33

32

31

30

29

3/27/26

✓ +80 F. Cor. 34' L.  
✓ +80 F. Cor. 30' L.

✓ +34 T.P. 27' L.

✓ F. 30' L.

✓ +73 F. Cor. 28' L.

✓ +89 Glass Drain  
12' x 33' C.M. Good Cond  
Ent. comp. 15' L. & R.

✓ +75 F. Cor. 11'  
✓ +76 Silver Lake  
Sign 10' L.

✓ +54 T.P. 15' L.

✓ F. 15' L.  
✓ +96 Mail Box 12' L.

✓ S.L. - 12' L.  
G.L. - 8' L.

✓ F. 24' L.  
✓ +90 T.P. 23' L.

✓ F. 13' L.  
✓ +78 P.P. 36' L.

✓ +52 T.P. 22' L.

✓ F. 22' L.

+55 P.P. 34' R. ✓

+22 Silver Lake  
Sign 13' R.  
400 P.P. 35' R. ✓

✓ +96 F. Ent.  
✓ +85 Side Drain 6' L.  
12' x 25' C.M. & Vit.  
Cond. Fair.

+45 P.P. 31' R. ✓

S.L. - 16' R.  
G.L. - 11' R.

+19 P.P. 15' R. ✓

+81 F. Ent. ✓

silver lake

cultivated field

timber

timber

Sta.

41

40

39

38

37

36

35

3/27/86

✓ +41 T.P. 26' L.

S.L. - 12' L.

B.L. - 8' L.

✓ F. 33' L.

+49 Mail Box. 8' L.

+35 Mail Box. 13' L.

✓ +36 F. Cor. 33' L.

+33 F. Cor. 33' L.

✓ +17 F. Ent.

✓ +18 Side Drain 16' L.

15' X 22' C.M. Fair Cond.

✓ +23 F. Cor. 34' L.

✓ +76 T.P. 27' L.

✓ F. 34' L.

✓ +50 T.P. 28' L.

S.L. - 13' L.

B.L. - 10' L.

✓ F. 33' L.

✓ +87 T.P. 27' L.

S.L. - 12' L.

B.L. - 9' L.

Swamp

Timber

Cultivated field

Hay field

Cultivated field

+73 P.P. 23' R. ✓

S.L. - 15' R.

B.L. - 12' R.

✓ +33 F. Ent.  
+25 Side Drain 15' R.  
12' X 16' C.M. Fair Cond.  
+24 P.P. 28' R. ✓

+76 P.P. 30' R. ✓

S.L. - 15' R.

B.L. - 12' R.

+25 P.P. 32' R. ✓

S.L. - 14' R.

B.L. - 11' R.



579.

47

46

45

44

43

42

41

5/27/20

✓ +26 T.P. 24' L.  
+23 C. Fence 51' L.  
F. 31' L.



+28 P.P. 30' R.

✓ S.L. - 11' L.  
G.L. - 8' L.

+28 P.P. 10' R.  
S.L. - 16' R.  
G.L. - 13' R.

✓ +24 T.P. 25' L.

Cultivated field.

Hay field.

✓ +40 C. Fence 1st  
✓ +35 T.P. 25' L.



✓ F. 33' L.  
S.L. - 11' L.  
G.L. - 9' L.

S.L. - 13' R.  
G.L. - 10' R.

Swamp.

+20 P.P. 24' R.

✓ +28 T.P. 20' L.



✓ F. 33' L.

54

53

52

51

50

49

48

47

- ✓ +89 T.P. 33'L.
- ✓ +78 Nail Box 18'L.
- ✓ +74 " " "
- ✓ +73 " " "
- ✓ +19 I.R.S. Marker
- ✓ R. Direction 21'L.
- ✓ +13 F.P. 28'L.
- ✓ +19 G. Nail 20'L.
- ✓ +16 G. Nail 19'L.
- ✓ +10 G. Nail 15'L.
- ✓ +02 G. Nail 12'L.
- ✓ S.L.-15'L.
- ✓ G.L.-9'L.
- ✓ +97 F. Cor. 37'L.

- +68 Side Drain 30'R.
- 6" x 34" Vit. Fair Cond.
- +80 F. Cor. 50'R.
- +74 F. Cor. 41'R.
- +58 F. Cor. 42'R.
- +56 P.P. 37'R.
- +56 P.P. 27'R.
- +91 F. Ent.
- +13 Side Drain 34'R.
- 15" x 40" G.M. Good Cond.
- +23 G. Nail 23'R.
- +22 G. Nail 31'R.
- +18 G. Nail 14'R.
- +11 G. Nail 11'R.
- +03 G. Nail 10'R.
- S.L.-12'R.
- G.L.-8'R.

+32 Co. Re/E.

✓ +03 T.P. 28'L.

✓ F. 33'L.

✓ +46 T.P. 26'L.

✓ S.L.-11'L.

✓ G.L.-7'L.

✓ F. 33'L.

✓ +10 G. Nail 10'L.

✓ +03 Beginning

✓ of Guard Rail 12'L.

✓ +76 T.P. 26'L.

✓ +91 F. 35'L.

✓ F. 33'L.

Swamp

Hay Field

Timber

+88 P.P. 34'R.

+57 P.P. 34'R.

S.L.-15'R.

G.L.-10'R.

+75 G. Nail 12'R.

+68 Beginning

of Guard Rail 14'R.

+15 P.P. 32'R.

+78 F. Ent.



59

59

58

57

56

55

54

53

3/28/88

F. 28' L.  
S.L. - 19' L.  
D.L. 7' L.

F. 19' R.  
S.L. - 10' R.  
D.L. - 7' R.

✓ +47 T.P. 31' L.

+32 C.F. 18' R. ✓  
+15 P.P. 18' R. ✓

Swamp

Orchard

+97 C.F. 17' R. ✓

+47 P.P. 18' R. ✓

✓ +98 T.P. 27' L.

F. 19' R.

+91 Nail Box 12' L.  
✓ +65 F. Cor. 20' L.  
+53 F. Ent.  
✓ +30 Side Drain 15' L.  
12' x 42' C.M. Good Cond.

+27 P.P. 31' R. ✓  
+21 P.P. 22' R. ✓

+03 Nail Box 12' L.  
✓ +01 T.P. 45' L.

F. 25' R.

Cultivated Field

Farm Yard

✓ +14 T.P. 41' L.  
S.L. - 12' L.  
D.L. - 9' L.

S.L. - 13' R.  
D.L. - 8' R.  
+89 P.P. 35' R. ✓  
+80 P.P. 36' R. ✓

+03 F. Cor. 38' R. ✓

Sta.

65

64

63

62

61

60

59

3/28/25

✓ F. 30' L.  
✓ +95 T.P. 30' L.  
✓ +84 -12' T. -19' L.

F. 12' R.

✓ F. 31' L.

F. 14' R.  
+93 P.P. 20' R.

✓ +62 T.P. 21' L.

+44 F. 14' R.

✓ F. 33' L.

F. 17' R.

Pasture

✓ +59 F. 42' L.  
✓ +30 F. 19' L.  
S.L. -12' L.  
G.L. 9' L.  
✓ +92 F. Cor. 29' L.

+46 P.P. 19' R.

✓ +79 F. Cor. 29' L.  
✓ +75 F. Ent.

S.L. -12' R.  
G.L. 9' R.  
F. 21' R.

Pasture

Pat Hole

✓ +57 T.P. 31' L.  
✓ +42 C.F. 22' L.

+00 P.P. 30' R.  
F. 22' R.

Gate

✓ +03 T.P. 31' L.

+41 P.P. 19' R.  
+29 F. Ent.  
+14 C.F. 20' R.



549.

71

70

69

68

67

66

65

3/28/26

✓ +14 Cross Drain 83 L.

+94 P.P. 21 R. ✓  
 +81 Cross Drain  
 15' x 18' Vit. Good Cond.  
 Extends 31 R. & 97 L.

✓ F. 32' L.  
 ✓ S.L. - 13' L.  
 G.L. - 10' L.  
 ✓ +86 - 24' - T. - 28' L.

F. 22' R. ✓  
 S.L. - 13' R. ✓  
 G.L. - 10' R.

✓ +57 T.P. 31 L.

+49 P.P. 20 R. ✓

✓ F. 33' L.

F. 21 R. ✓

✓ +05 T.P. 30 L.  
 ✓ F. 31 L.

+52 F. Cor. 31 R. ✓  
 +45 F. Ent. ✓  
 +39 F. Cor. 21 R. ✓

+14 P.P. 20 R. ✓  
 F. 21 R. ✓

✓ +69 Cross Drain  
 18' x 40' Vit. Good Cond.  
 Extends 19' L. & 21 R.

Drains →

✓ S.L. - 10' L.  
 G.L. - 7' L.  
 ✓ F. 29' L.

S.L. - 11' R. ✓  
 G.L. - 9' R. ✓  
 F. 21 R. ✓  
 +92 P.P. 30 R. ✓

✓ +51 T.P. 32 L.

✓ +21 F. Cor. 31 L.  
 ✓ +07 F. Ent.  
 ✓ +02 F. Cor. 31 L.

Timber

+44 Cross Drain ✓  
 10' x 40' Vit. Good Cond.  
 Extends 19' L. & 21 R.  
 +47 C.F. 33 L.

Drains →

✓ S.L. - 14' L.  
 G.L. - 10' L.

+47 F. 21 R. ✓  
 +47 C.F. 15 R. ✓  
 +36 P.P. 20 R. ✓  
 S.L. - 12' R.  
 G.L. - 7 R.

Hay field

→ Drains  
 Cut Over land.

579

77

76

75

74

73

72

71



✓ F. 30' L.

F. 23' R. ✓

✓ +42 T.P. 29' L.

+71 P.P. 19' R. ✓

+31 C.F. 31' L.

S.L. - 11' L.

S.L. - 10' R.

G.L. - 8' L.

G.L. - 7' R.

✓ F. 30' L.

F. 23' R. ✓

✓ +40 C.F. 31' L.

✓ +48 T.P. 30' L.

+23 P.P. 19' R. ✓

+25 Nail Box 18' L.

✓ +43 F. Cor. 31' L.

✓ +93 F. Ent.

✓ +83 F. Cor. 31' L.

✓ S.L. - 15' L.

S.L. - 10' R.

G.L. - 11' L.

G.L. - 8' R.

✓ F. 31' L.

F. 22' R. ✓

✓ +30 T.P. 31' L.

+27 P.P. 20' R. ✓

✓ F. 32' L.

F. 23' R. ✓

✓ +78 C. Fence 32' L.

✓ +73 F. Ent.

✓ +67 C. Fence 33' L.

+32 P.P. 19' R. ✓

S.L. - 13' L.

S.L. - 12' R.

G.L. - 10' L.

G.L. - 8' R.

F. 32' L.

+98 F. Cor. 22' R. ✓

+98 F. Ent. ✓

+80 F.P. 21' R. ✓

+79 F. Cor. 22' R. ✓

✓ +62 T.P. 31' L.

orchard

cultivated field



54.

83

82

81

80

79

78

77



54a.

89

88

87

86

85

84

83

3/31/25

✓ S.L. - 12' L.  
C.L. - 6' L.  
✓ F. 27 L.

S. L. - 12, 'P.  
G. L. - 7, 'P.

✓ +91-15"-T.-31 L.  
✓ +80-6"-T.-29 L.  
✓ +66-12"-T.-32 L.  
✓ +46-14"-T.-30 L.  
✓ +37-6"-T.-28 L.  
✓ +21-10"-T.-28 L.  
F. 27 L.  
✓ +96-6"-T.-29 L.  
✓ +85-6"-T.-28 L.  
✓ +77-T. 10 22 L.  
✓ +74-6"-T.-27 L.  
✓ +58-12"-T.-31 L.  
✓ +35-8"-T.-28 L.  
✓ +13-6"-T.-28 L.  
✓ +1-10"-T.-28 L.  
✓ 5 L.-10 L.  
✓ 4 L.-6 L.  
✓ 15 26 L.

pasture.

✓ 71-8° T-26' L. ✓  
✓ 155-8° T-25' L. ✓  
✓ 126 T.P. 23' L.  
✓ F. 26' L.

- ✓ +30 F. Cor. 26 L.
- ✓ +25 F. Int.
- ✓ +19 F. Cor. 25 L.
- ✓ 101-6, -7, -11 L.
- ✓ F. 26 L.

- ✓ +61 T.P. 26 ft.
- ✓ +60 C.F. 27 L.
- ✓ +34 F.C. 27 ft.
- ✓ +25 F. Ent.
- ✓ +15 F. Cap. 28 ft.
- ✓ S.L. - 13 L.
- C.L. - 7 ft.
- ✓ F. 27 ft.

Farm  
Varej.

cultivated field.

S.L-12'R  
G.L-7'X

S. L. - 11 R.  
C. L. - 6 R.



Sta.

95

94

93

92

91

90

89

3/31/25

S.L. - 14' L.

G.L. - 8' L.

F. 32' L.

✓ +98 - 15' - T. - 32' L.

S.L. - 13' R.

G.L. - 6' R.

Cultivated field

F. 33' L.

✓ +91 T.P. 28' L.

Pasture

✓ +65 - 12' - T. - 31' L.

✓ +48 - 10' - T. - 31' L.

✓ +16 12' - T. - 30' L.

F. 32' L.

+48 T.P. 28' L. ✓

+20 Nail Box 12' L.

+18 " " 12' L.

S.L. - 13' L.

G.L. - 8' L.

+58 Rd.

S.L. - 10' R.

G.L. - 7' R.

✓ +78 F. Cor. 32' L.

✓ +72 F. Ent.

✓ +66 F. Cor. 31' L.

✓ +24 O.P. 31' L.

✓ +19 - 10' - T. - 33' L.

✓ F. 29' L.

✓ +89 T.P. 27' L.

✓ +81 - 10' - T. - 32' L.

✓ +62 - 10' - T. - 33' L.

✓ +50 - 12' - T. - 33' L.

✓ +25 - 10' - T. - 31' L.

✓ +20 - 12' - T. - 32' L.

✓ +07 - 8' - T. - 28' L.

✓ F. 28' L.

✓ +90 - 8' - T. - 33' L. ✓

✓ +79 - 8' - T. - 32' L.

✓ +63 - 12' - T. - 30' L.

✓ +50 - 6' - T. - 30' L.

✓ +40 O.P. 28' L.

✓ +35 T.P. 24' L.

✓ +17 - 10' - T. - 30' L.

✓ +04 - 12' - T. - 31' L.

Cultivated field

Cultivated field

101

100

99

98

97

96

95

✓ F. 28' L.

✓ +30 T.P. 23' L.

✓ S.L. - 11' L.

✓ G.L. - 6' L.

✓ F. 27' L.

Woods

Brush

S.L. - 12' R.

G.L. - 7' R.

✓ F. 28' L.

Spring

✓ +67 T.P. 24' L.

✓ F. 31' L.

Pasture

Cultivated Field

✓ +89 Cross Drain  
12" x 34" C.M. Box Crd.  
Extends 19' L. 8' 15" W.

✓ S.L. - 15' L.

✓ G.L. - 6' L.

✓ +102 T.P. - 18' L.

✓ F. 33' L.

✓ +79 6" T. - 11' L.

S.L. - 11' R.

G.L. - 7' R.

✓ +86 F. ENT.

✓ F. 33' L.

✓ +55 18" T. - 30' L.

✓ +40 T.P. 28' L.



Sta.

107

104

105

104

103

102

101

3/3/23

✓ S.L. - 10' L.  
G.L. - 6' R.

✓ S.L. - 12' R.  
G.L. - 6' R.  
+80 T.P. 25' R.

✓ F. 20' L.

✓ F. 20' L.

✓ +65 24" T. - 22' L.  
✓ +58 F. 20' L.

✓ +35 - 36" T. - 27' L.

✓ F. 20' L.

✓ +68 T.P. 20' L.

✓ S.L. - 14' L.  
✓ G.L. - 6' L.  
✓ F. 26' L.

✓ +40 T.P. 20' L.

✓ F. 15' L.

✓ S.L. - 14' L.  
✓ G.L. - 6' L.  
✓ F. 27' L.  
✓ +89 T.P. 21' L.

Stumps

Woods

Brush

Cultivated field

Drains

+94 Cross drain  
12" x 46' C.N. Good Cond.  
Extends 24' L. & 24' R.

✓ S.L. - 14' R.  
G.L. - 6' R.

✓ S.L. - 14' R.  
G.L. - 6' R.

579

113

112

111

110

109

108

107

3/31/25

✓ S.L. - 11' L.  
G.L. - 7' L.

S.L. - 11' R.  
G.L. - 7' R.


✓ 100 F Ent.

131 T.P. 79' R.

✓ S.L. 12' L.  
G.L. 8' L.

S.L. - 12' R.  
G.L. 8' R.

✓ 188 Cross Drain  
12" X 47' C.M. Good Cond.  
Extends 16' 8" R.

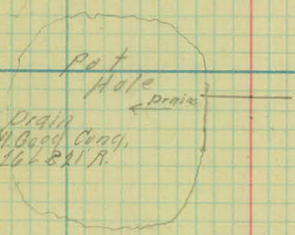

166 T.P. 79' R.

Cultivated field.


Cultivated field.

✓ S.L. - 12' L.  
G.L. - 6' L.

129 T.P. 79' R.

S.L. - 12' R.  
G.L. - 6' R.

✓ 166 Cross Drain  
12" X 30' C.M. Good Cond.  
Extends 172' 8" R.

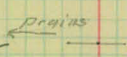

162 T.P. 57' R.



Sta.

117

118

117

114

115

114

113

3/21/25

S.L. - 11' R.  
C.L. - 6' L.

Cultivated field

S.L. - 12' L.  
C.L. - 7' L.

✓ 112 Cross Drain  
12" x 48" C.M. Good Cont.  
Extends 21' L.B. 19' R.

← Drains

Cultivated field

F. 55' R.  
S.L. - 11' R.  
C.L. - 7' R.

Pasture

S.L. - 11' R.  
C.L. - 7' R.

182 F. Cor. 65' R. ✓

Cultivated field

Sta.

125

124

123

122

121

120

119

3/31/25

✓ S.L. 13' L.  
G.L. 7' L.

S.L. 11' R.  
G.L. 6' R.  
F. 43' R.

+75 F. 57' L.

Cultivated field

pasture

✓ S.L. 11' L.  
G.L. 7' L.

S.L. 11' R.  
G.L. 7' R.  
F. 48' R.

F. 55' R.



574

131

130

129

128

127

126

125

3/31/25

S.L. - 11' R.  
G.L. - 6' R.

S.L. - 11' R.  
G.L. - 2' R.  
F. 29' R.

Cultivated  
field

Woods

F. 30' R.

✓ +18 F. Cor. 24' L.

F. 32' R.

S.L. - 18' L.  
✓ G.L. - 7' L.  
F. 26' L.

S.L. - 12' R.  
G.L. - 2' R.  
F. 36' R.

Swamp

✓ F. 44' L.

Swamp

✓ F. 24' L.

F. 38' R.

+08 F. Cor. 19' L.

579.

137

136

135

134

133

132

131

3/31/73

S.L. 11' L.  
B.L. - 7' L.

✓

S.L. - 12' R.  
B.L. - 7' R.  
F. 47' R.

✓

Cultivated field.

S.L. - 12' L.  
B.L. - 7' L.


✓

S.L. - 12' R.  
B.L. - 7' R.  
F. 56' R.

✓

Woods

Woods

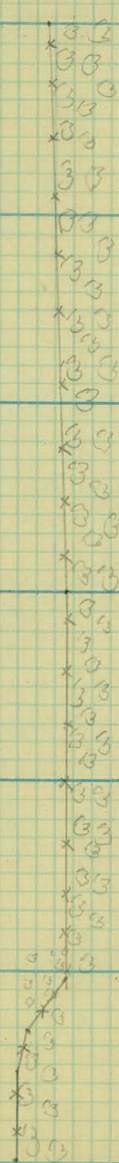

F. 55' R.

✓

F. 35' R.

✓

F. 30' R.

✓



5 + a.

143

142

141

140

139

138

137



579.

149

148

147

146

145

144

143

4/2/26

✓ F. 29' L.

Woods

Cultivated field

✓ S.L. 11' L.  
G.L. 6' L.

✓ +24 F. Ent.  
+14 Side drain 17' R.  
12" X 20" C.M. Good Cond

S.L. 11' R.  
G.L. 6' R.

Farm  
yard

✓ +38 F. Cor. 29' L.

✓ +15 F. 29' L.

✓ +77 F. 39' L.

✓ +42 F. Cor. 22' L.

✓ S.L. 13' L.  
G.L. 8' L.

S.L. 15' R.  
G.L. 7' R.

Lake

Island

Lake



54.

155

154

153

152

151

150

149

4/2/20

S.L. - 11 1/2"  
Cub. - 7 1/2"

Feb. 7<sup>th</sup>

cultivated fields.

Pot  
Hole.

5.2 - 12 R  
6.1 7 R



✓ 462 F. Cor. 52 L.

#70 F. 25 L.

Scrub. Oak

724 F. Cor. 42<sup>nd</sup> St.

+90 F. 32 R.

464 FCor. 34 R

549.

161

160

159

158

157

156

155







579.

167

166

165

164

163

162

161

4/2/20

Uncultivated field

woods

S.L. - 11' L.  
G.L. - 7' L.

S.L. - 11' R.  
G.L. - 7' R.

75 Gross Drain  
15" X 40 G.M. Good Cond.  
Entongs 10' X 8' 20' H.  
Balancer.

Lake

Lake

Sta.

172

171

170

169

168

167

4/2/20


S. T. H # 62

RICE CREEK TOWNSHIP

174 Cross Prain  
12 x 32 C.M. Coal Comp.  
Extends 15 L. & 17 R.

S.L. - 11 1/2  
G.L. - 7 1/2


Uncultivated field

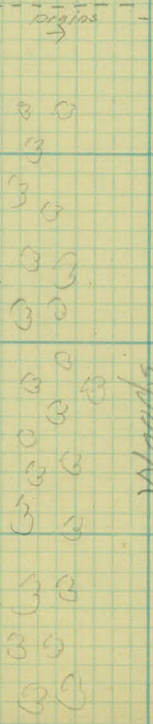

S.L. - 11 1/2  
G.L. - 7 1/2

Woods



 

# Fairchild Avenue Survey

Sec. 31-30-23

7° 51'

52 + 32

(1)

COUNTY ROAD 5

E.P.

E.P.

P.P.

"E"

48210

57.80°

E.P.

2.627.41

FAIRCHILD AVE

2 B Tree

43.4 0 Tree

Guy Pole

42.77

P.P. 0

46.0

0.2872

2.141


8.6251-5

11

56


41

27

 


Fairchild Ave. -

Sec. 30-30-23

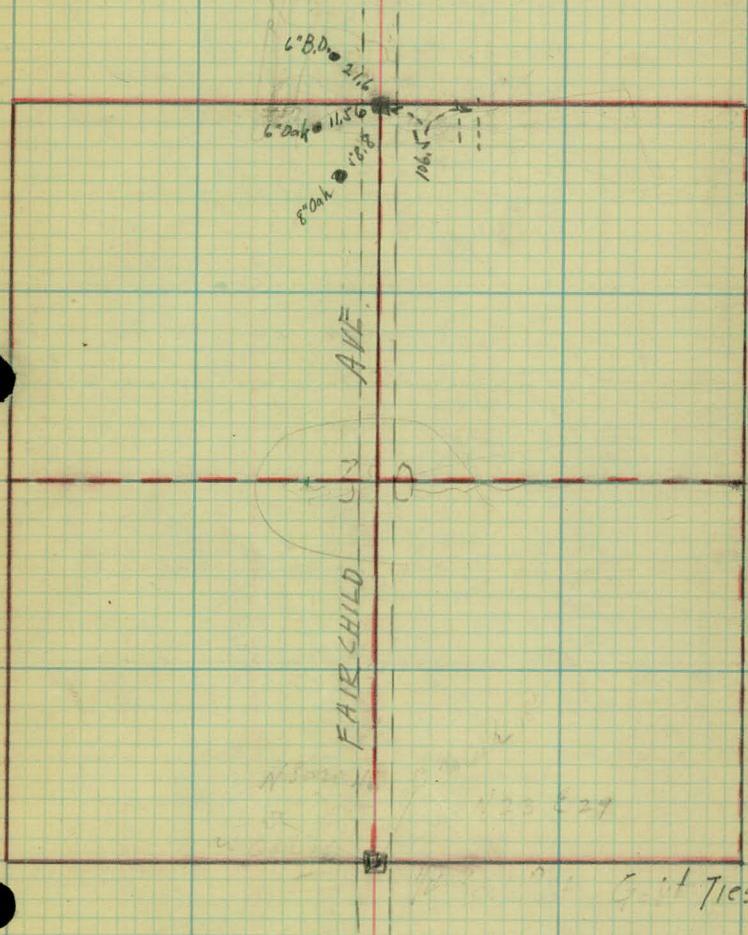



 

③


# Fairchild Ave Survey

Sec 19-30-23.

14" B.O.  
220  
6" Oak. 44.45 35 1/2 B.O. 4"

5" Oak  
51.3  
54.3  
8" Oak.

6" B.O.  
21.6  
300  
416.9  
3" Oak.  
1156  
588  
106.5  
6" Oak.  
8" Oak.

 



# FAIRCHILD AVE SURVEY

SEC 18-30-23.

Pice River

BO 8"

12575

BO 12"

107.16

1315.2

Pice Creek Road

14" BO. 6220

4445

6" Oak.

35/203



